
OLD TOWN
PARKING DISTRICT
PARKING LOTS #9 AND #10

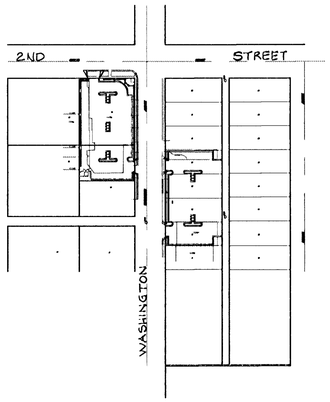

SRB

INDEX OF SHEETS

1. TITLE SHEET
2. GENERAL NOTES & DETAILS
3. TYPICAL SECTIONS
4. SCREEN WALL DETAILS
5. PLAN – LOT #9
6. PLAN – LOT #10
7–10. LIGHTING PLANS & DETAILS
11–12. LANDSCAPE PLANS & DETAILS
13–14. IRRIGATION PLANS & DETAILS (NOT INCLUDED)

THOMAS CHARLES RUGGLES
LICENSED
8031
12-18-94
KANSAS
PROFESSIONAL ENGINEER

CITY OF WICHITA, KANSAS
MICHAEL E. LINDEBAK - CITY ENGINEER

RECORD COPY REVISED 7-11-94

SRB 841 SOUTH HILLSIDE WICHITA, KANSAS 67211 316-652-7754 FAX 652-7932
SAVOY, RUGGLES & BOHM, P.A.
ENGINEERING & SURVEYING