BENCH MARK #1: "□" cut on top of curb
50.4' N. of N.W. corner of Lot 17 on Washington,
Mathewson's 2nd Addition Elev. 109.65

SRB

SCALE: 1" = 20'

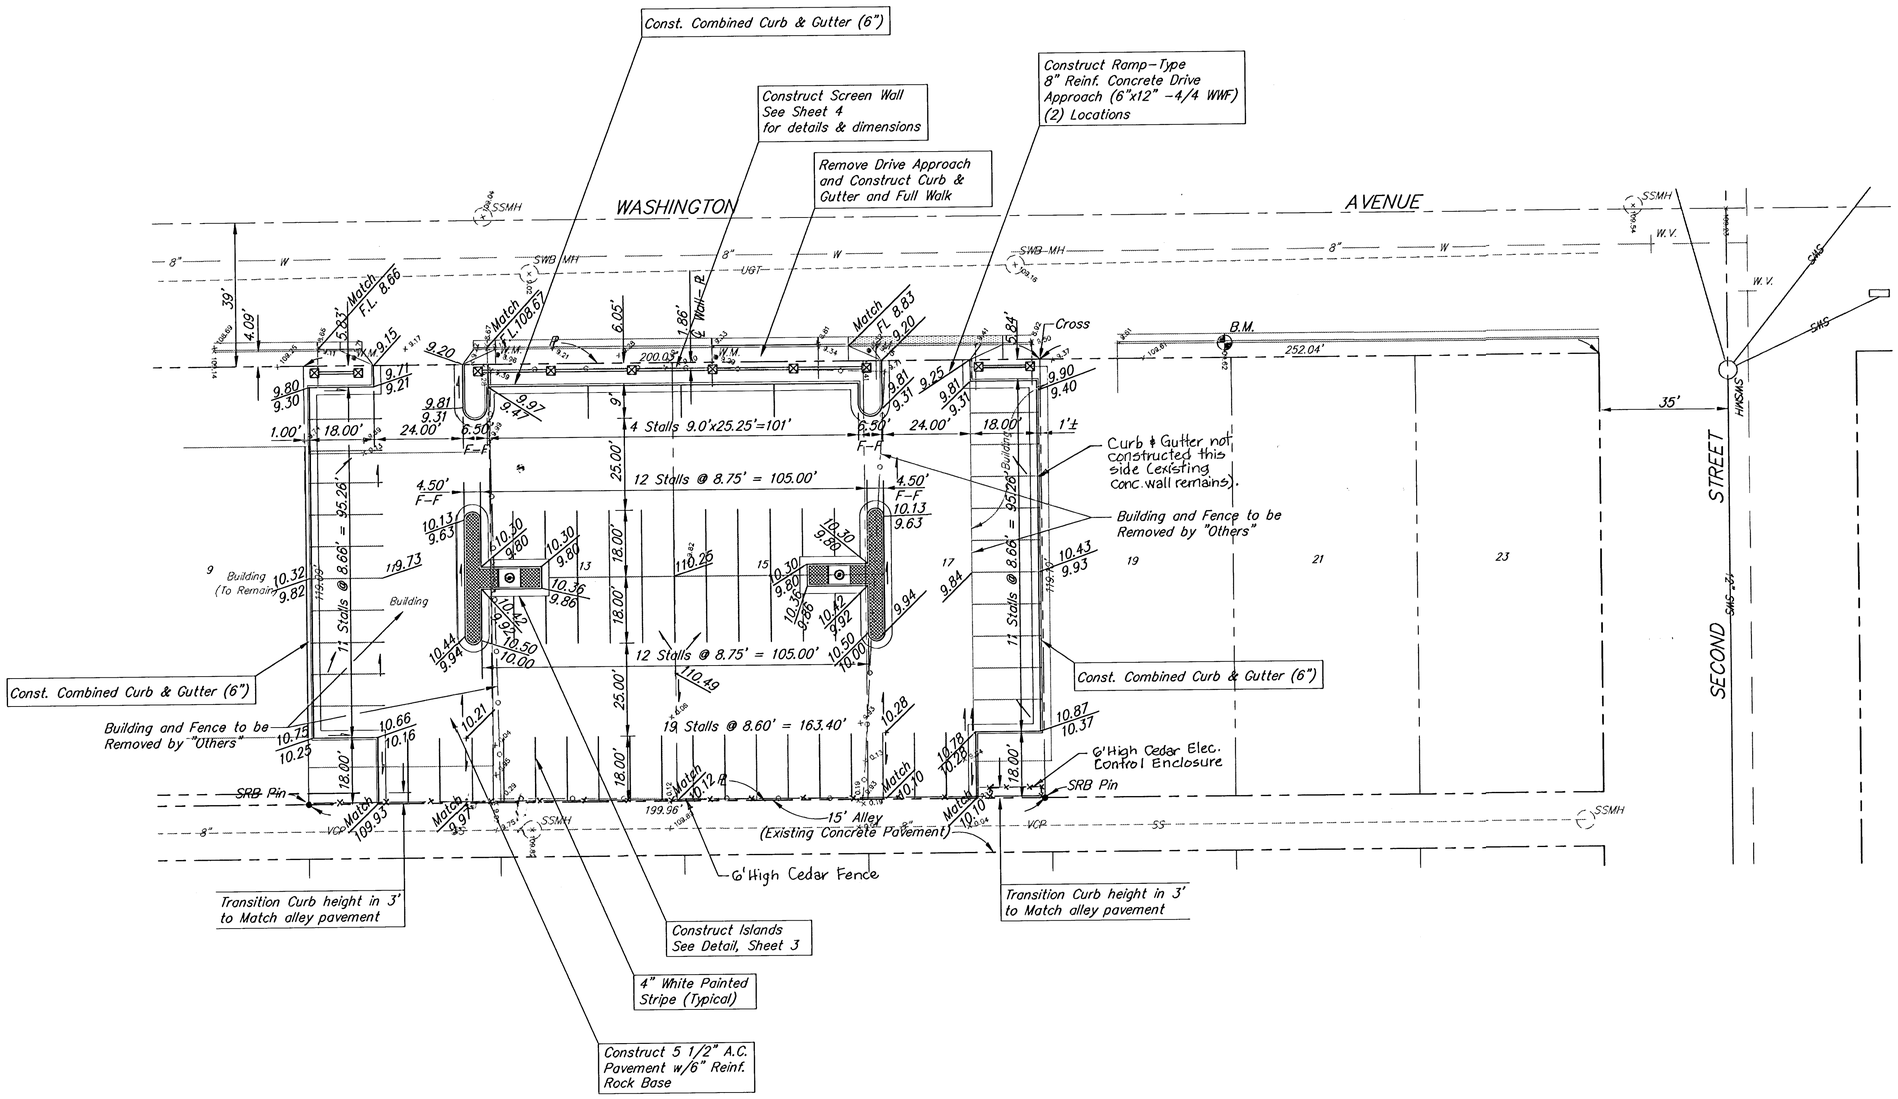

NOTE:
Dimensions are to face of curb except where noted otherwise.

LEGAL DESCRIPTION:
Lots 11, 13,15, and 17, Washington Avenue, in Mathewson's 2nd Addition to the City of Wichita, Sedgwick County, Kansas, except the West nine (9) feet thereof.

REVISED 7-11-94
RECORD COPY

SITE PLAN – PARKING LOT #9
OLD TOWN PARKING DISTRICT

SRB 841 SOUTH HILLSIDE WICHITA, KANSAS 67211 316-652-7754 FAX 652-7932
SAVOY, RUGGLES & BOHM, P.A.
ENGINEERING & SURVEYING

PROJECT NUMBER

DRAWN	DESIGN	REVIEW	DATE	UTILITY	SRB JOB
T. Brooks	T. Ruggles		2-23-94		101E

REVISED

DWG. FILE 101E\P2

5
14

C:\ACADDTV11\P\101E\P2 Wed Feb 23 09:41:26 1994