
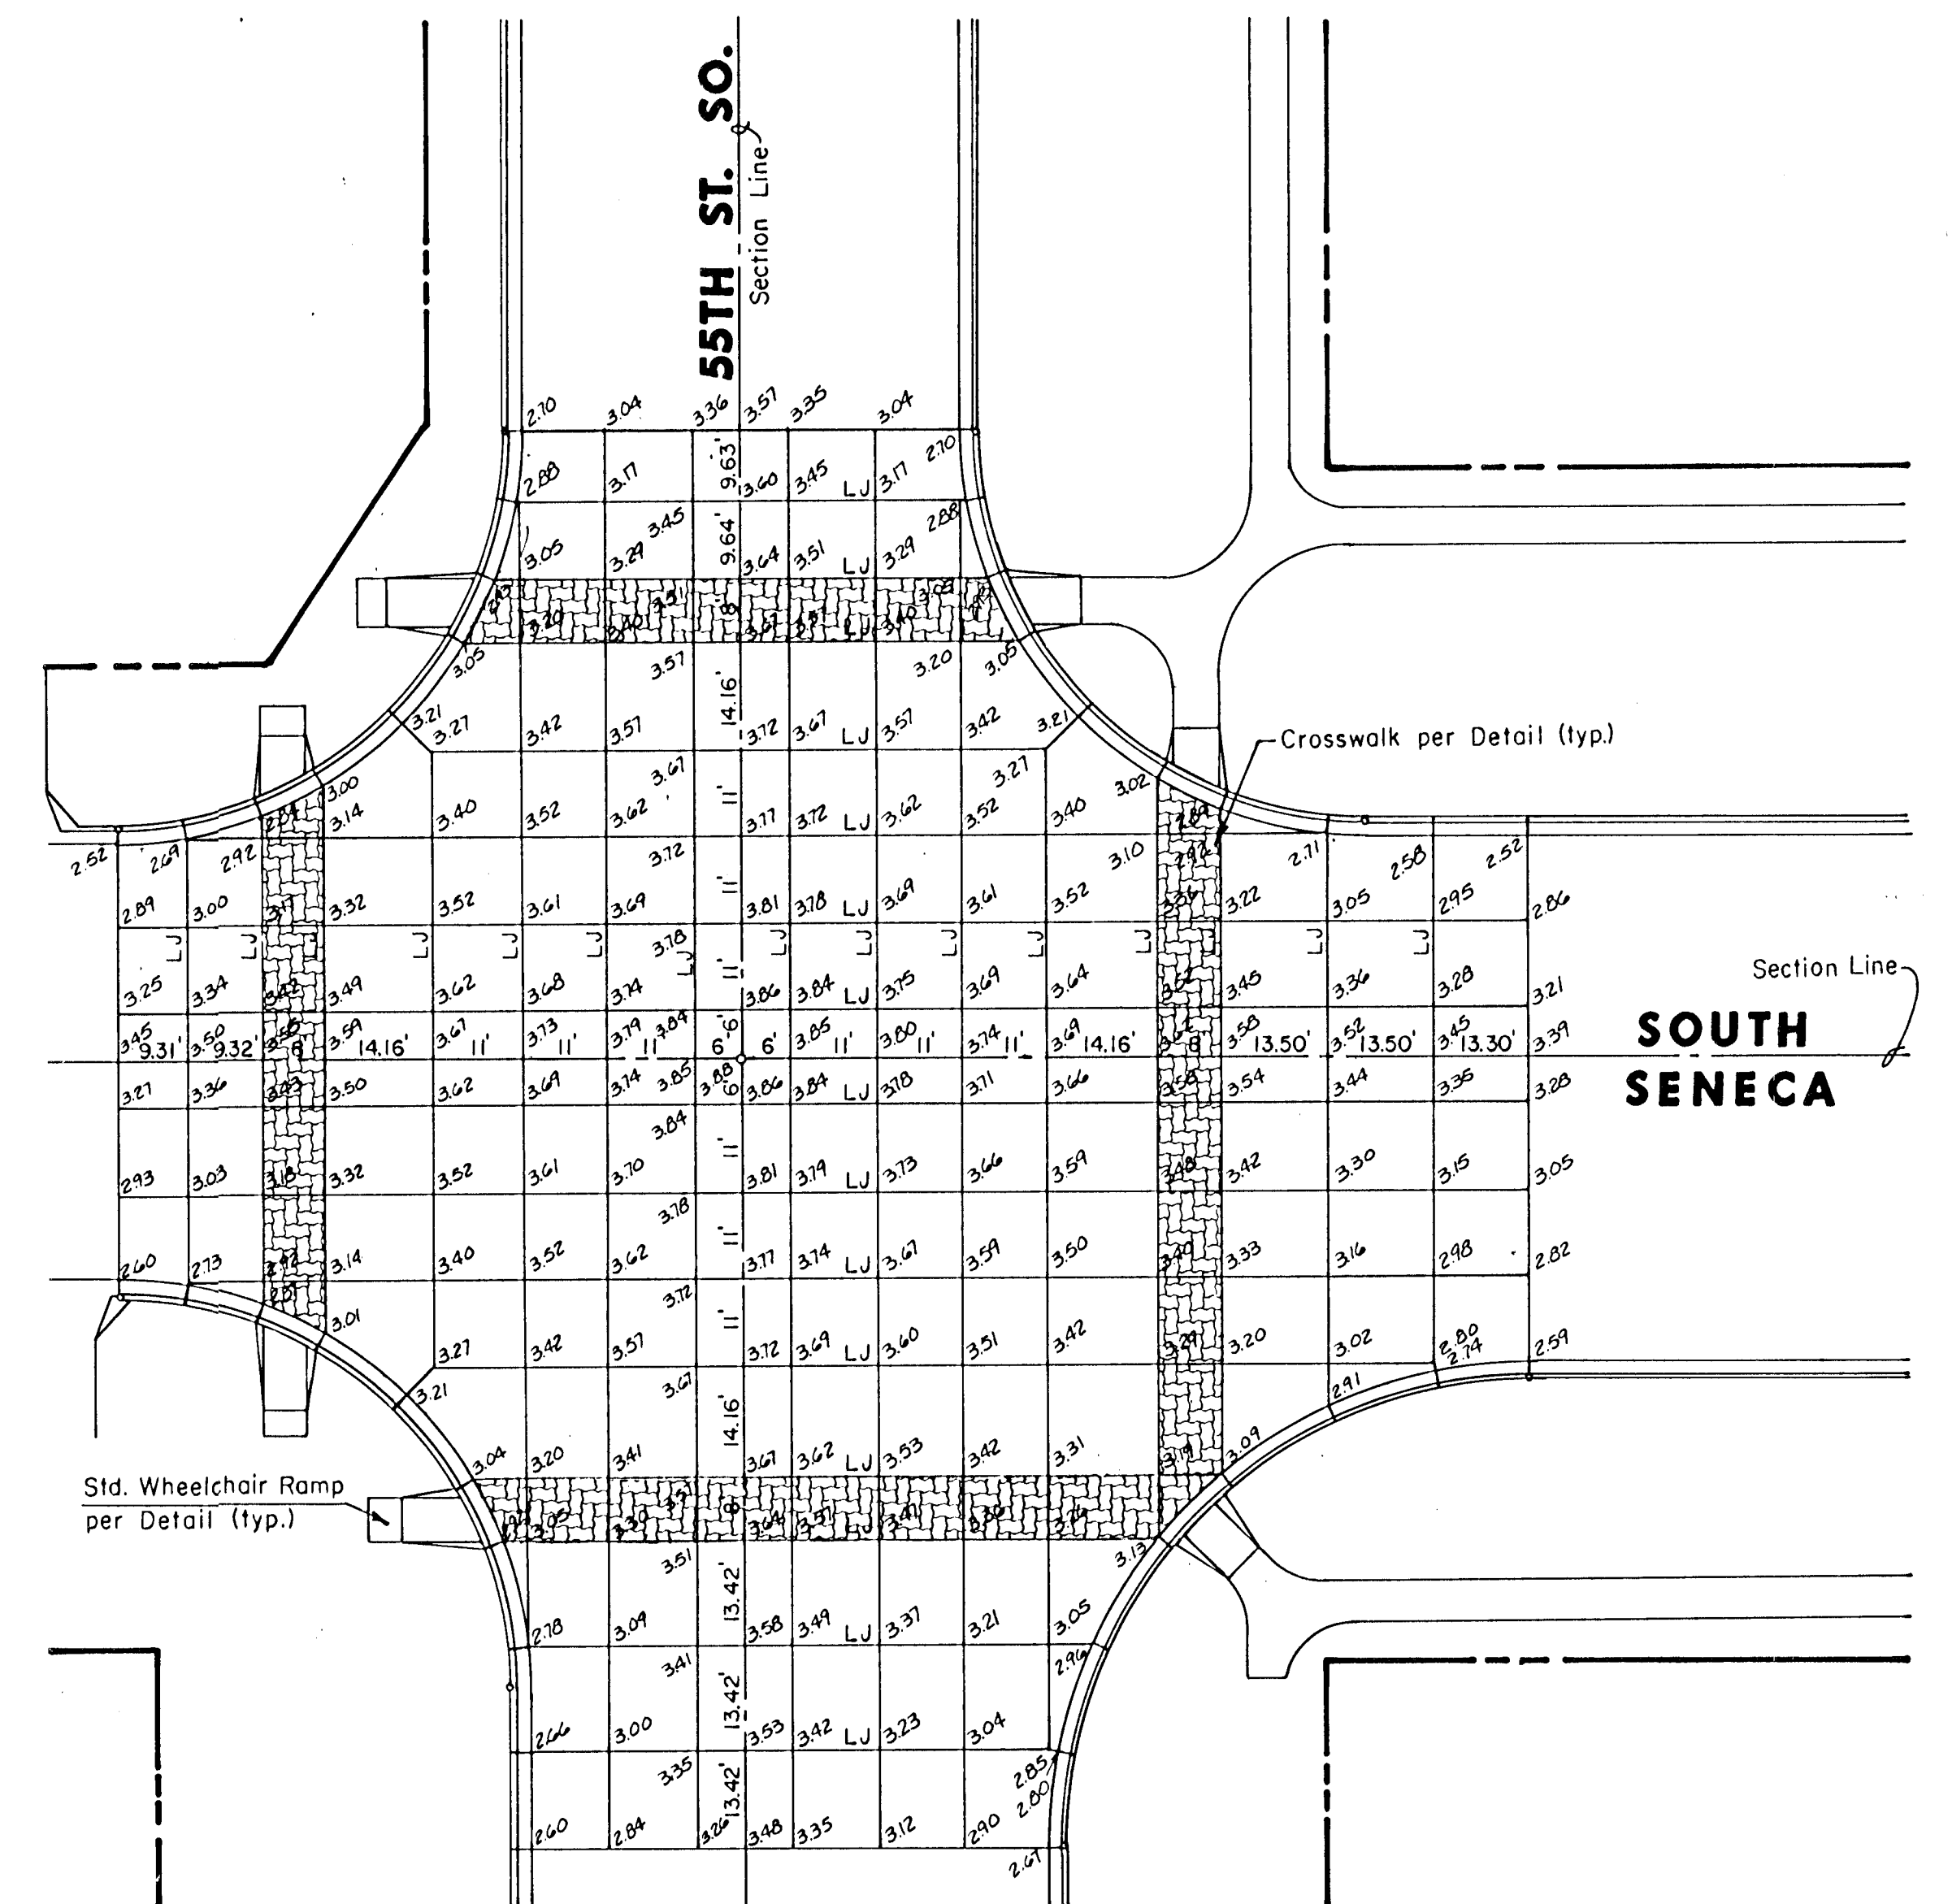
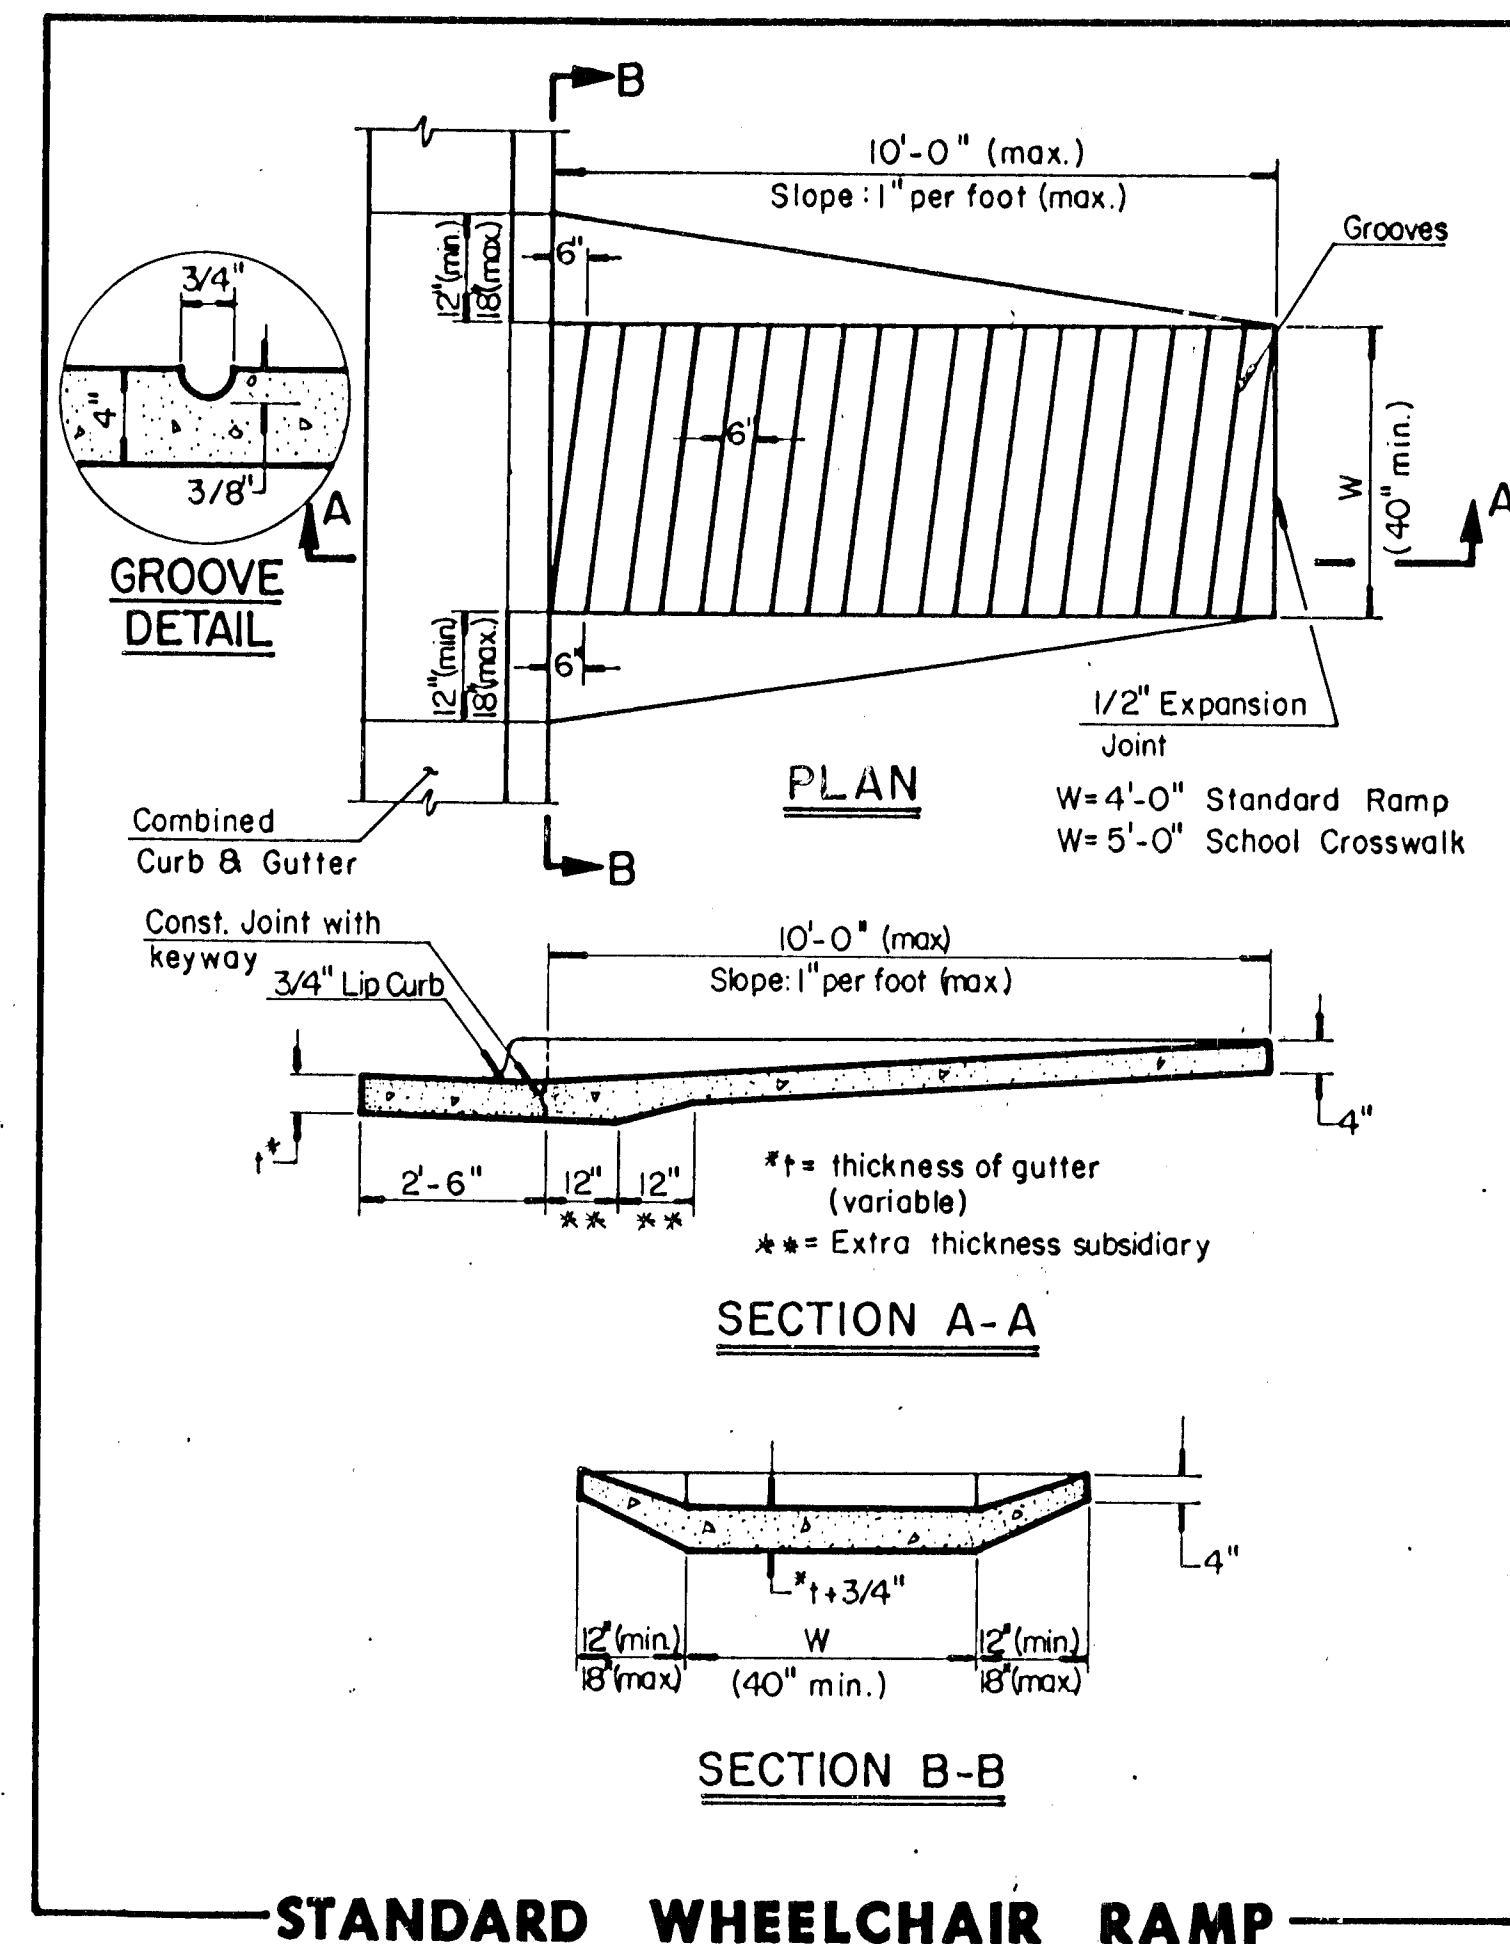


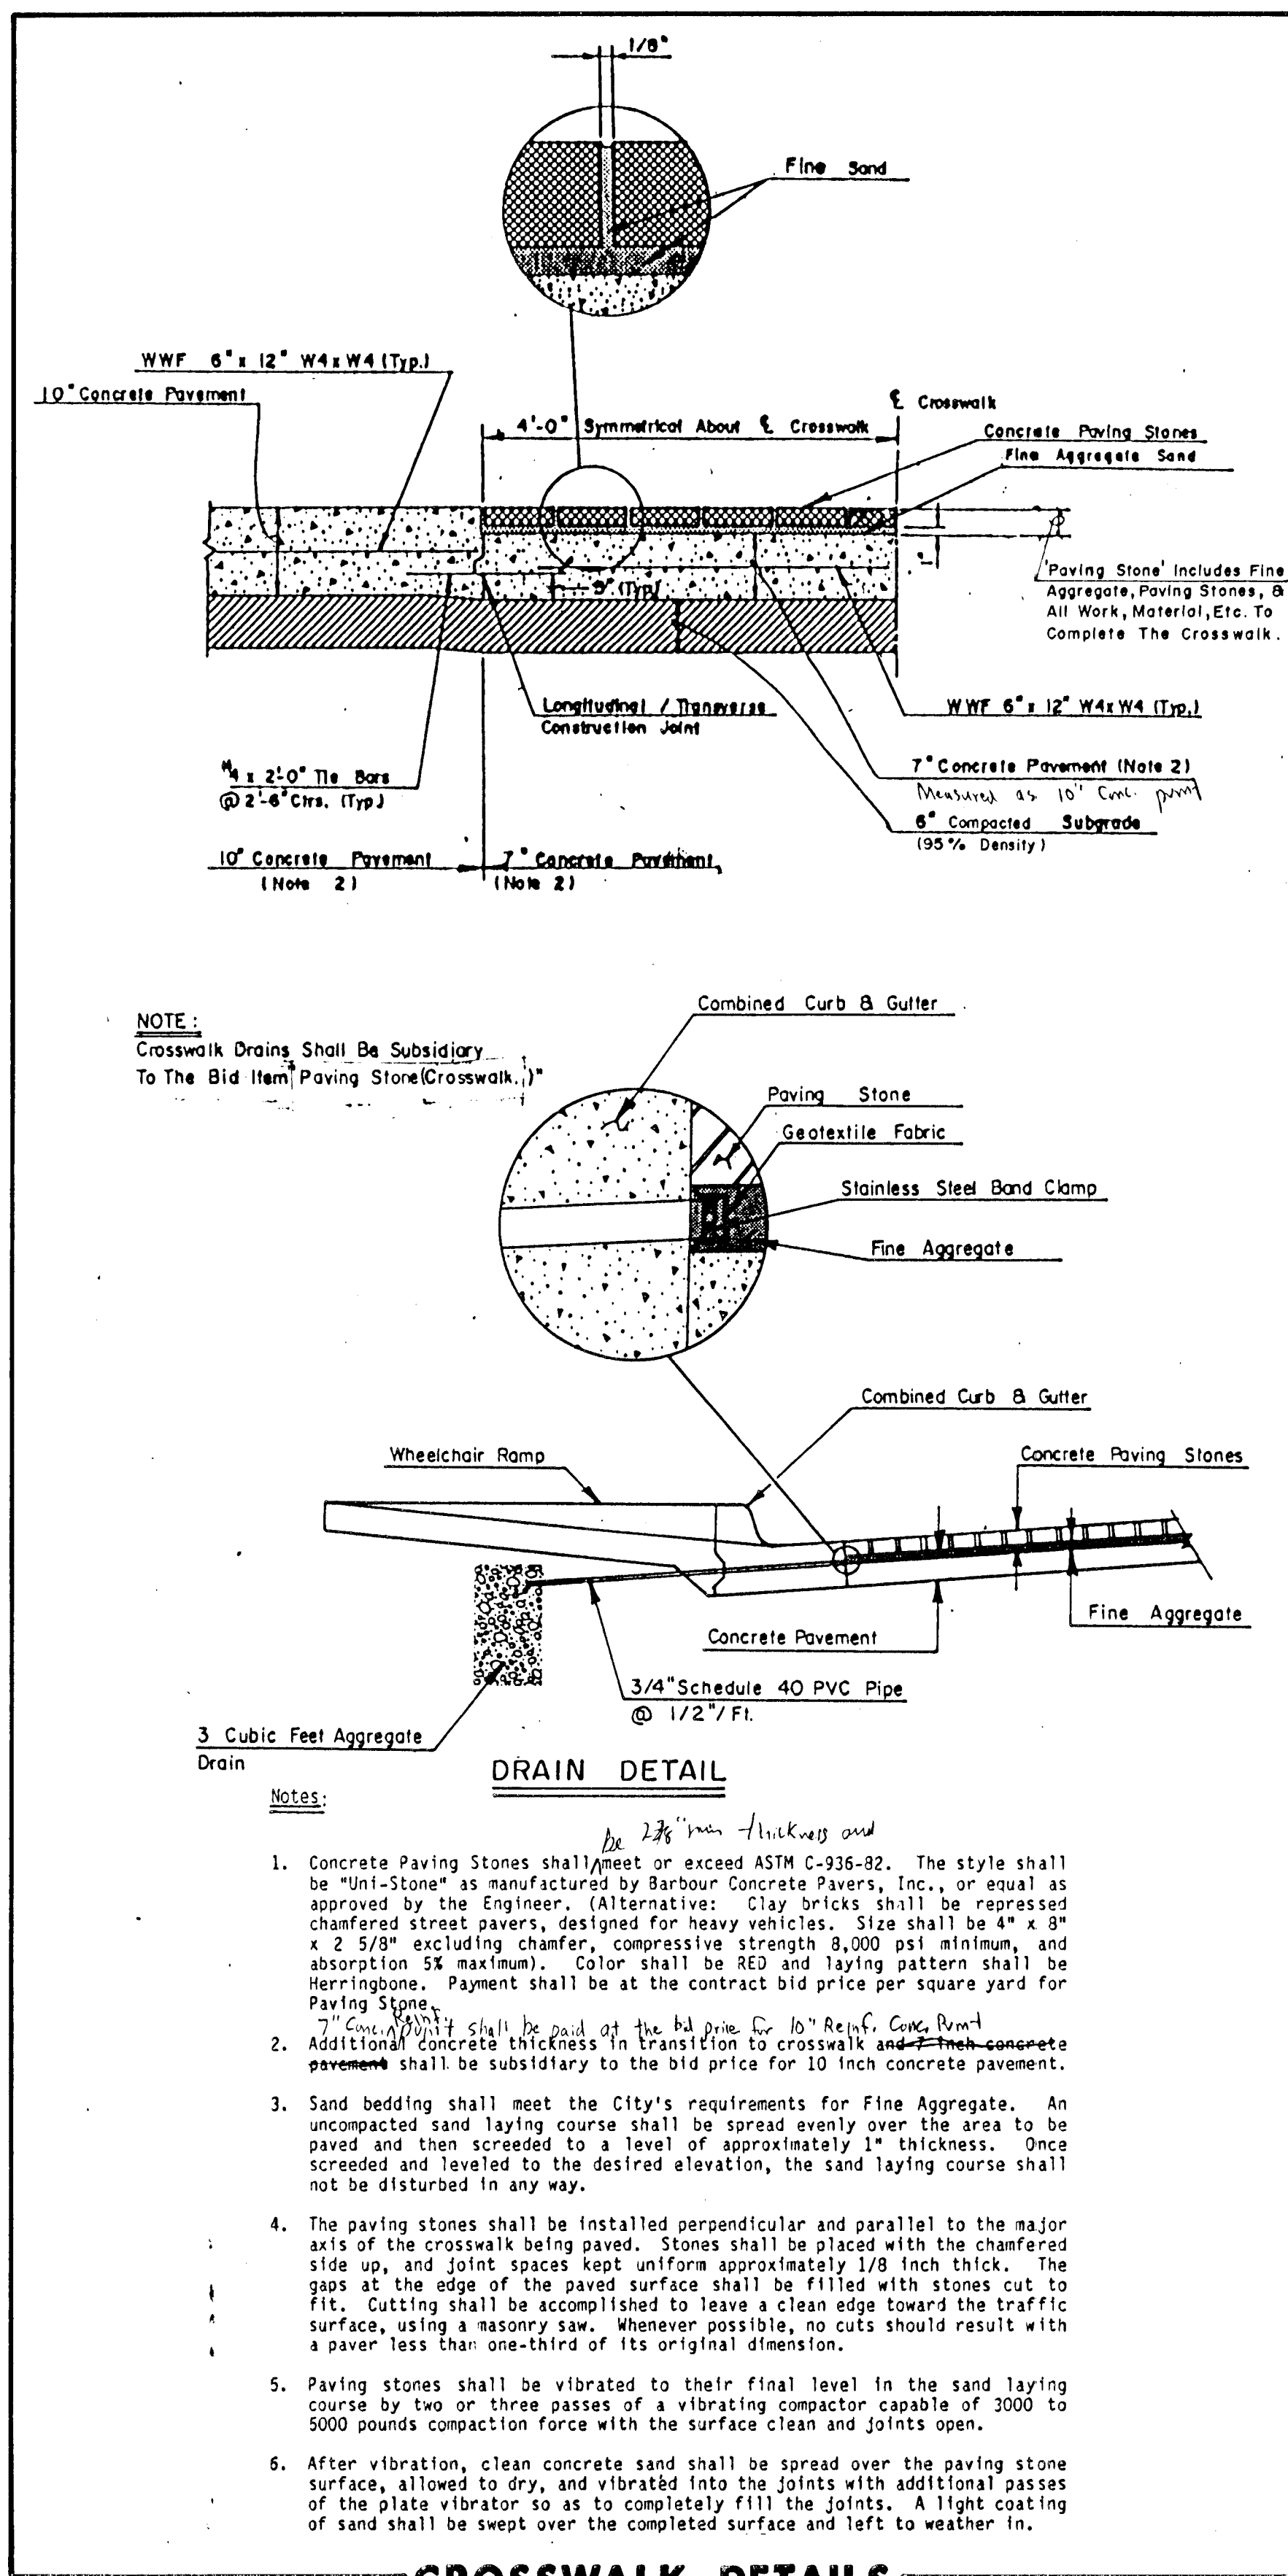

- See Sheet 2 for Joint Details.
- Curb Elevations shown are High Edge.

SCALE: 1" = 20'

	SOUTH SENECA IMPROVEMENTS		Design
	INTERSECTION DETAILS		Drawn by
			Checked by
			Date
			Job no.
MID-KANSAS ENGINEERING CONSULTANTS PA 3500 NORTH ROCK ROAD BUILDING #800 WICHITA, KANSAS 67226			Sheet 4 of 58