
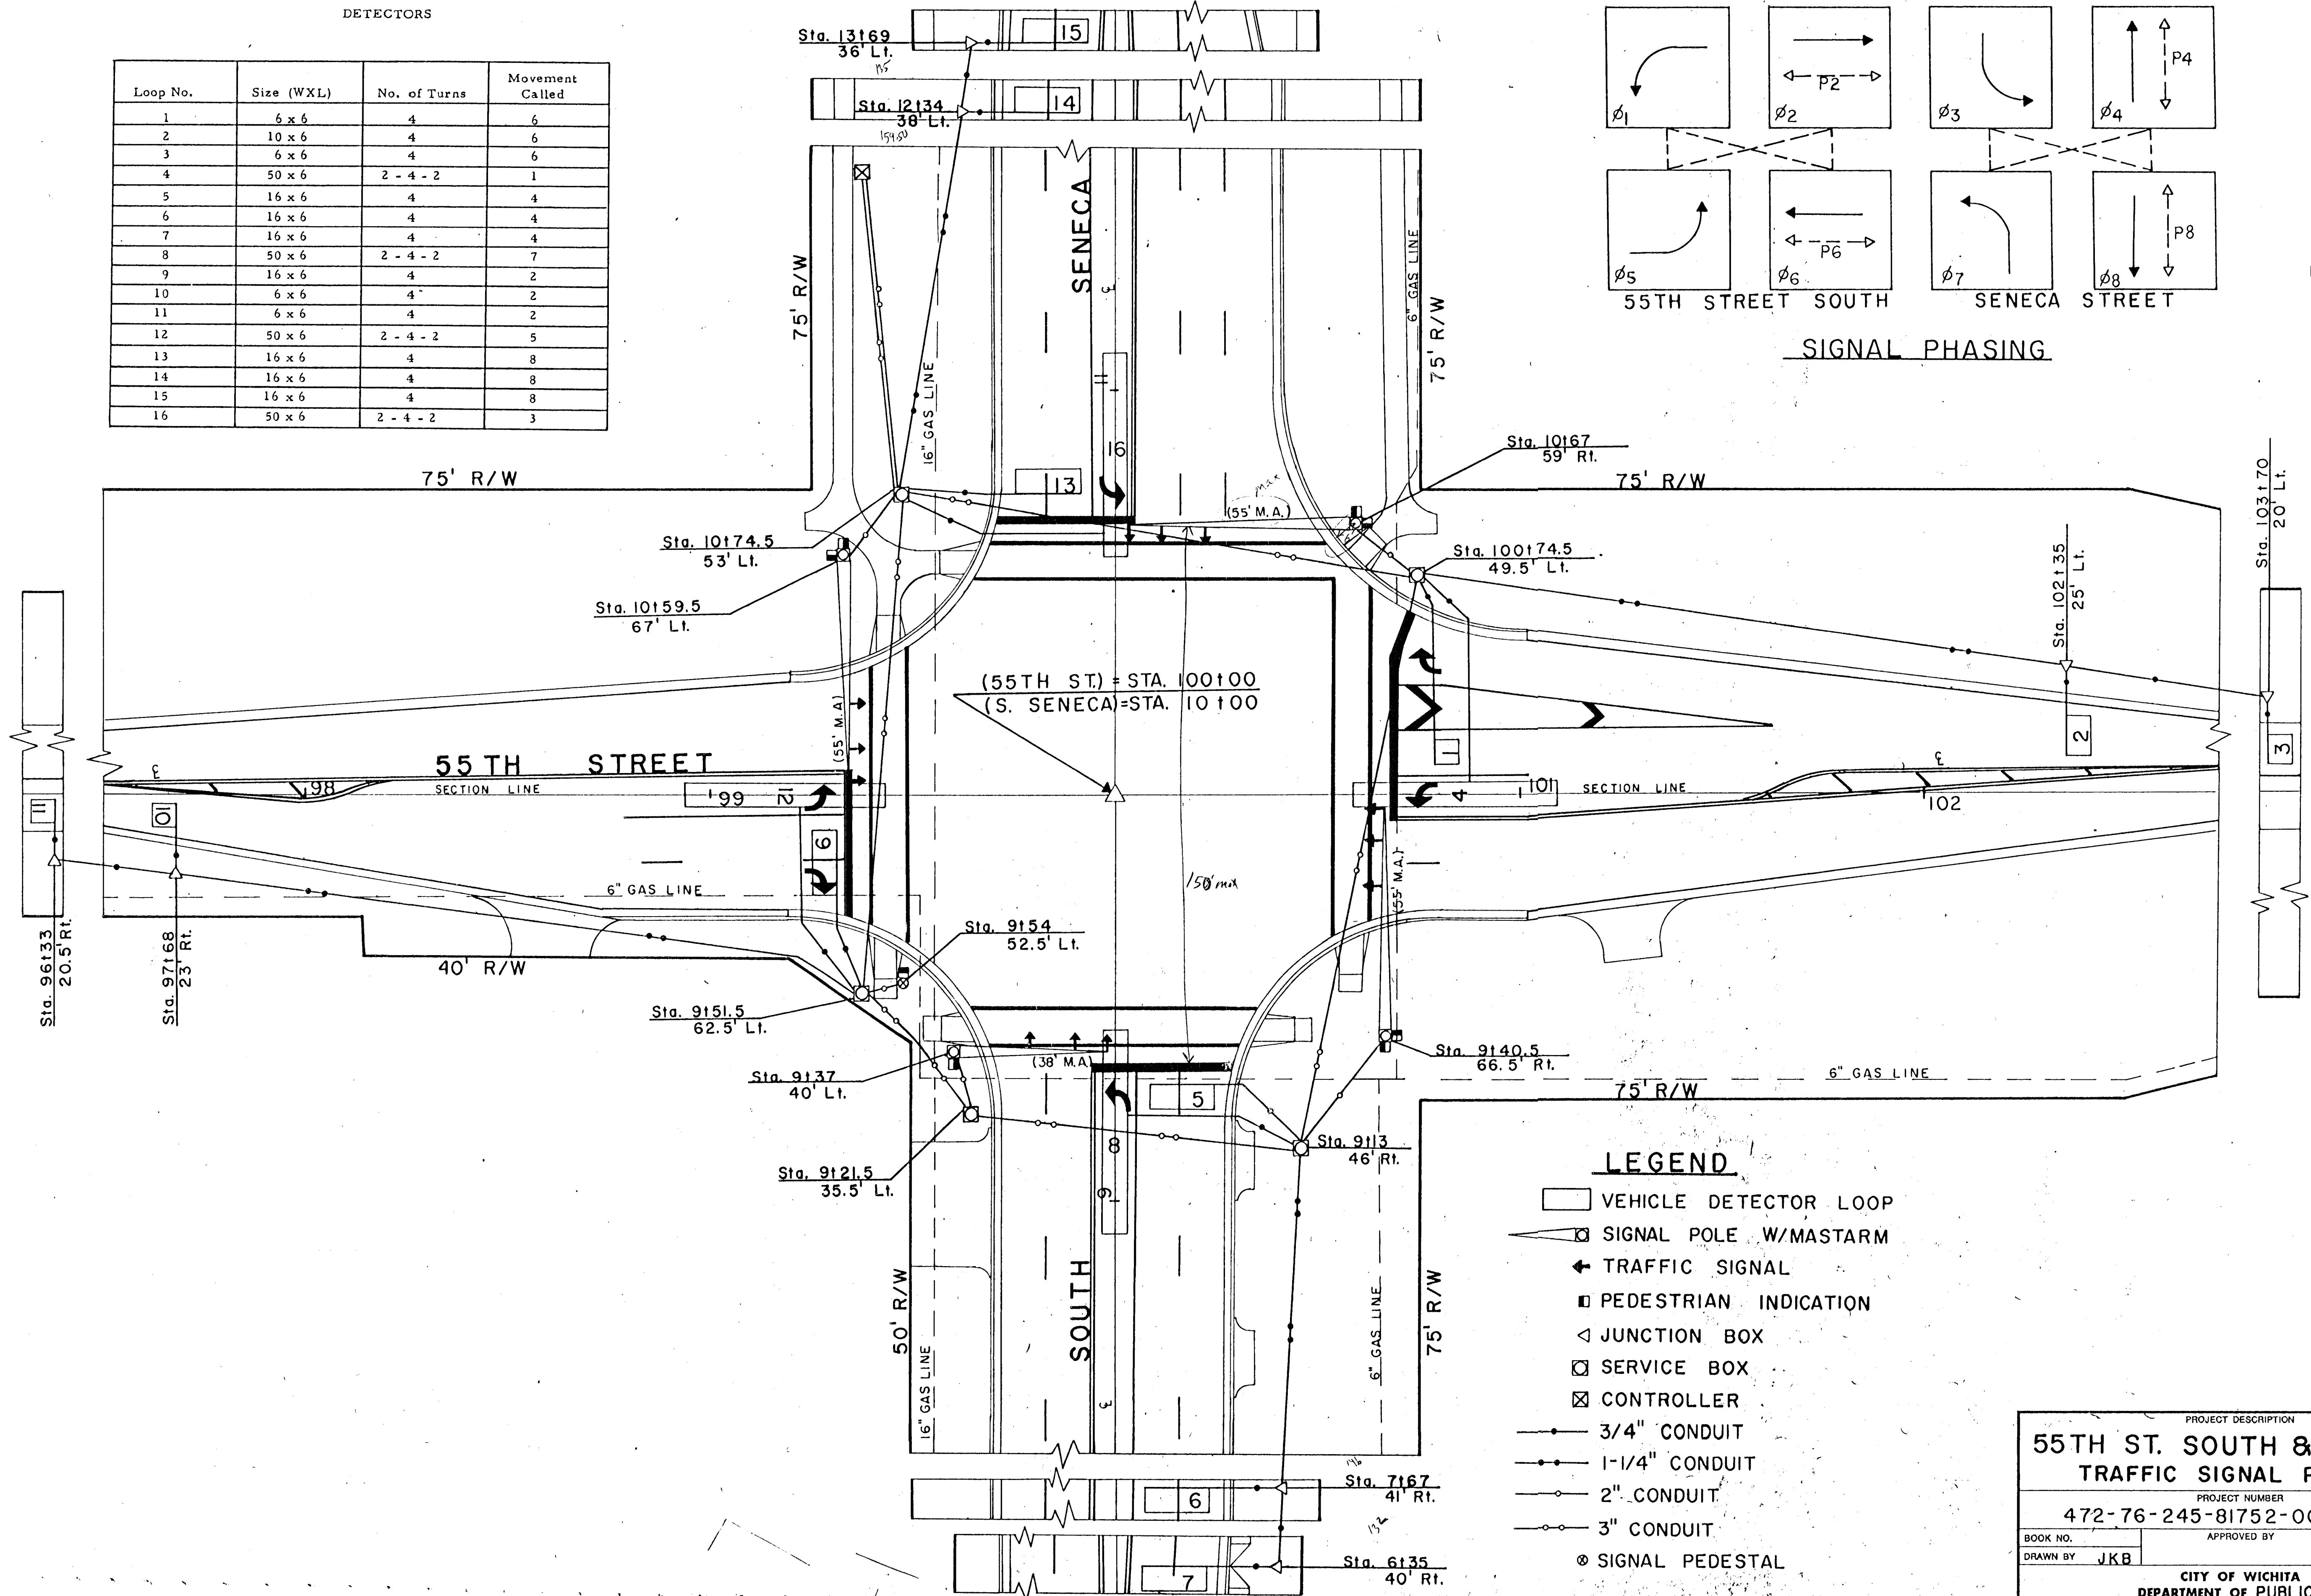


DETECTORS

| Loop No. | Size (WXL) | No. of Turns | Movement Called |
|----------|------------|--------------|-----------------|
| 1        | 6 x 6      | 4            | 6               |
| 2        | 10 x 6     | 4            | 6               |
| 3        | 6 x 6      | 4            | 6               |
| 4        | 50 x 6     | 2 - 4 - 2    | 1               |
| 5        | 16 x 6     | 4            | 4               |
| 6        | 16 x 6     | 4            | 4               |
| 7        | 16 x 6     | 4            | 4               |
| 8        | 50 x 6     | 2 - 4 - 2    | 7               |
| 9        | 16 x 6     | 4            | 2               |
| 10       | 6 x 6      | 4            | 2               |
| 11       | 6 x 6      | 4            | 2               |
| 12       | 50 x 6     | 2 - 4 - 2    | 5               |
| 13       | 16 x 6     | 4            | 8               |
| 14       | 16 x 6     | 4            | 8               |
| 15       | 16 x 6     | 4            | 8               |
| 16       | 50 x 6     | 2 - 4 - 2    | 3               |

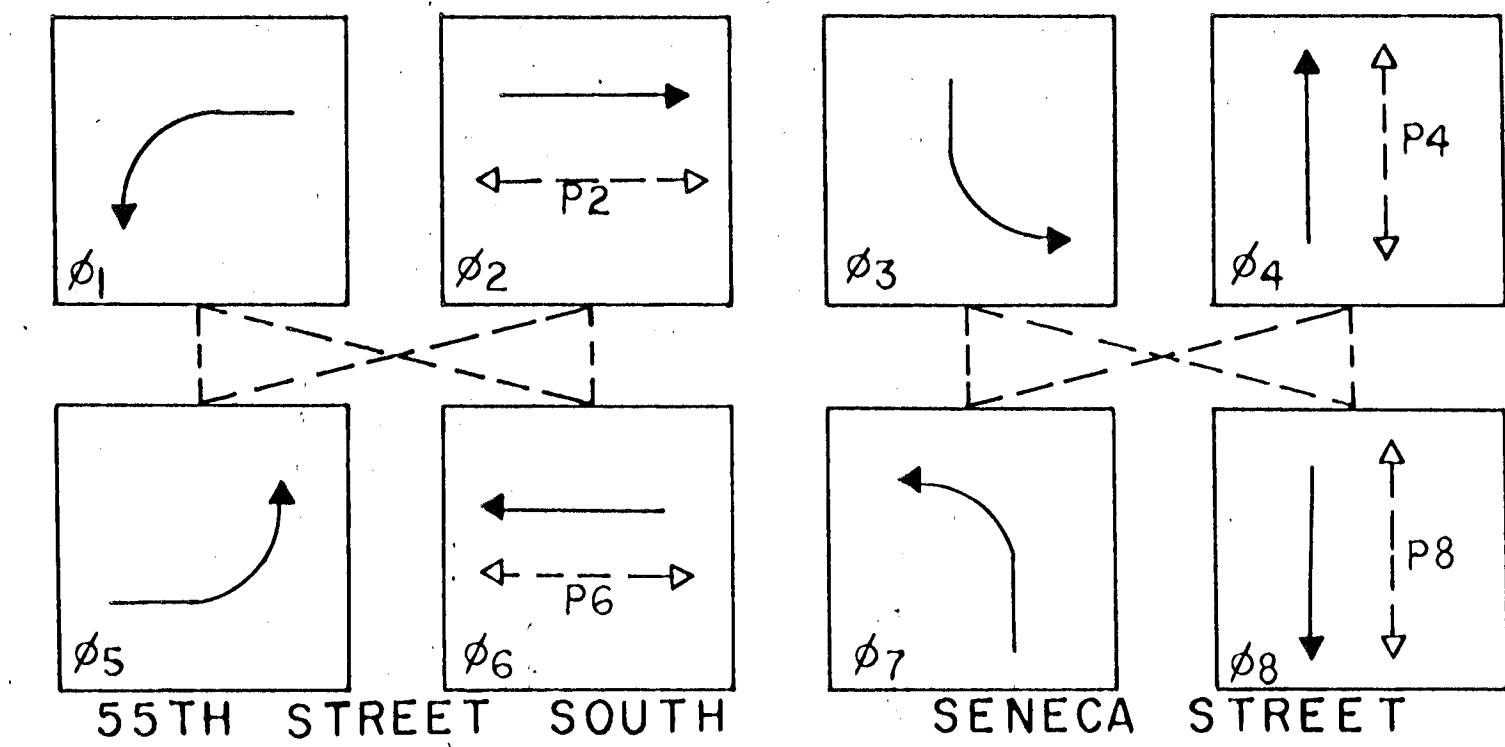

|                              |             |              |
|------------------------------|-------------|--------------|
| PROJECT DESCRIPTION          |             |              |
| 55TH ST. SOUTH & SENECA      |             |              |
| TRAFFIC SIGNAL PLAN          |             |              |
| PROJECT NUMBER               |             |              |
| 472-76-245-81752-000-000-001 |             |              |
| BOOK NO.                     | APPROVED BY | DATE NOV. 90 |
| DRAWN BY JKB                 |             | REVISED      |
| CITY OF WICHITA              |             |              |
| DEPARTMENT OF PUBLIC WORKS   |             |              |
| TRAFFIC ENGINEERING DIVISION |             |              |
| 29 of 58                     |             |              |