



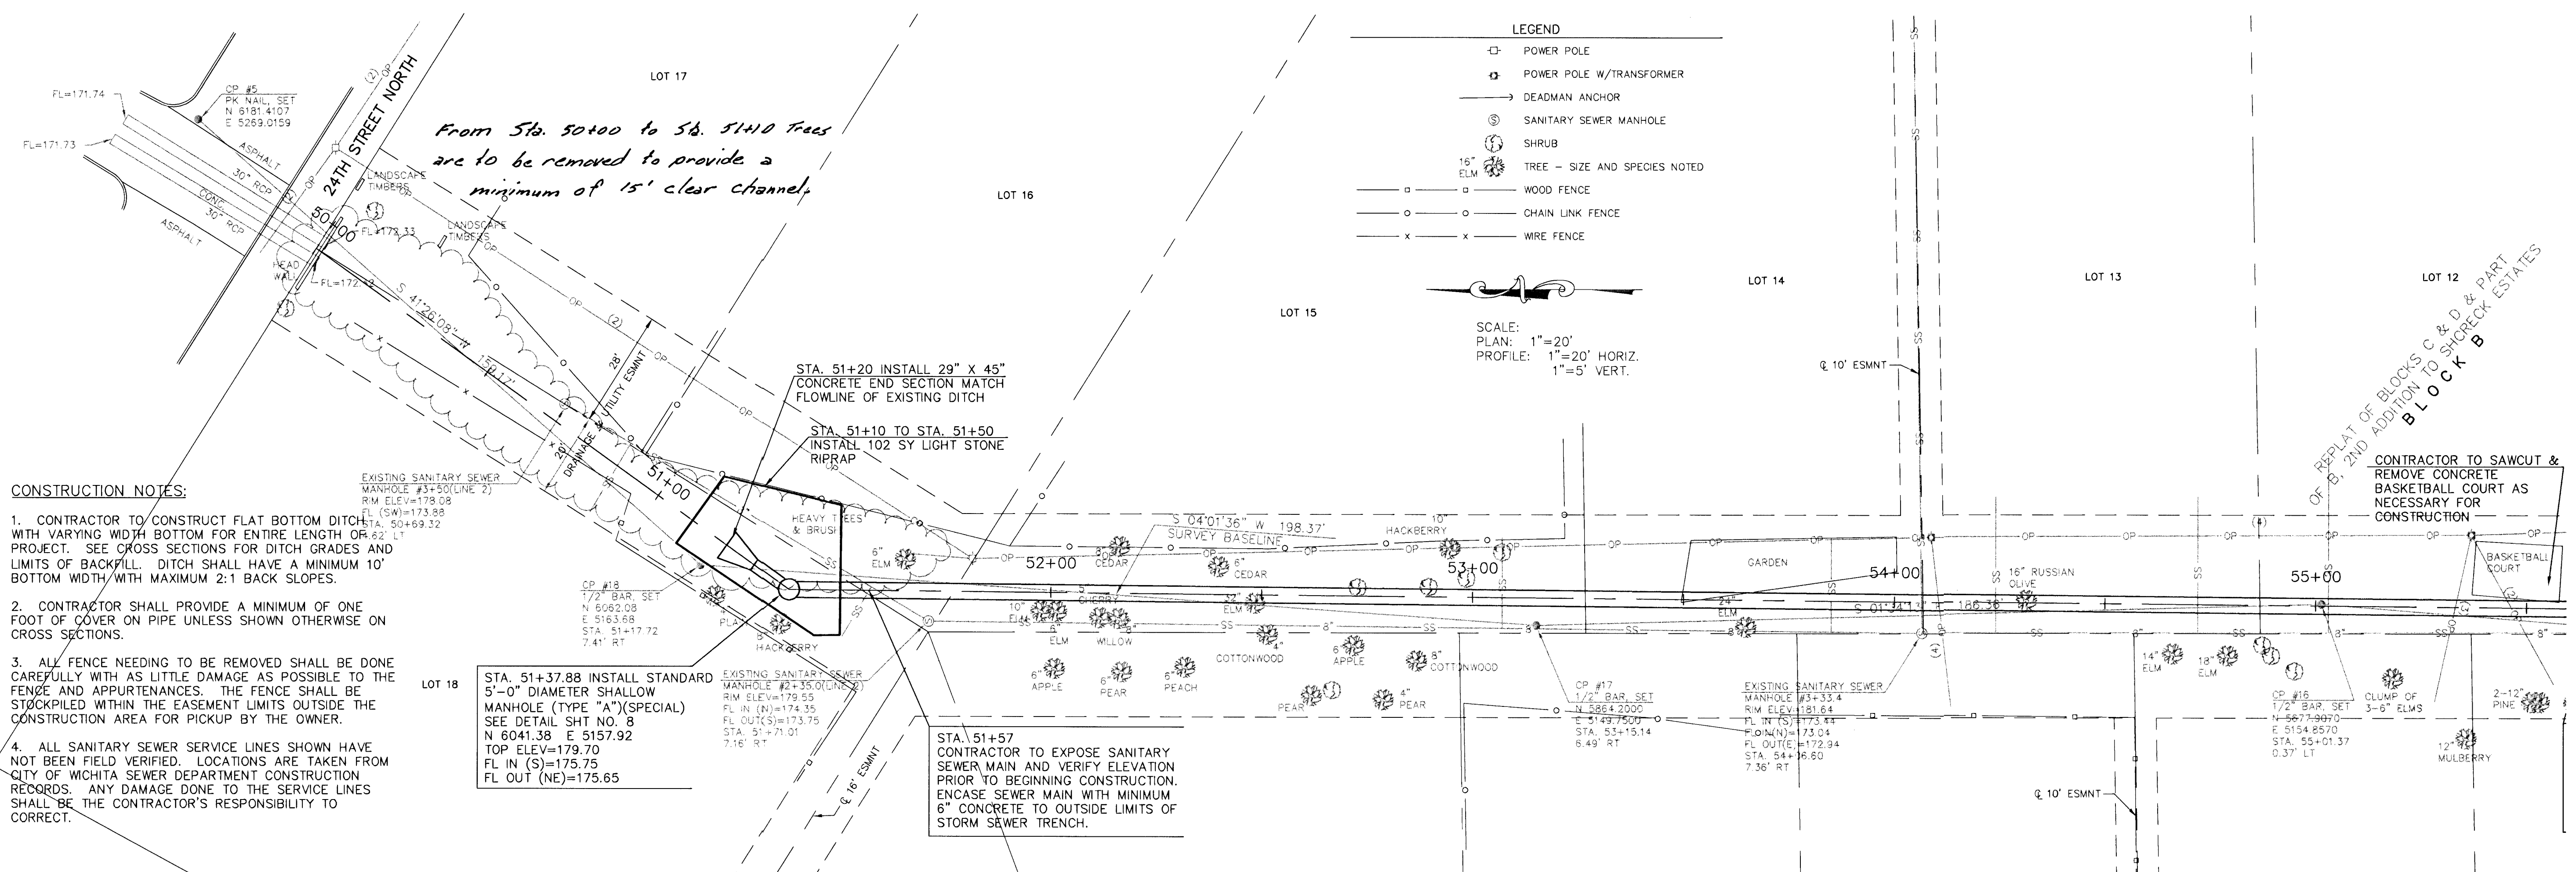

- CONSTRUCTION NOTES:**
1. CONTRACTOR TO CONSTRUCT FLAT BOTTOM DITCH WITH VARYING WIDTH BOTTOM FOR ENTIRE LENGTH OF PROJECT. SEE CROSS SECTIONS FOR DITCH GRADES AND LIMITS OF BACKFILL. DITCH SHALL HAVE A MINIMUM 10' BOTTOM WIDTH WITH MAXIMUM 2:1 BACK SLOPES.
 2. CONTRACTOR SHALL PROVIDE A MINIMUM OF ONE FOOT OF COVER ON PIPE UNLESS SHOWN OTHERWISE ON CROSS SECTIONS.
 3. ALL FENCE NEEDING TO BE REMOVED SHALL BE DONE CAREFULLY WITH AS LITTLE DAMAGE AS POSSIBLE TO THE FENCE AND APPURTENANCES. THE FENCE SHALL BE STOCKPILED WITHIN THE EASEMENT LIMITS OUTSIDE THE CONSTRUCTION AREA FOR PICKUP BY THE OWNER.
 4. ALL SANITARY SEWER SERVICE LINES SHOWN HAVE NOT BEEN FIELD VERIFIED. LOCATIONS ARE TAKEN FROM CITY OF WICHITA SEWER DEPARTMENT CONSTRUCTION RECORDS. ANY DAMAGE DONE TO THE SERVICE LINES SHALL BE THE CONTRACTOR'S RESPONSIBILITY TO CORRECT.

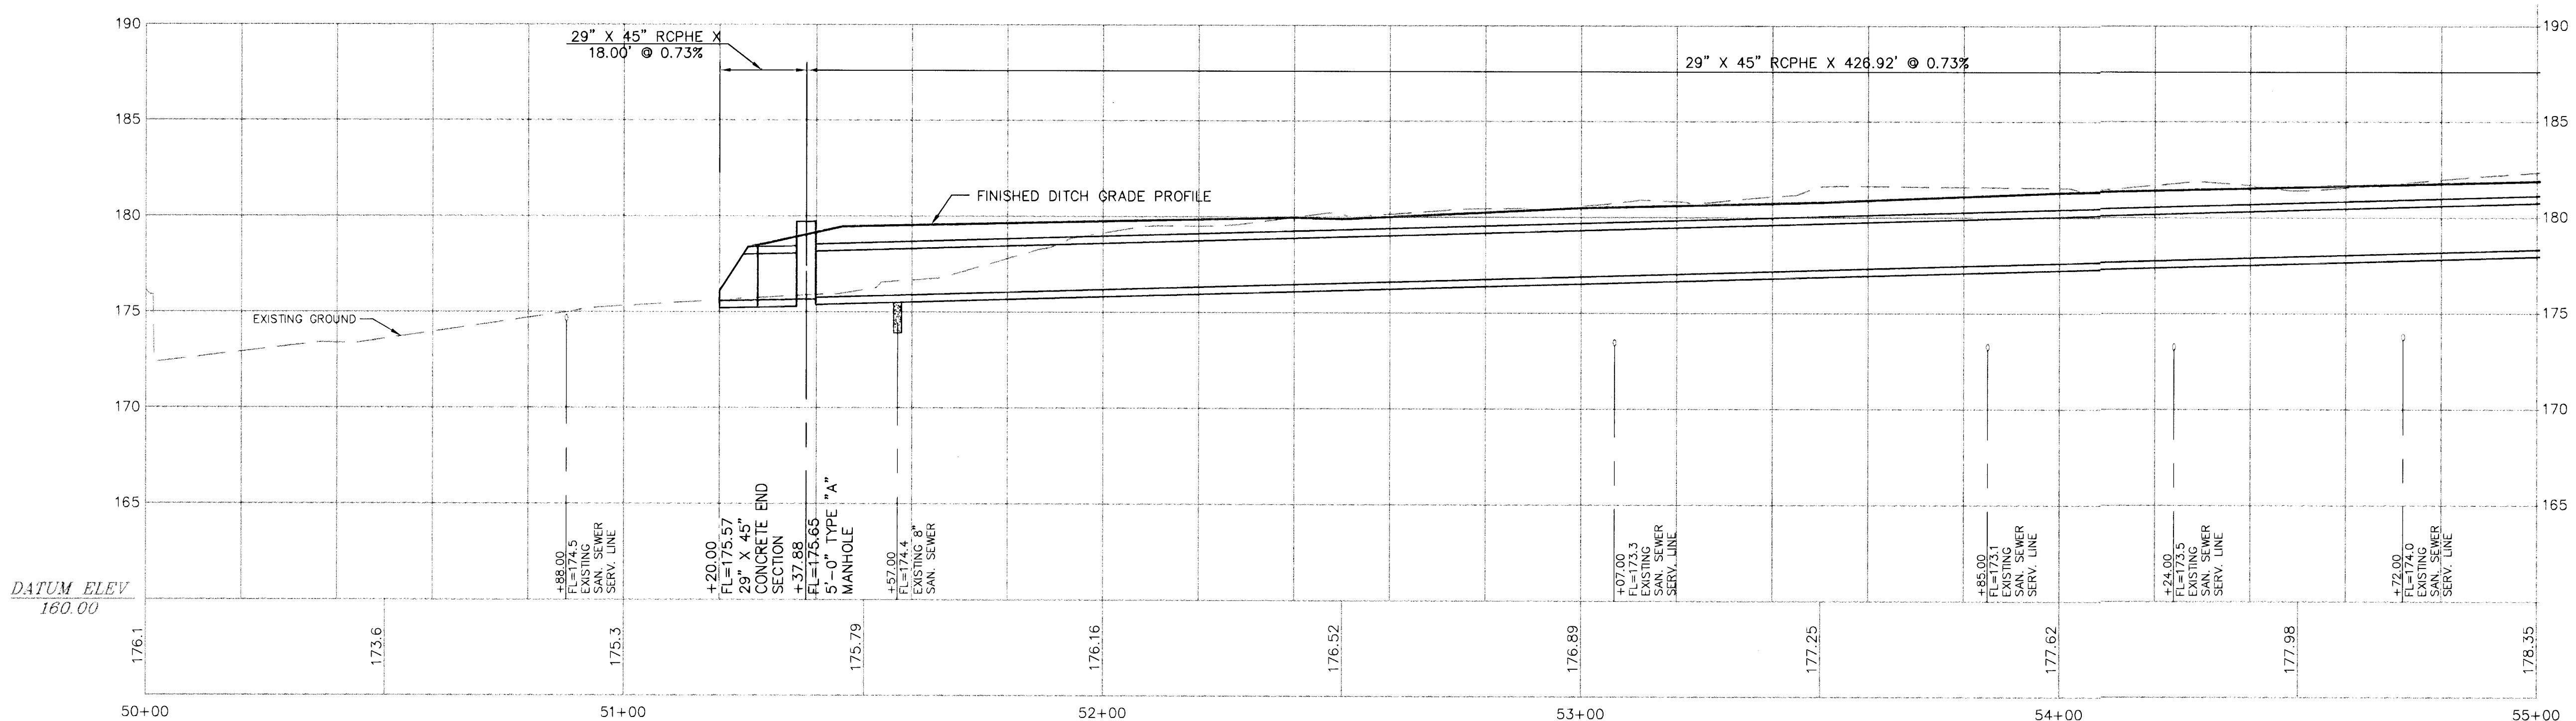

BENCHMARK BLUFF & 21ST ST. NORTH: COW BENCHMARK.
NW COR. INTERSECTION. 2.2' S. OF SOUTH FACE WALK.
2.0' E. OF EAST FACE WALK. 39.4' WEST OF CTR LINE.
BLUFF NORTH. 18' WEST OF CTR LINE BLUFF SOUTH. 44'
NORTH OF CTR LINE 21ST ST. 11.4' NW OF STREET LIGHT
POLE.
C.O.W. ELEV=201.08
U.S.G.S. ELEV=1388.48

BENCHMARK BLUFF & 21ST ST. NORTH: TEMPORARY BENCHMARK.
NW COR. INTERSECTION. R.R. SPIKE S-FACE STREET LIGHT
POLE.
C.O.W. ELEV=200.98
U.S.G.S. ELEV=1388.38

NO.	DATE	REVISION	BY
1	9-19-96	REVISED PER C.O.W. COMMENTS	JT

PLAN AND PROFILE

KAW VALLEY
ENGINEERING, INC

122 N.W. PARKWAY
RIVERSIDE, MISSOURI 64150
(816)587-5033
9571 ALDEN ROAD
LENEXA, KANSAS 66215
(913)762-5040
FAX 913-762-7744

PROJ. NO. 96-1801
DATE SEPT 9, 1996
DESIGNER SDM
DRAWN BY JT
CHECKED BY
CFN
SHEET 2 OF 8

D:\1801\1801P002 Mod Sep 18 16:19:37 1996 JAN