


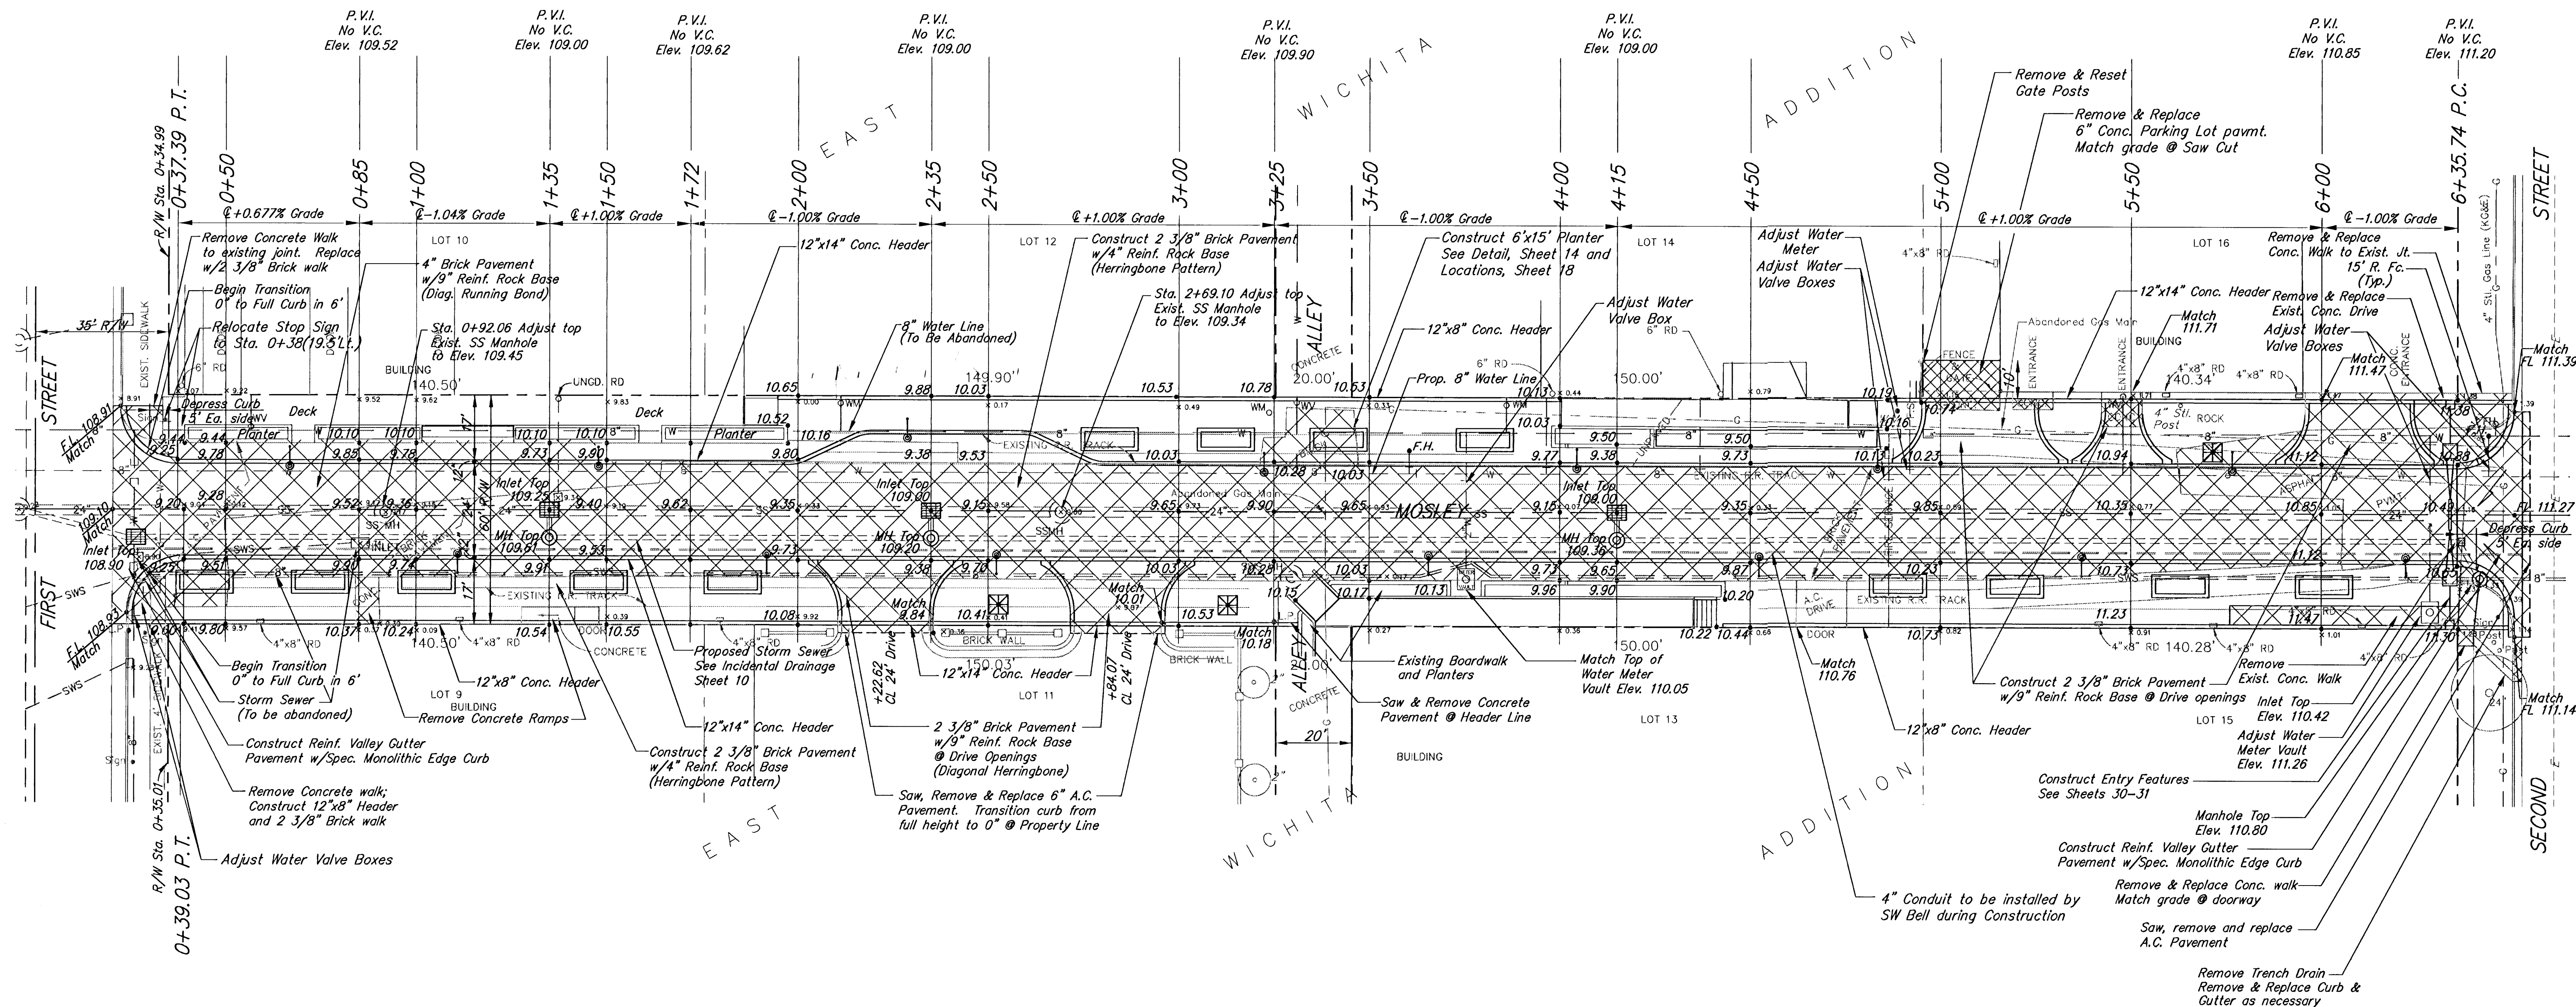

WATER VALVE BOX ADJUSTMENTS			
STA.	LOCATION	EXIST. ELEV.	FINISHED ELEV.
0+26.5	27.5' Rt.	109.55	109.55
0+27	23.5' Rt.	109.55	109.55
3+75	9' Lt.	109.68	109.68
4+86.5	9' Lt.	110.05	110.05
4+91.5	12' Lt.	110.13	110.13
6+28	9' Lt.	110.80	110.80
6+44	12' Lt.	111.30	111.30

ADDED ENTRY FEATURE 5-2-94			
OLD TOWN STREET IMPROVEMENTS PHASE 2 - MOSLEY			
SRB 841 SOUTH HILLSIDE WICHITA, KANSAS 67211		316-652-7754 FAX 652-7932	
SAVOY, RUGGLES & BOHM, P. A. ENGINEERING & SURVEYING			
PROJECT NUMBER 472-82374		INDEX CODE 705731	
DRAWN T. Brooks	DESIGN TCR	REVIEW	DATE 3/30/94
UTILITY		SRB JOB 705	705731