


Scale: PLAN
 1" = 20'
 PROFILE
 1" = 20' Horiz.
 1" = 5' Vert.

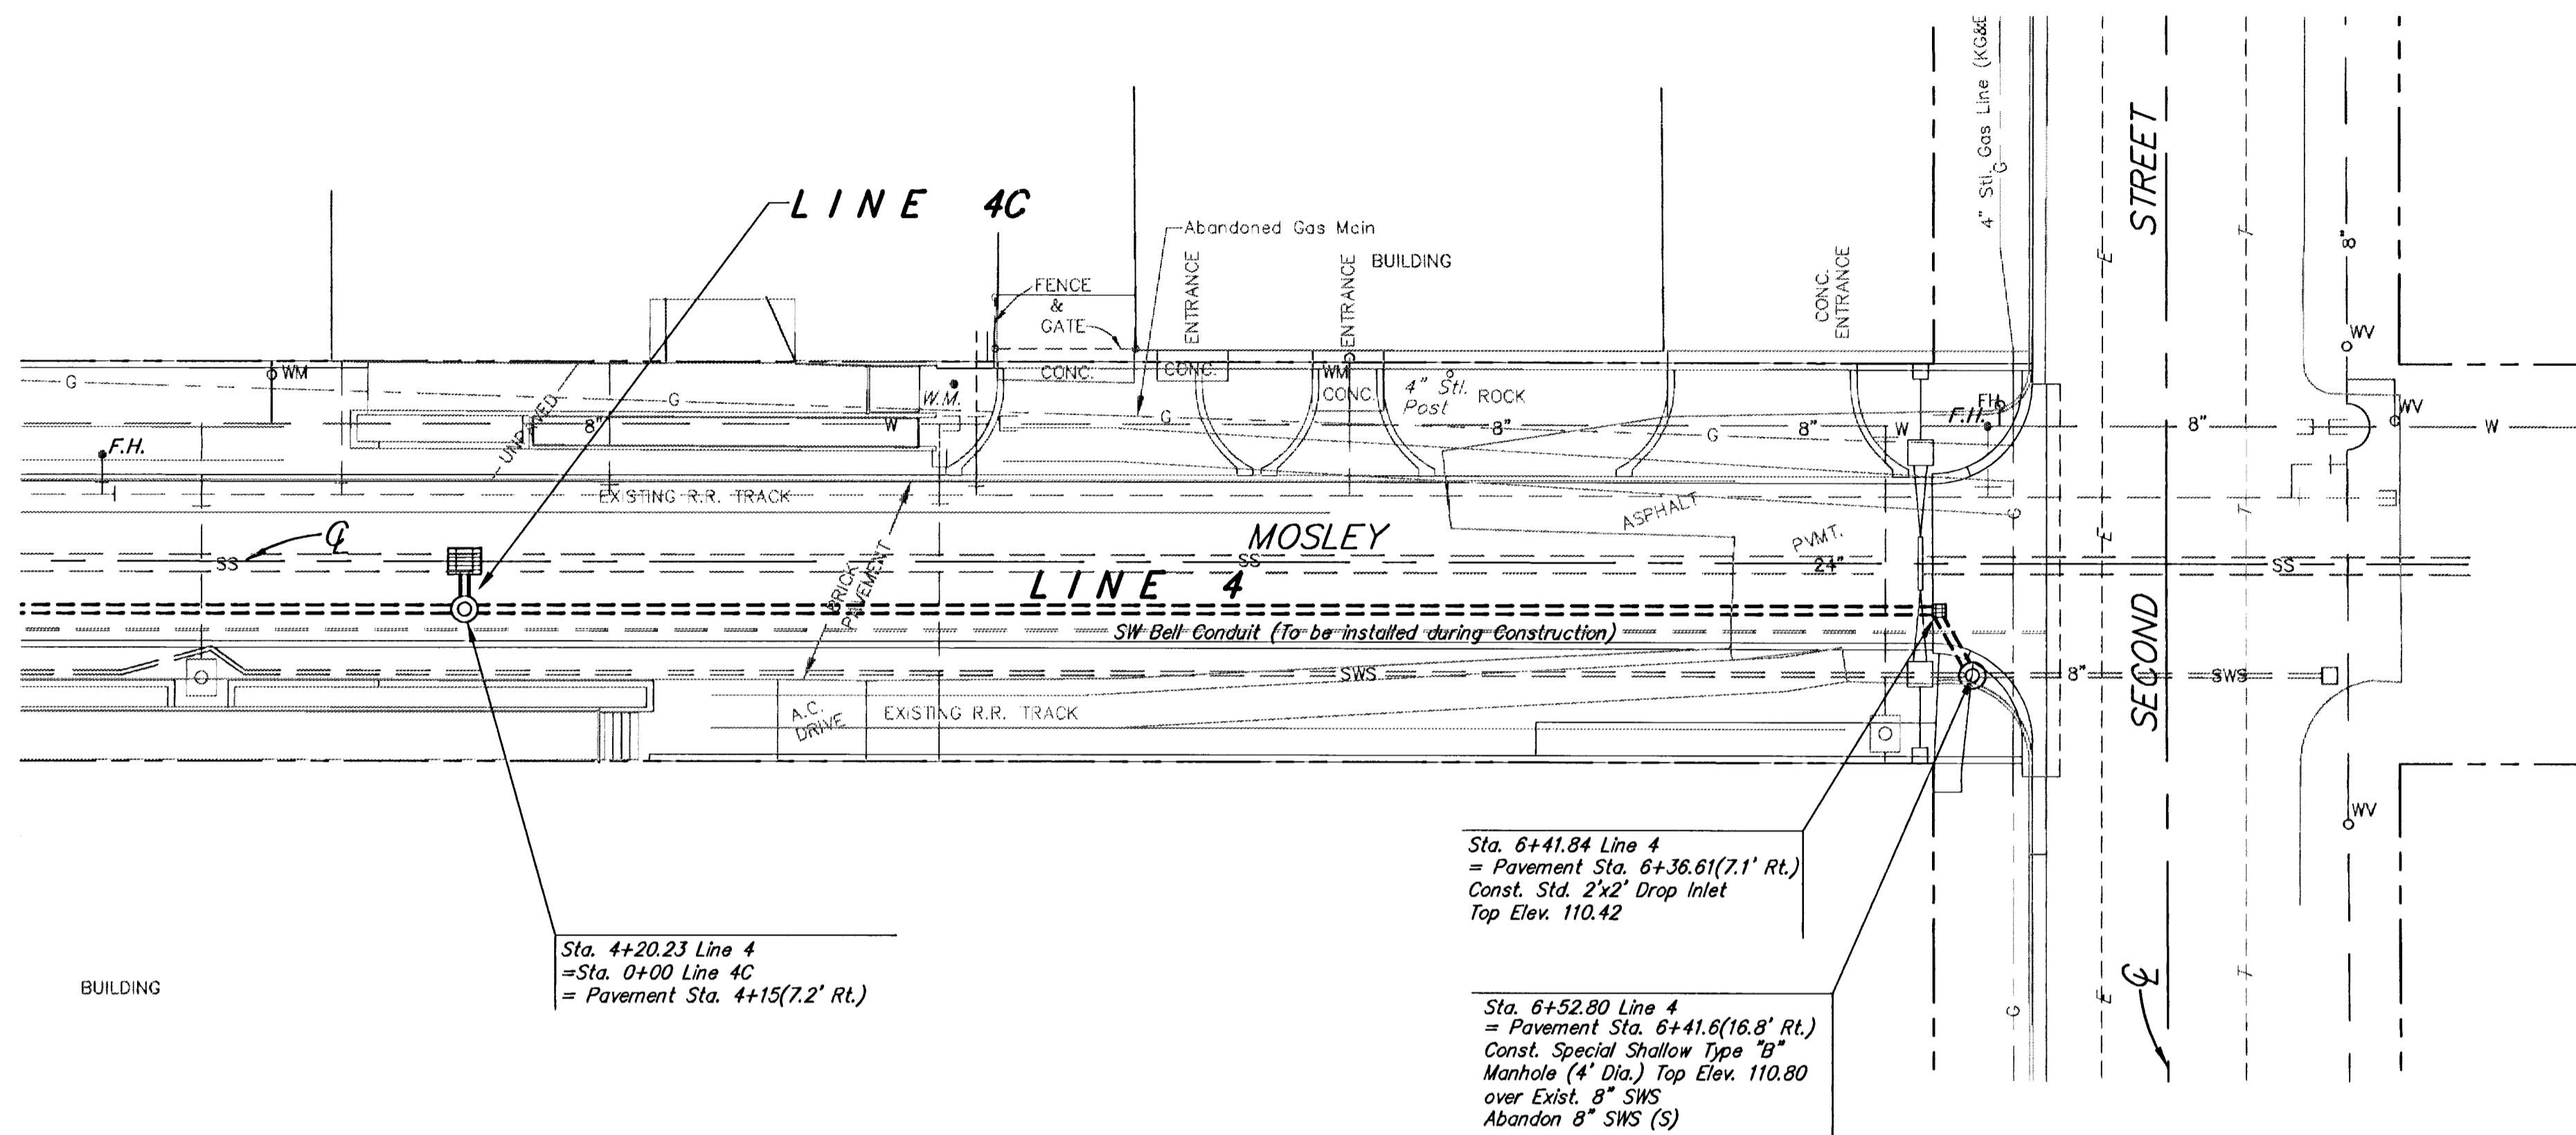


Sta. 4+20.23 Line 4
 = Sta. 0+00 Line 4C
 = Pavement Sta. 4+15(7.2' Rt.)

Sta. 6+41.84 Line 4
 = Pavement Sta. 6+36.61(7.1' Rt.)
 Const. Std. 2'x2' Drop Inlet
 Top Elev. 110.42

Sta. 6+52.80 Line 4
 = Pavement Sta. 6+41.6(16.8' Rt.)
 Const. Special Shallow Type "B"
 Manhole (4' Dia.) Top Elev. 110.80
 over Exist. 8" SWS
 Abandon 8" SWS (S)

NOTE: *Top* of Inlet elevations indicated
 = flowline @ CL of grate.

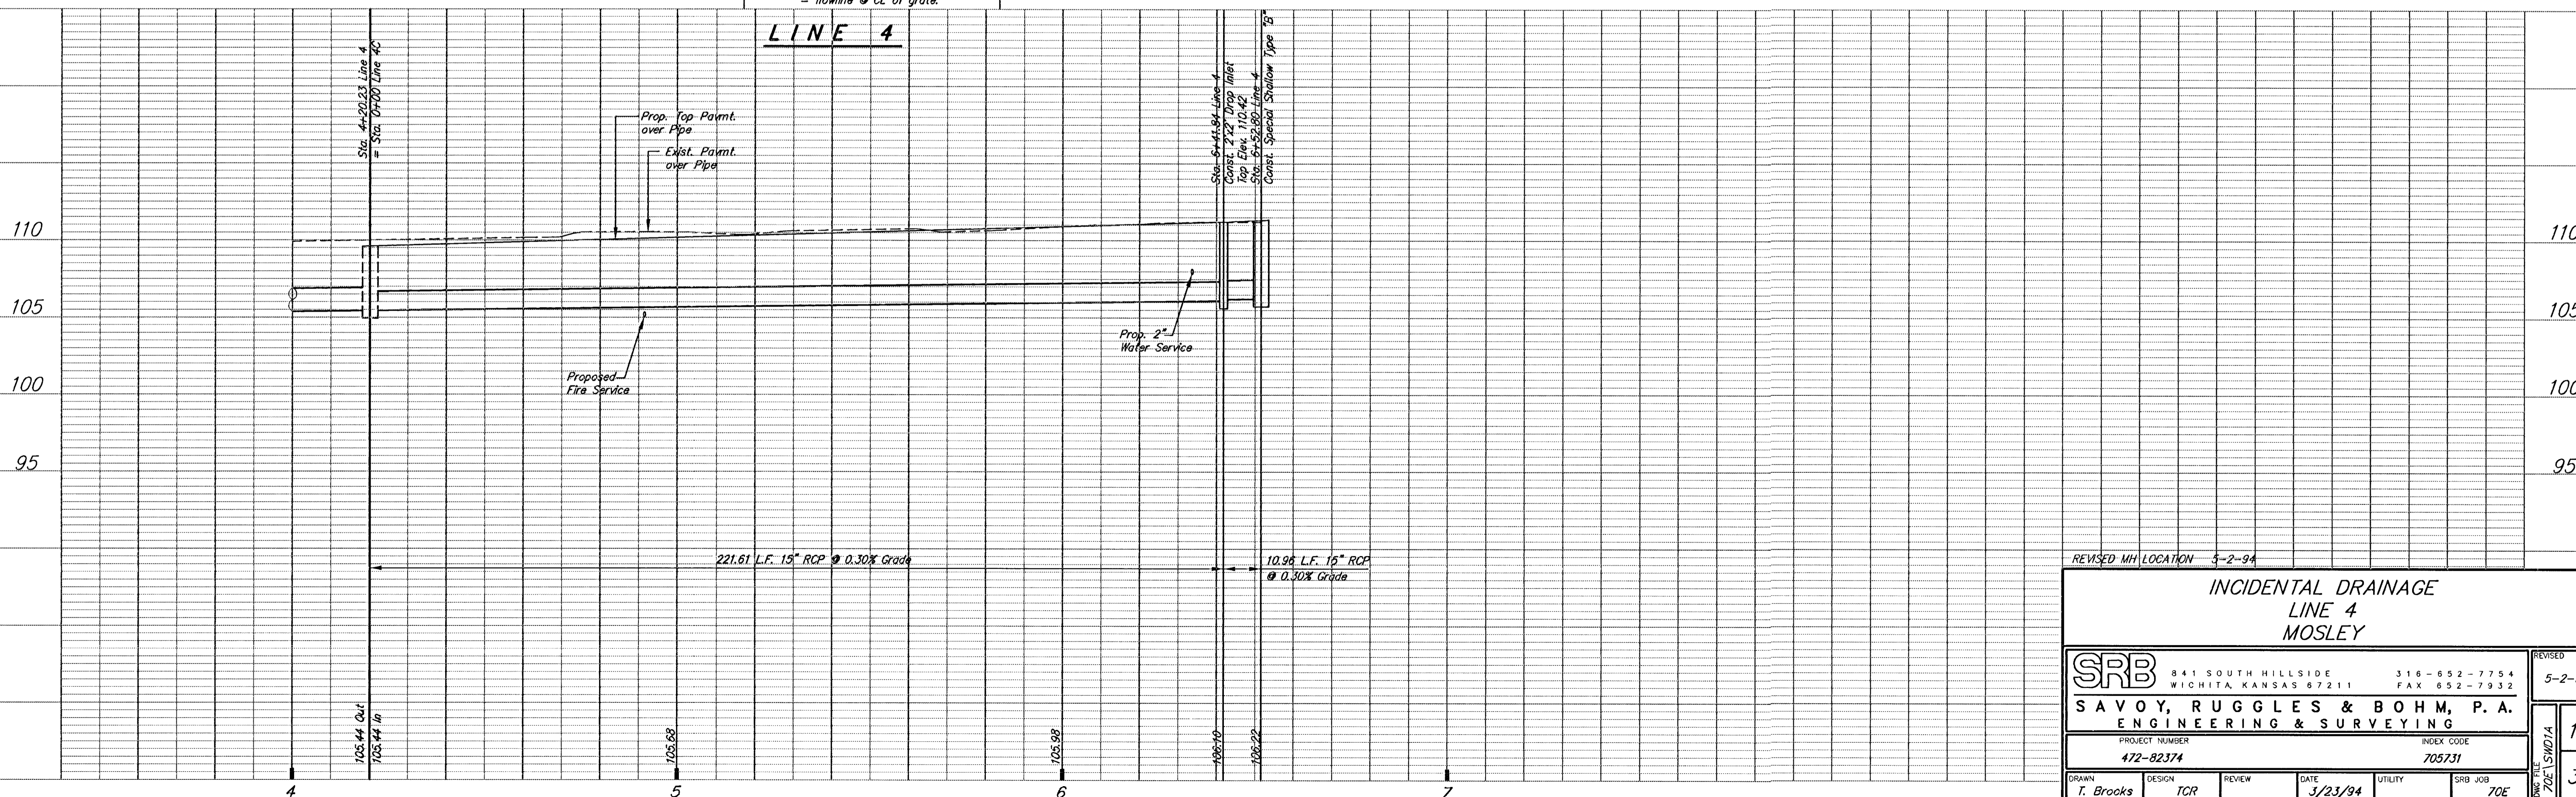

REVISED MH LOCATION 5-2-94

INCIDENTAL DRAINAGE
 LINE 4
 MOSLEY

		841 SOUTH HILLSIDE WICHITA, KANSAS 67211 316-652-7754 FAX 652-7932	REVISION 5-2-94
SAVOY, RUGGLES & BOHM, P. A. ENGINEERING & SURVEYING		PROJECT NUMBER 472-82374	INDEX CODE 705731
DRAWN T. Bracks	DESIGN TOR	REVIEW	DATE 3/23/94
		UTILITY 70E	SRB JOB 70E