WEST DOUGLAS STREETSCAPE


ARKANSAS RIVER TO SENECA

CITY OF WICHITA

CIP PROJECT NO. 472 83608

OCA 706846

MICHAEL E. LINDEBAK, P.E., CITY ENGINEER

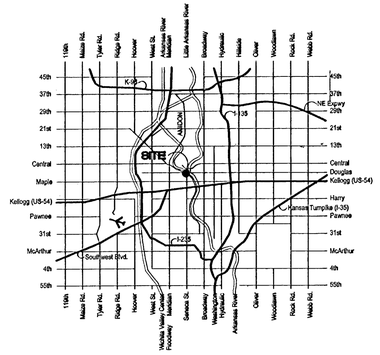

VICINITY MAP - WICHITA, KANSAS

JOHNSON ENGINEERING
ELECTRICAL CONSULTANTS
330 LAURA
WICHITA, KS 67211

STEVE MURILLO
MURILLO STUDIO
PUBLIC ART CONSULTANT

K.E. MILLER, PE
K.E. MILLER ENGINEERING
516 S. MARKET
WICHITA, KS 67202

DRAWING INDEX

SHEET NO.	SHEET TITLE
C10	COVER SHEET AND INDEX
CIVIL	
CV1.1	PAVING PLAN 1
CV1.2	PAVING PLAN 2
CV1.3	PAVING PLAN 3
CV1.4	PAVING PLAN 4
CV1.5	PAVING PLAN 5
CV1.6	PAVING PLAN 6
CV1.7	TYPICAL SECTION
CV2.1	STORM SEWER PLAN AND PROFILE PAGE 1
CV2.2	STORM SEWER PLAN AND PROFILE PAGE 2
CV2.3	STORM SEWER PLAN AND PROFILE PAGE 3
CV2.4	STORM SEWER PLAN AND PROFILE PAGE 4
CV2.5	STORM SEWER PLAN AND PROFILE PAGE 5
CV2.6	STORM SEWER PLAN AND PROFILE PAGE 6
CV2.7	STORM SEWER PLAN AND PROFILE PAGE 7
CV2.8	STORM SEWER PLAN AND PROFILE PAGE 8
CV2.9	STORM SEWER PLAN AND PROFILE PAGE 9
CV2.10	STORM SEWER PLAN AND PROFILE PAGE 10
CV2.11	STORM SEWER PLAN AND PROFILE PAGE 11
CV3.1	TYPE 2 INLET MH DETAIL
CV3.2	TYPE 2 INLET SINGLE DETAIL
CV3.3	5' TYPE 1A INLET DETAIL
CV3.4	DRIVE INLET DETAIL
CV3.5	MANHOLE DETAILS
CV4.1	STRIPING PLAN
CV4.2	STRIPING PLAN FOR ROUNDABOUT
CV4.3	SIGNAGE PLAN
CV4.4	SIGNAGE DETAILS
CV4.5	TRAFFIC CONTROL PLAN
CV4.6	ROUNDABOUT DETAIL
CV4.7	JOINT PLAN FOR INTERSECTIONS
CV4.8	JOINT PLAN FOR ROUNDABOUT
CV4.9	DRIVE ENTRANCE DETAILS
CV4.10	EROSION CONTROL MEASURES FOR STREET PROJECTS
CV4.11	EROSION CONTROL MEASURES FOR CURB INLETS
CV4.12	EROSION CONTROL MEASURES FOR AREA INLETS
CV5.1-5.9	CROSS SECTIONS
CV6.1	WATER LINE PLAN AND PROFILE PAGE 1
CV6.2	WATER LINE PLAN AND PROFILE PAGE 2
CV6.3	WATER LINE PLAN AND PROFILE PAGE 3
CV6.4	WATER LINE PLAN AND PROFILE PAGE 4
CV6.5	WATER LINE PLAN AND PROFILE PAGE 5
CV7.1	FIRE HYDRANT AND VALVE DETAILS
CV7.2	VAULT DETAILS
SITE	
SP1.1	STREETSCAPE PLAN 1
SP1.2	STREETSCAPE PLAN 2
SP1.3	STREETSCAPE PLAN 3
SP1.4	STREETSCAPE PLAN 4
SP1.5	STREETSCAPE PLAN 5
SP2.1	LAYOUT PLAN 1
SP2.2	LAYOUT PLAN 2
SP2.3	LAYOUT PLAN 3
SP2.4	LAYOUT PLAN 4
SP2.5	LAYOUT PLAN 5
SP3.1	SITE DETAILS
SP3.2	SITE DETAILS
SP3.3	SITE DETAILS
SP4.1	IRRIGATION PLAN 1
SP4.2	IRRIGATION PLAN 2
SP4.3	IRRIGATION PLAN 3
SP4.4	IRRIGATION PLAN 4
SP4.5	IRRIGATION PLAN 5
SP4.6	IRRIGATION DETAILS
SP5.1	LANDSCAPE PLAN 1
SP5.2	LANDSCAPE PLAN 2
SP5.3	LANDSCAPE PLAN 3
SP5.4	LANDSCAPE PLAN 4
SP5.5	LANDSCAPE PLAN 5
SP5.6	LANDSCAPE DETAILS

SHEET NO.	SHEET TITLE
ARCHITECTUAL	
A1.1	CLOCK TOWER
A1.2	CLOCK TOWER DETAILS
A1.3	CLOCK TOWER DETAILS
~~A2.1~~	~~ARCH DETAILS~~
~~A2.2~~	~~ARCH DETAILS~~
STRUCTURAL	
~~S1~~	~~ARCH DETAILS~~
ELECTRICAL	
E1.1	ELECTRICAL DETAILS & SCHEDULES
E1.2	ELECTRICAL PLANS 1 & 2
E1.3	ELECTRICAL PLANS 3 & 4
E1.4	ELECTRICAL PLAN 5 & DETAILS

Did Not Build

KEITH E. MILLER
REGISTERED
11233
KANSAS
PROFESSIONAL ENGINEER

CITY OF WICHITA

McCLUGGAGE VAN SICKLE & PERRY

ARCHITECTS • PLANNERS • LANDSCAPE ARCHITECTS
125 S. WASHINGTON WICHITA, KANSAS 67202
P.O. BOX 3948 WICHITA, KANSAS 67201
PH. 316.262.1643 • FAX 316.262.1645

WEST DOUGLAS STREETSCAPE
ARKANSAS RIVER TO SENECA
WICHITA, KANSAS

STEPHEN M. PERRY 1158 REGISTERED LANDSCAPE ARCHITECT

PROJECT NO. 472 83608
MVP PROJECT NO. 1010
DATE: AUGUST 7, 2007
REVISED: Feb 1 2013

SHEET
C1.0