


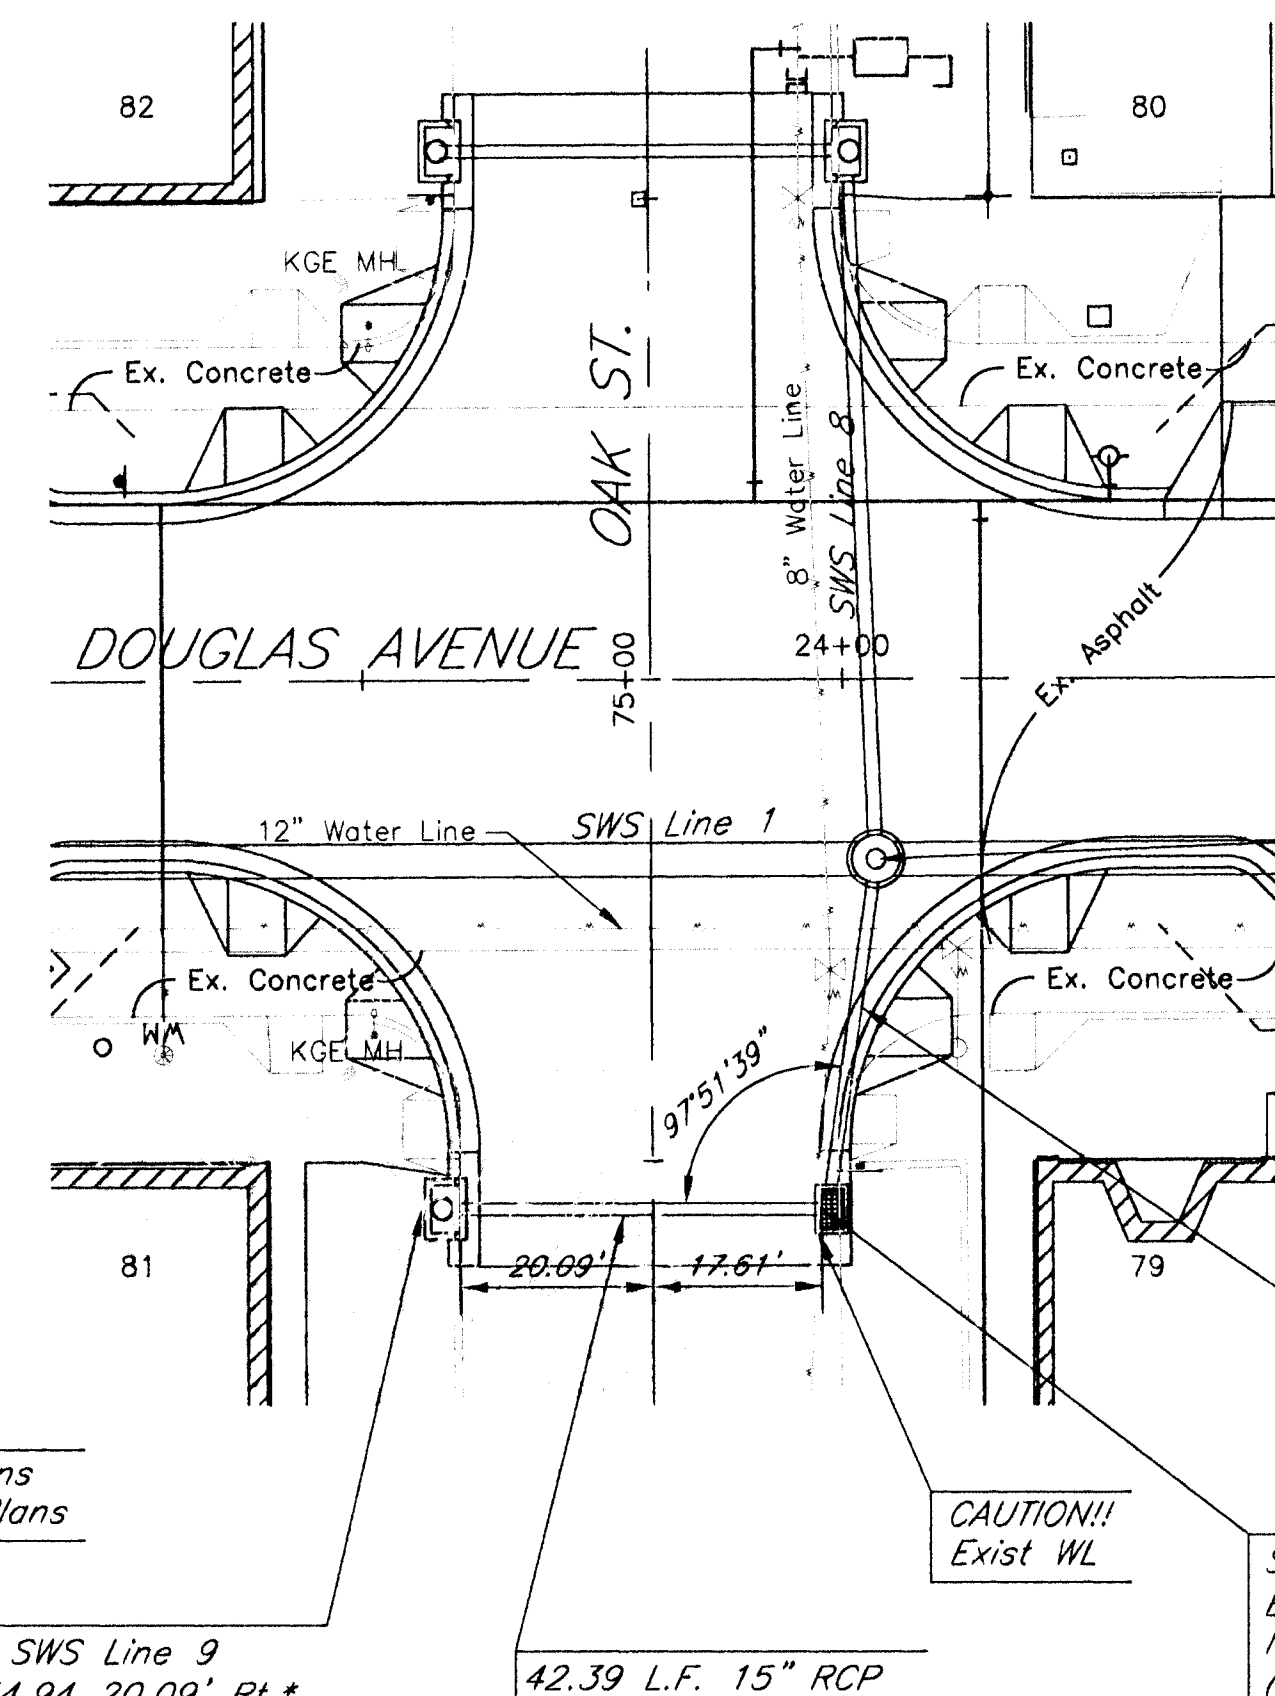

Sta 0+00 SWS Line 8=
Sta 0+00 SWS Line 9=
Sta 10+41.02 SWS Line 1
Top=111.69
FI(E)=105.99
FI(W)=106.19
FI(N)=108.44
FI(S)=108.19

Sta 0+36.69 SWS Line 9
BL Sta 75+55.07 17.61' Lt.
Install 1-Drive Inlet
(Sheet CV 3.4)
Top=111.32
 $FI(E)=108.68$
 $FI(S)=108.58$

* Offset dimension for inlets are measured from the inside face of the box structure nearest the curb to the centerline of the street right of way



SWS PLAN 8

SHEET

CV 2.8

PROJECT NO. 472 83608 **OCA:** 706846
MVP PROJECT NO. 101008
DATE: August 7, 2002
REVISED: August 30, 2002

WEST DOUGLAS STREETSCAPE
ARKANSAS RIVER TO SENECA
WICHITA, KANSAS

ARCHITECTS • PLANNERS • LANDSCAPE ARCHITECTS
