

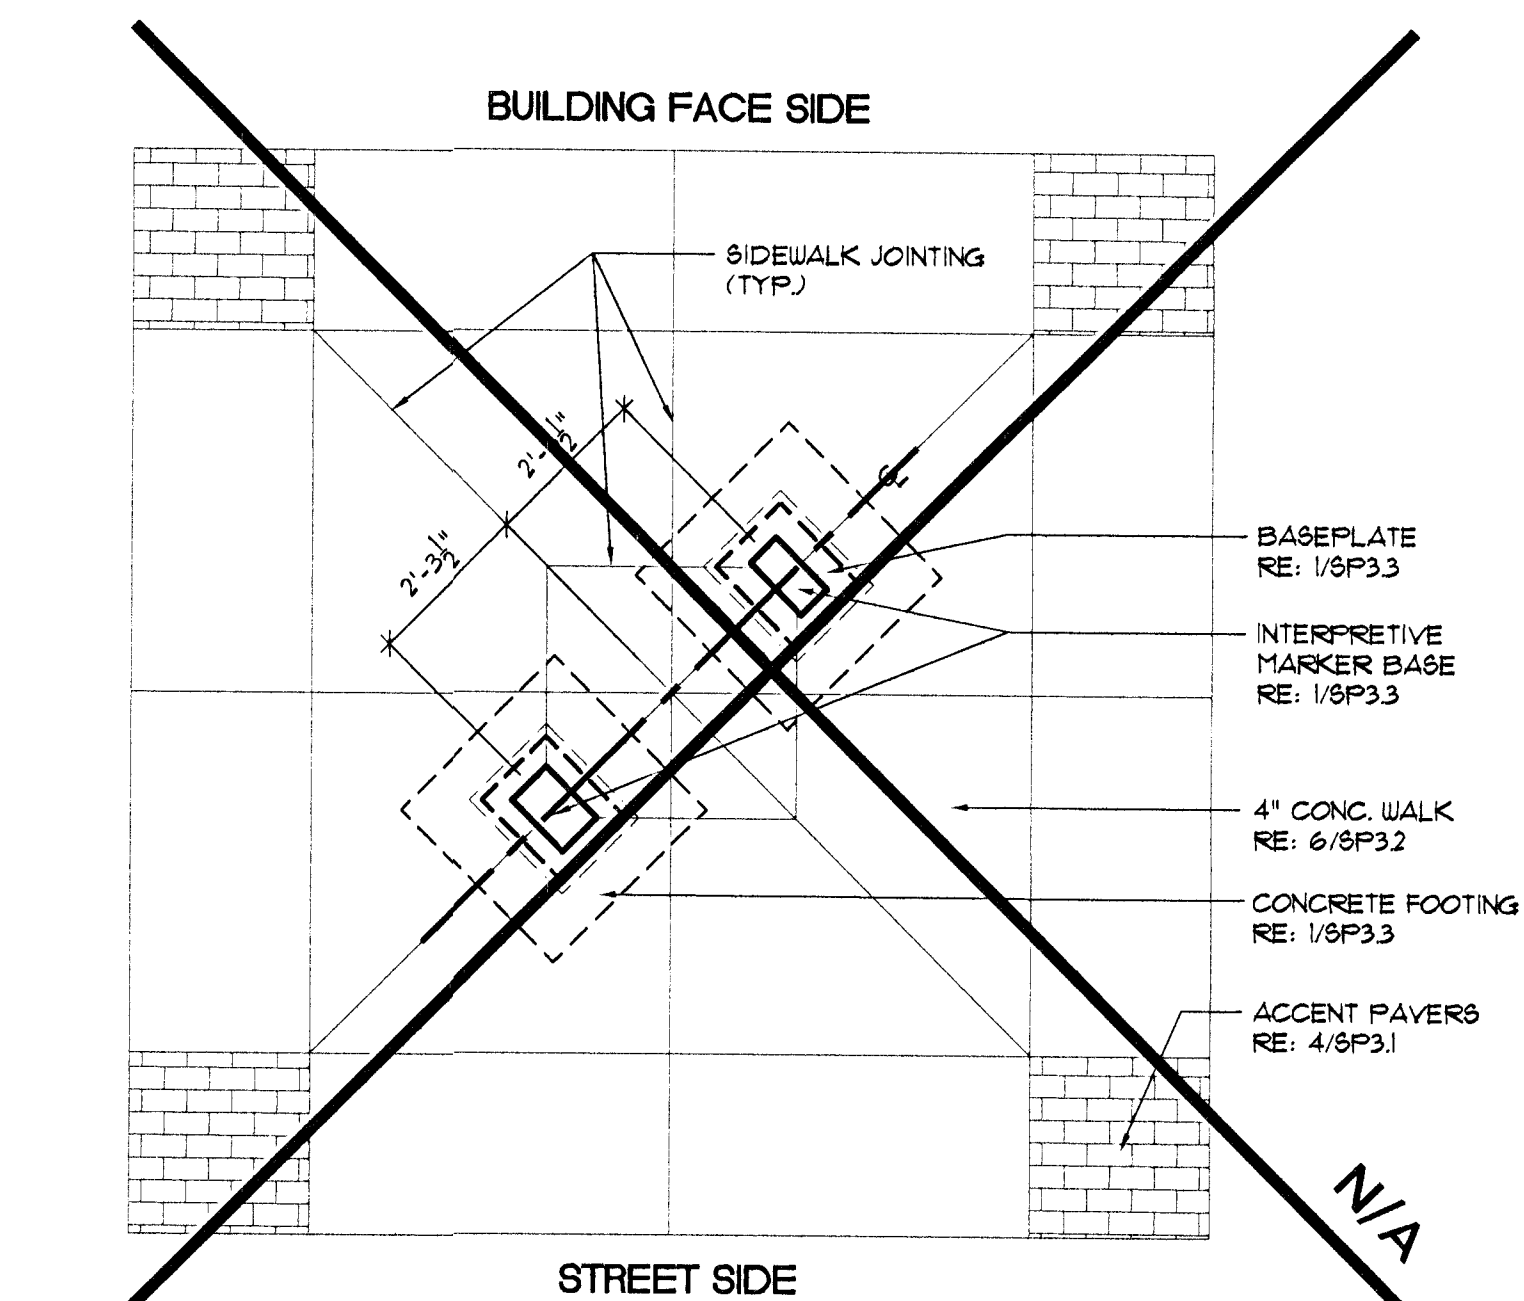


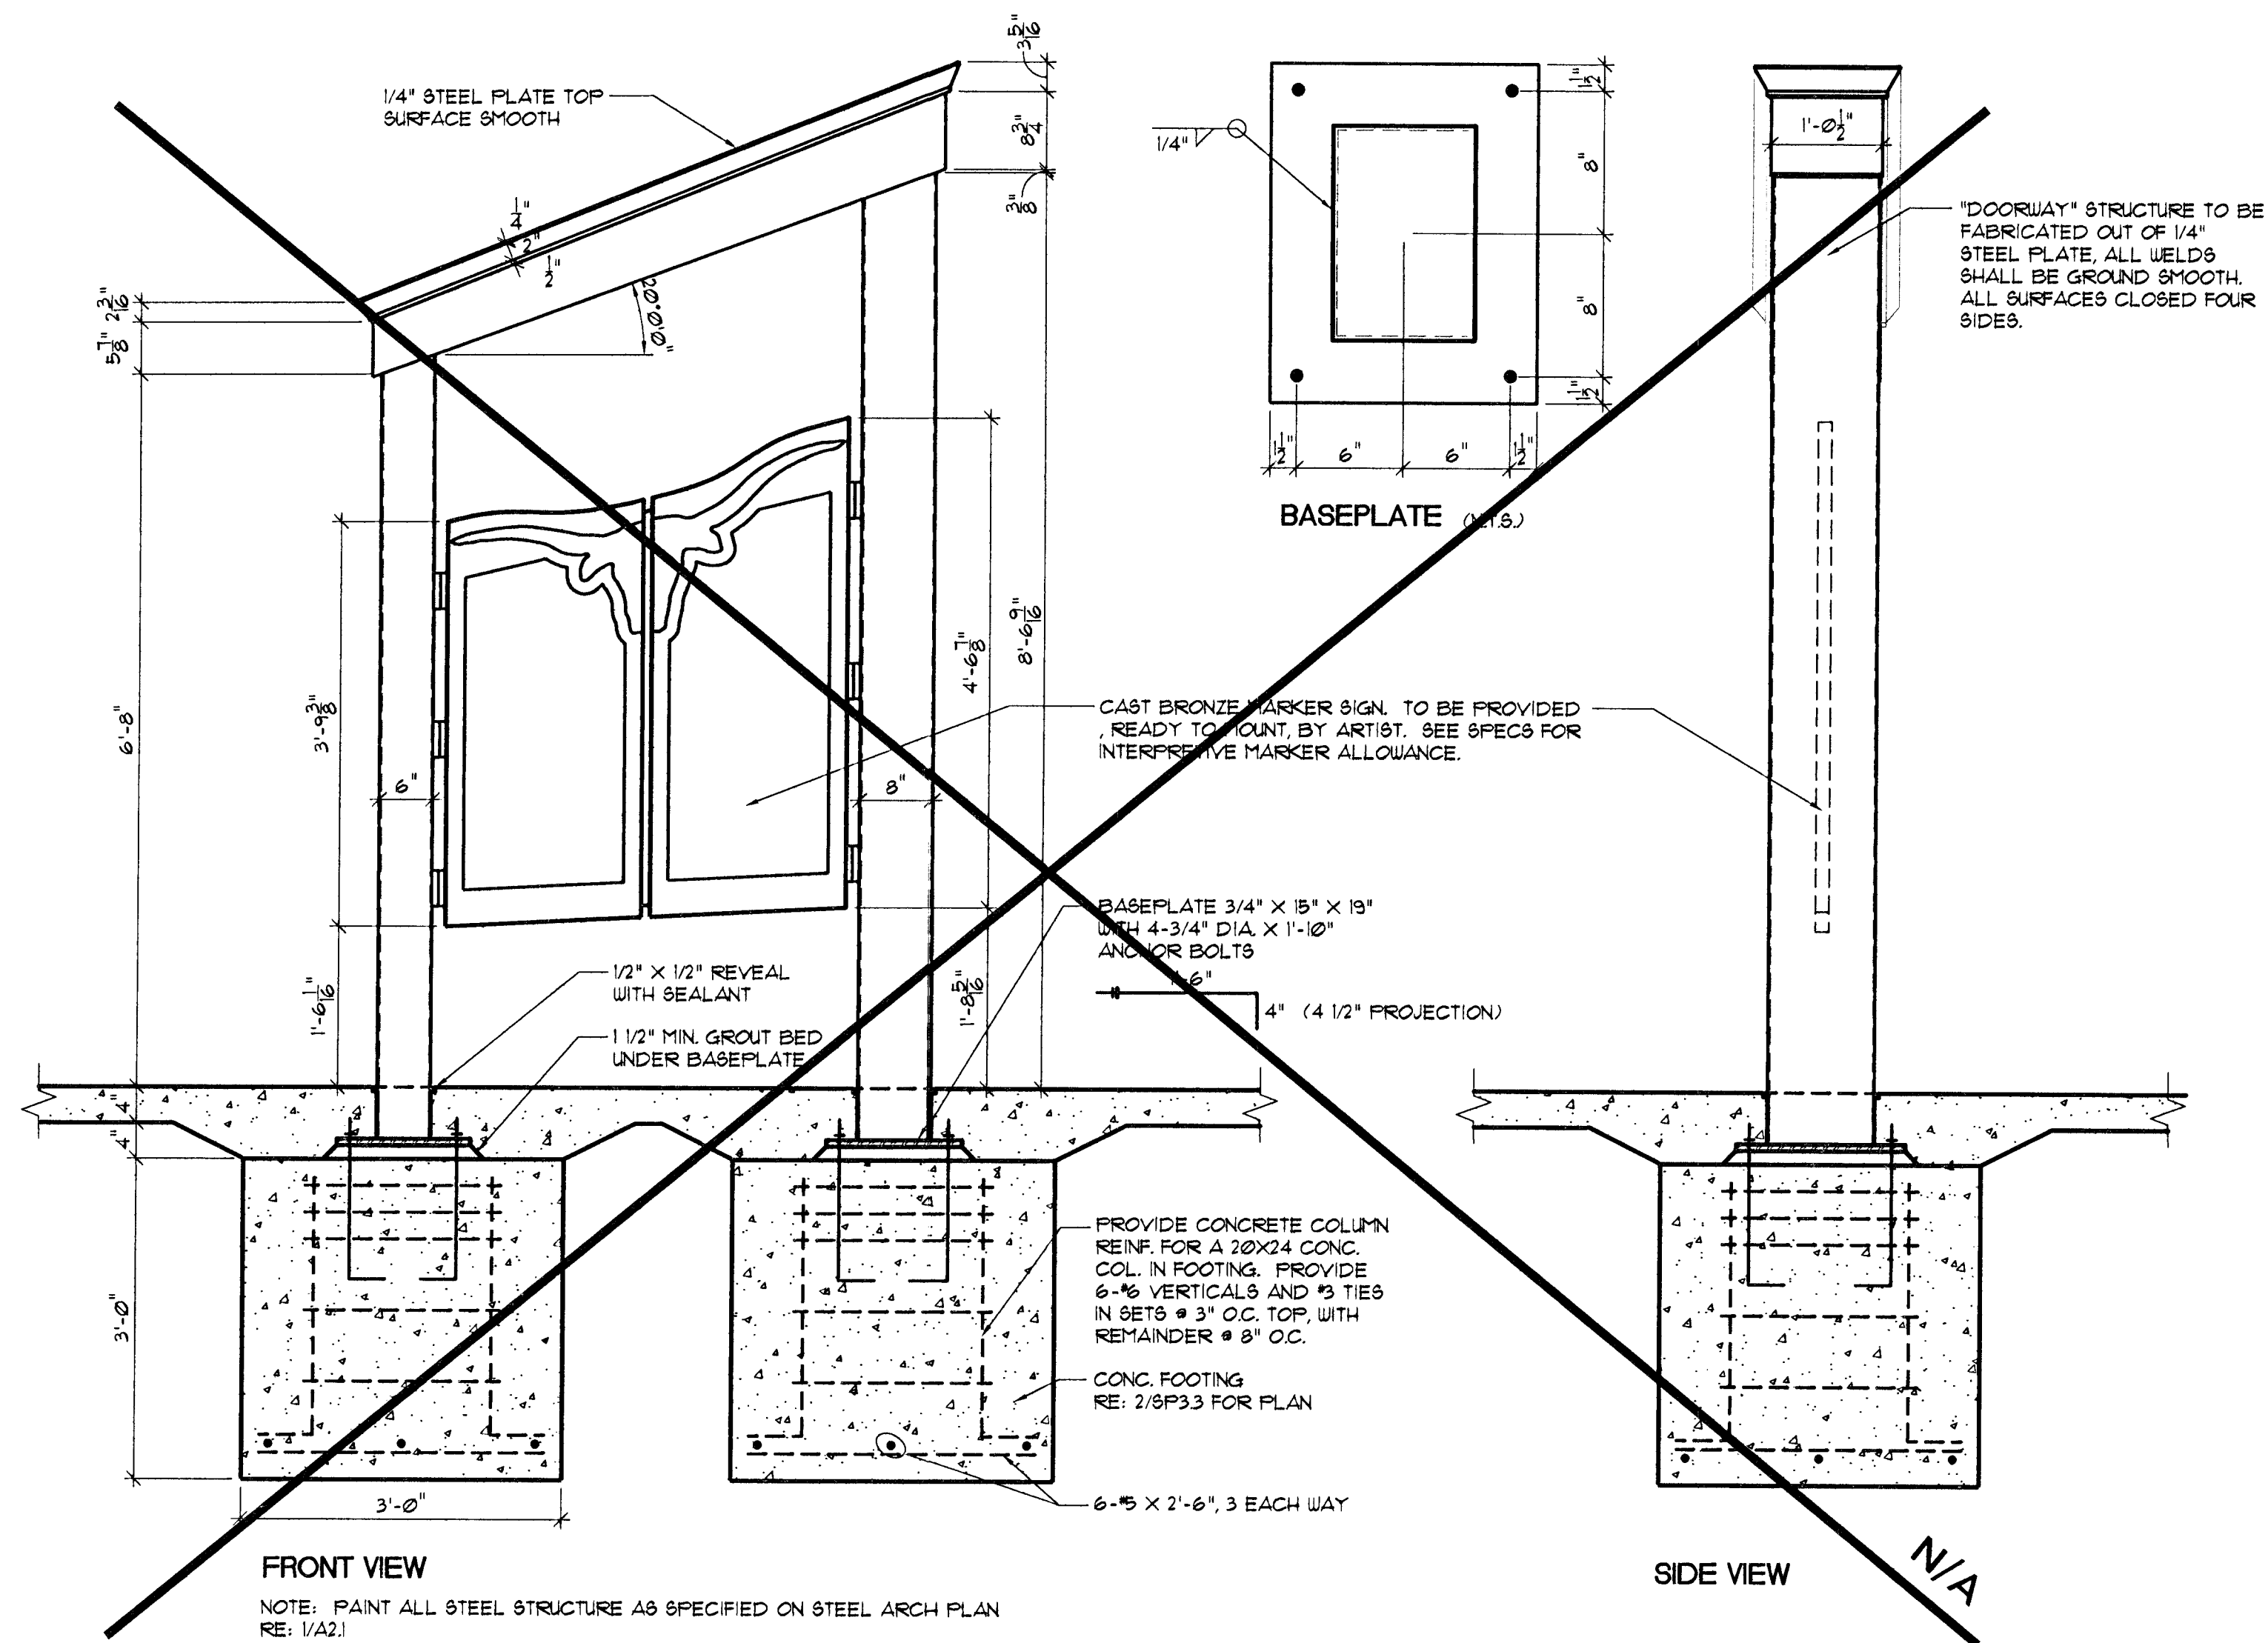

1 INTERPRETIVE MARKER (ALT. #2)


(6 REQUIRED)

NOTE: CONTRACTOR SHALL INCLUDE THE ALLOWANCE AS STATED IN THE SPECS FOR PAYMENT TO THE ARTIST FOR FABRICATION AND DELIVERY TO JOB SITE OF UNPAINTED STEEL STRUCTURES AND BRONZE PANELS. CONTRACTOR SHALL PAINT AND INSTALL STEEL STRUCTURES AND INSTALL BRONZE PANELS.

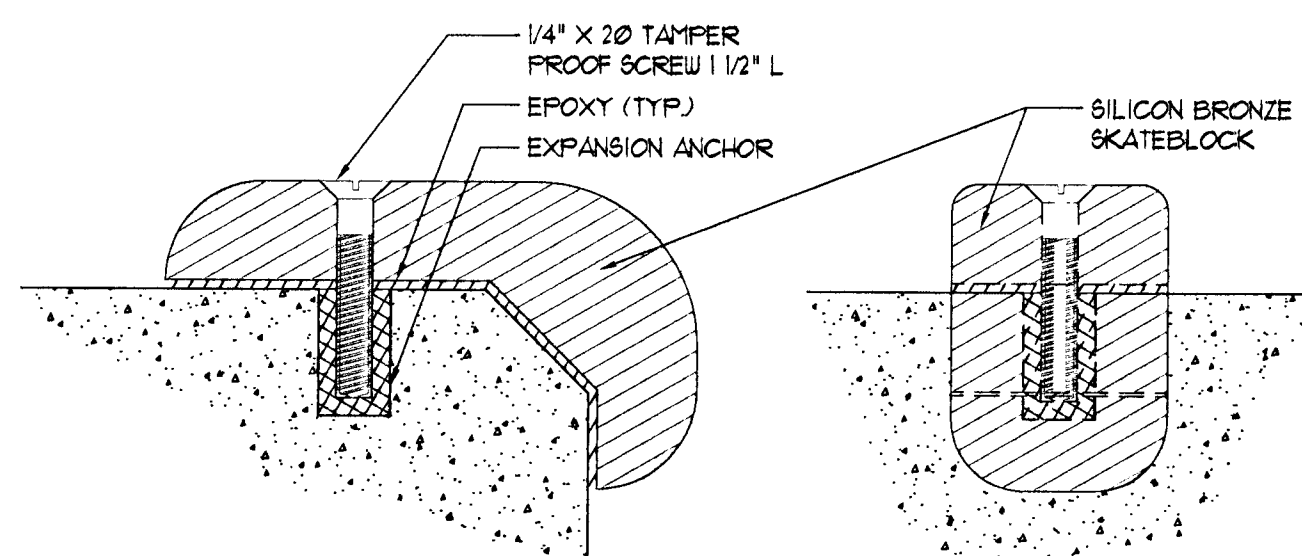

② SKATEBLOCK DETAIL

NOTE: SKATEBLOCK FOR RAISED PLANTER WALLS SHALL BE MODEL "FB.15B" FLAT BAR - 3/4" BEVEL CORNER CAST IN SILICON BRONZE WITH BOLT HOLE /TAMPERPROOF SCREW: RAVENSFORGE SKATEBLOCK (206) 440-9833 OR (888) 743-3490.

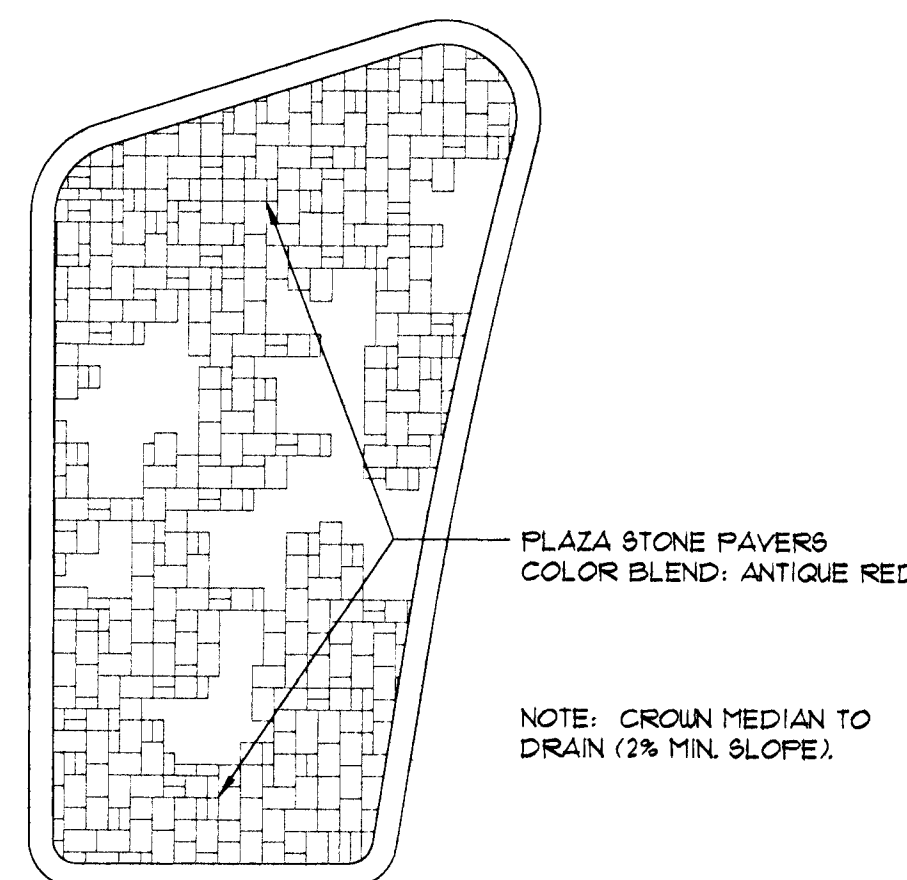

④ TRAFFIC ISLAND PAVER DETAIL (TYP.)

PAVER NOTES:

CONCRETE PAVERS SHALL BE 'PLAZA STONE' PAVERS AS MANUFACTURED
BY PAVESTONE CO. THICKNESS = 3 1/8" LOCAL DISTRIBUTOR: KANSAS
BUILDING PRODUCTS 1600 SOUTH HOOVER 316-943-3241
RE: CV.1.1 (SIMILAR) FOR INSTALLATION DETAIL.



RE: SPI.1 - SPI.5 FOR LOCATIONS

SCALE: 3/8" = 1'-0"

NOTE: FRONT OF INTERPRETIVE MARKER SHALL FACE TOWARD BUILDING FACE.



SITE DETAILS

SHEET

SP3.3

**WEST DOUGLAS STREETSCAPE
ARKANSAS RIVER TO SENECA
WICHITA, KANSAS**

PROJECT NO. 472 83608
MVP PROJECT NO. 101008
DATE: AUGUST 7, 2002
REVISED: AUGUST 30, 2002
REVISED CONST. SET:
FEBRUARY 7, 2003

ARCHITECTS • PLANNERS • LANDSCAPE ARCHITECTS
125 S. WASHINGTON WICHITA, KANSAS 67202
P.O. BOX 3846 WICHITA, KANSAS 67201
PH. 363.920481 • FAX 363.923465

MCCUUGGAGE VAN SICKLE & PERRY