



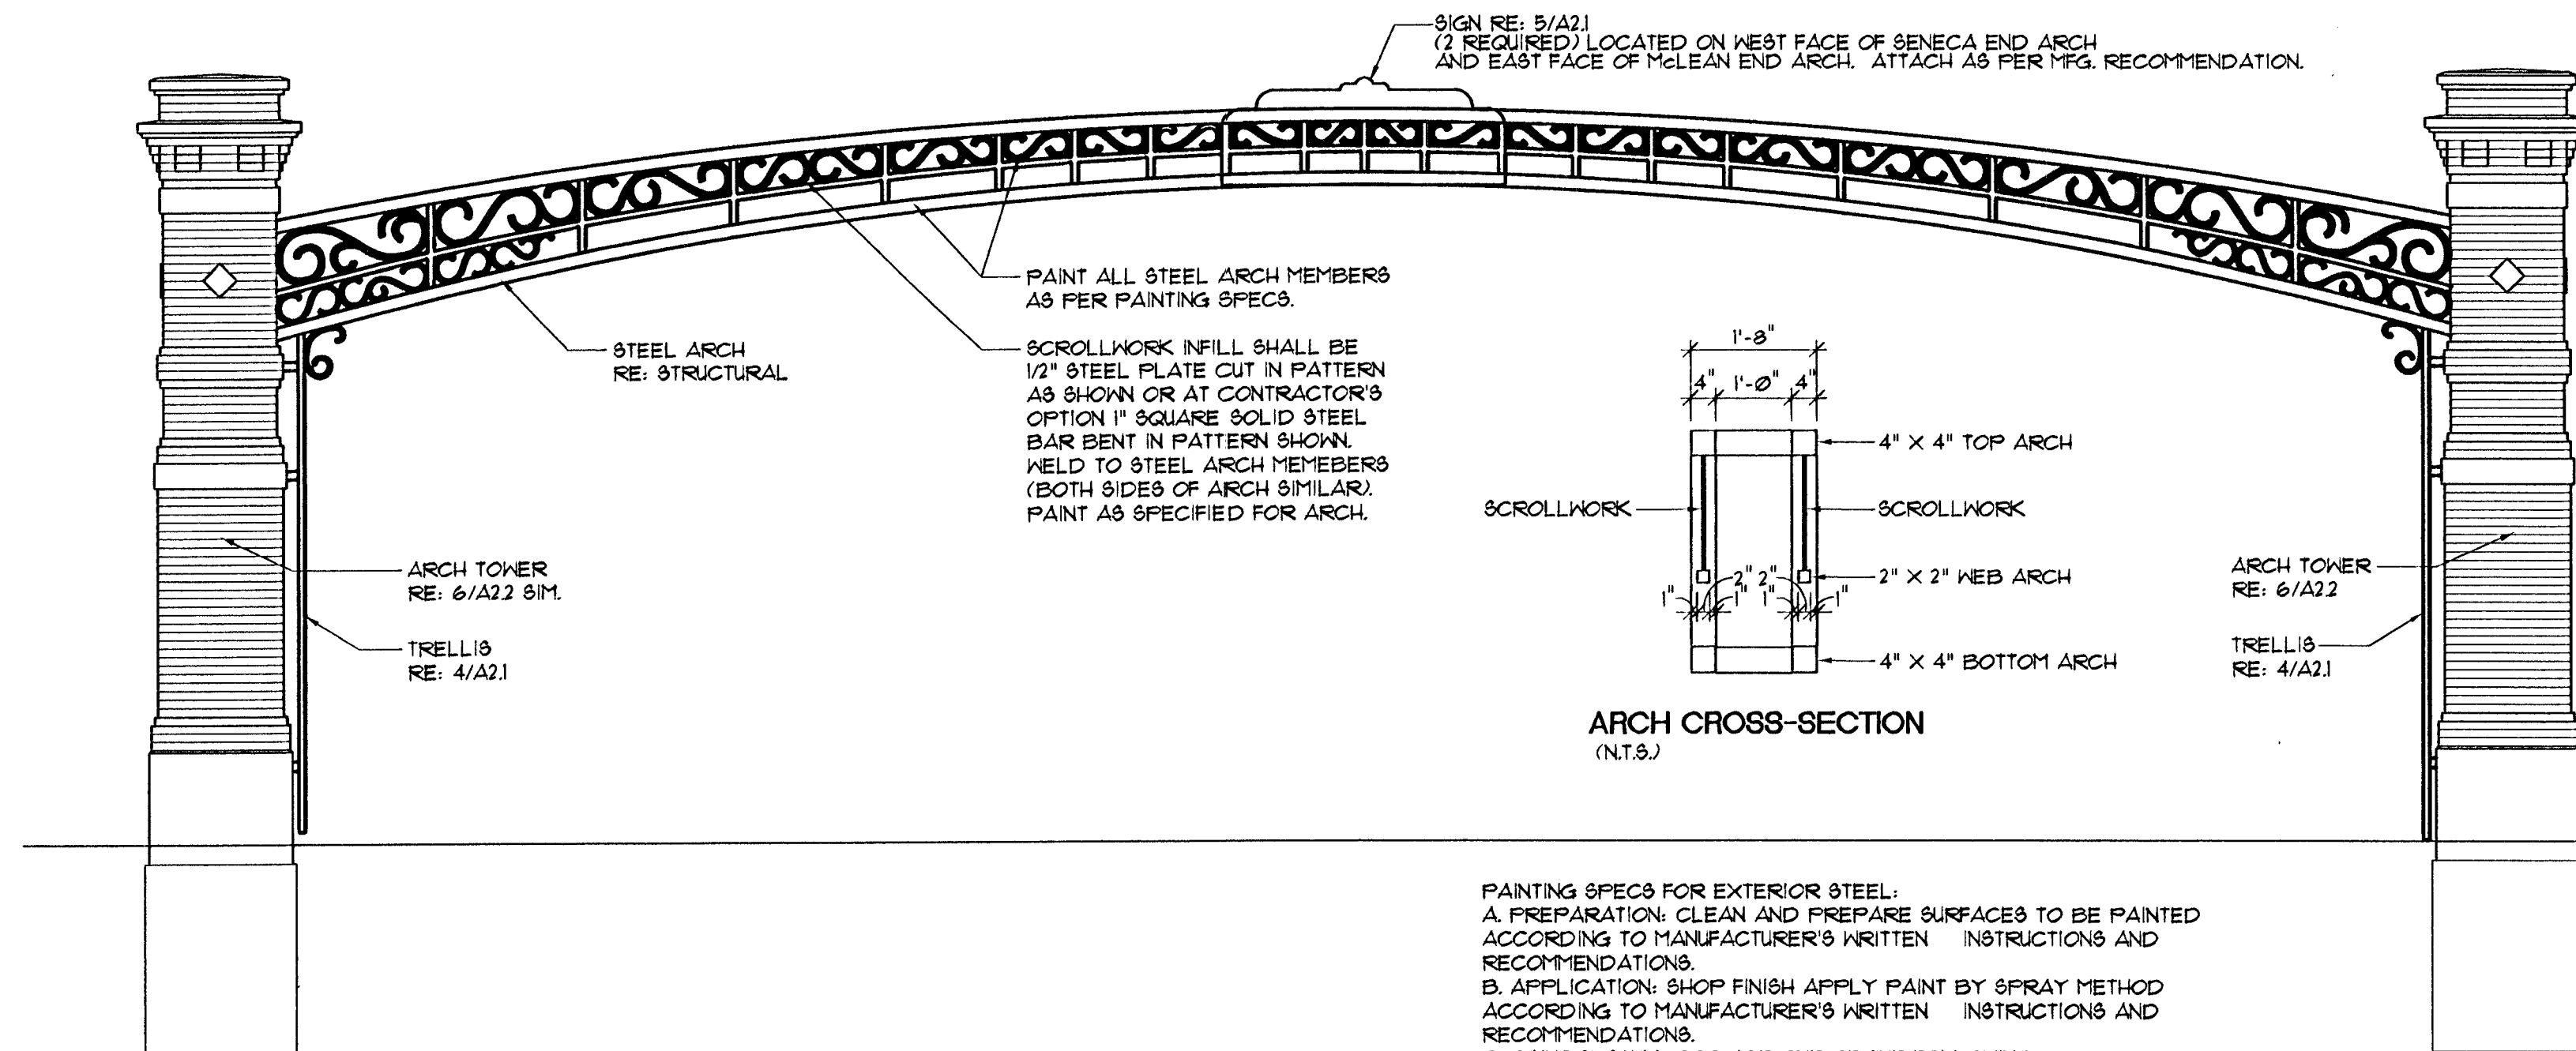

1 ARCH ELEVATION (ALT. #3)
(2 REQUIRED) SCALE: 1/4" = 1'-0"


NOTE: ALTERNATE #3 INCLUDES ARCH, TOWERS, SIGNS, TRELLISES, LIGHTING OF ARCH, AND PLANTINGS AT TOWERS. SEE SPECS FOR DISCUSSION.
NOTE: EXCAVATION FOR FOOTINGS SHALL BE SUBSIDIARY TO ENTRY ARCH.

PAINTING SPECS FOR EXTERIOR STEEL:
A. PREPARATION: CLEAN AND PREPARE SURFACES TO BE PAINTED ACCORDING TO MANUFACTURER'S WRITTEN INSTRUCTIONS AND RECOMMENDATIONS.
B. APPLICATION: SHOP FINISH APPLY PAINT BY SPRAY METHOD ACCORDING TO MANUFACTURER'S WRITTEN INSTRUCTIONS AND RECOMMENDATIONS.
C. PAINT SYSTEM: PROVIDE ONE OF THE FOLLOWING:
1. BENJAMIN MOORE ALIPHATIC URETHANE SYSTEM.
a. 1ST COAT: UNIVERSAL METAL PRIMER #101.
b. TWO FINISH COATS: 2-PART URETHANE #114-15, GLOSS.
2. SHERWIN WILLIAMS ACRYLIC POLYURETHANE SYSTEM.
a. 1ST COAT: RECOATABLE EPOXY PRIMER.
b. TWO FINISH COATS: ACRYLON 918 H8 (HIGH SOLIDS), GLOSS.
D. COLOR: BLACK.

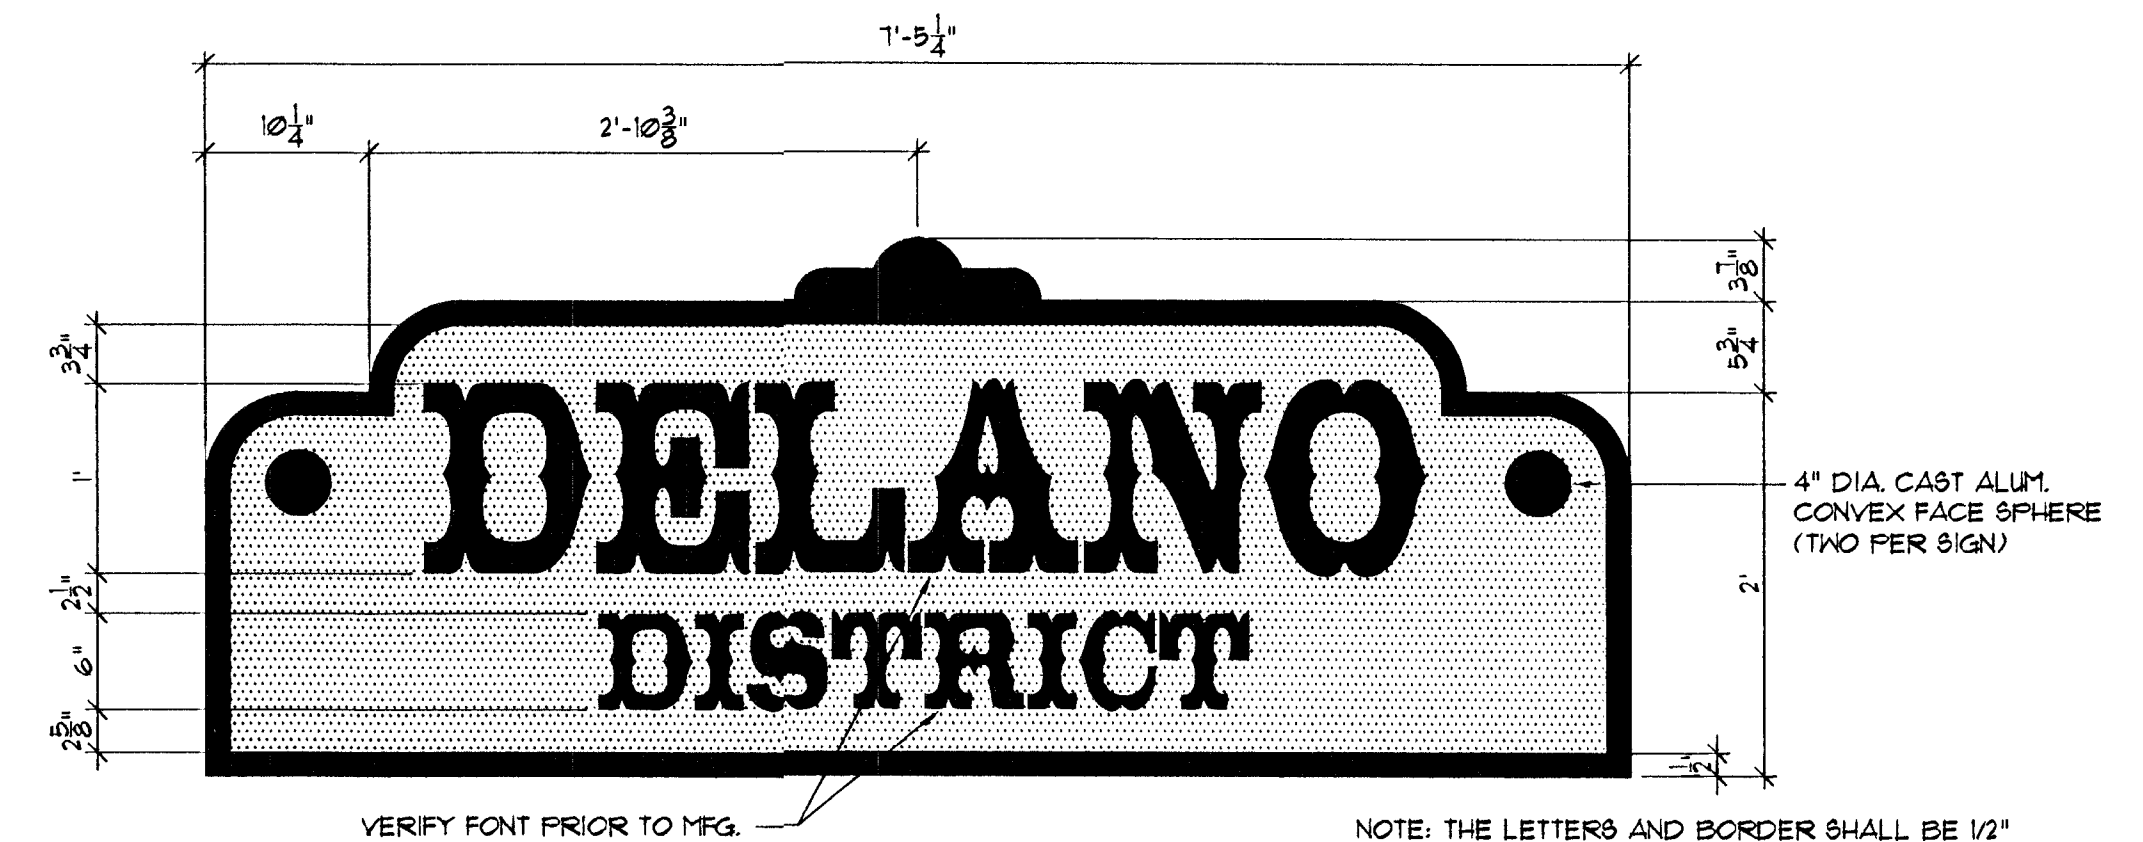


5 ARCH SIGN
(2 REQUIRED) SCALE: 1" = 1'-0"


Did not Build

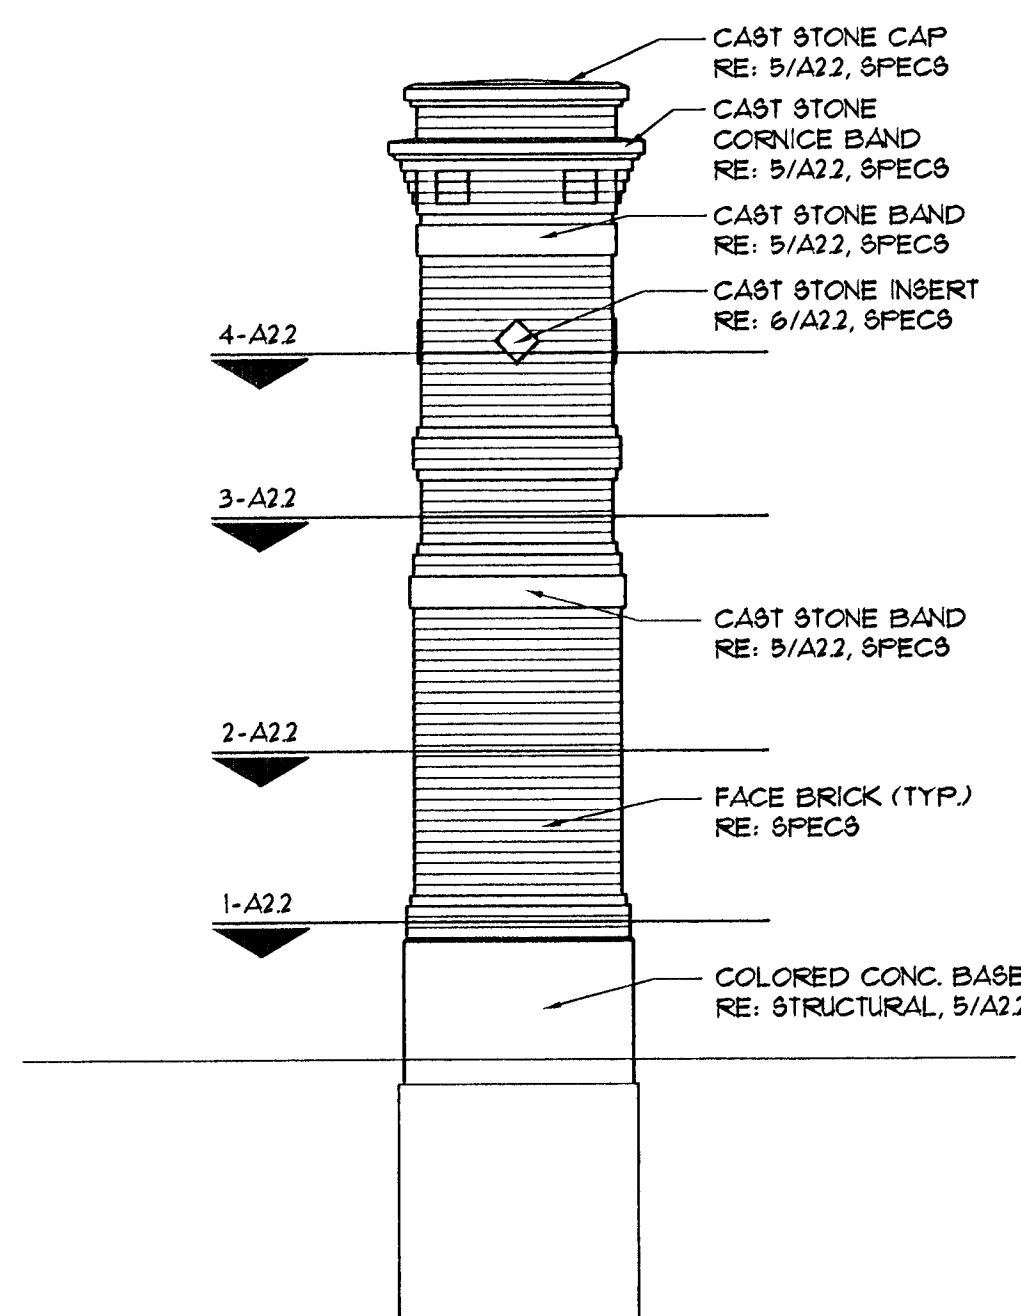

2 ARCH BUILDINGSIDE ELEVATION
SCALE: 1/4" = 1'-0"

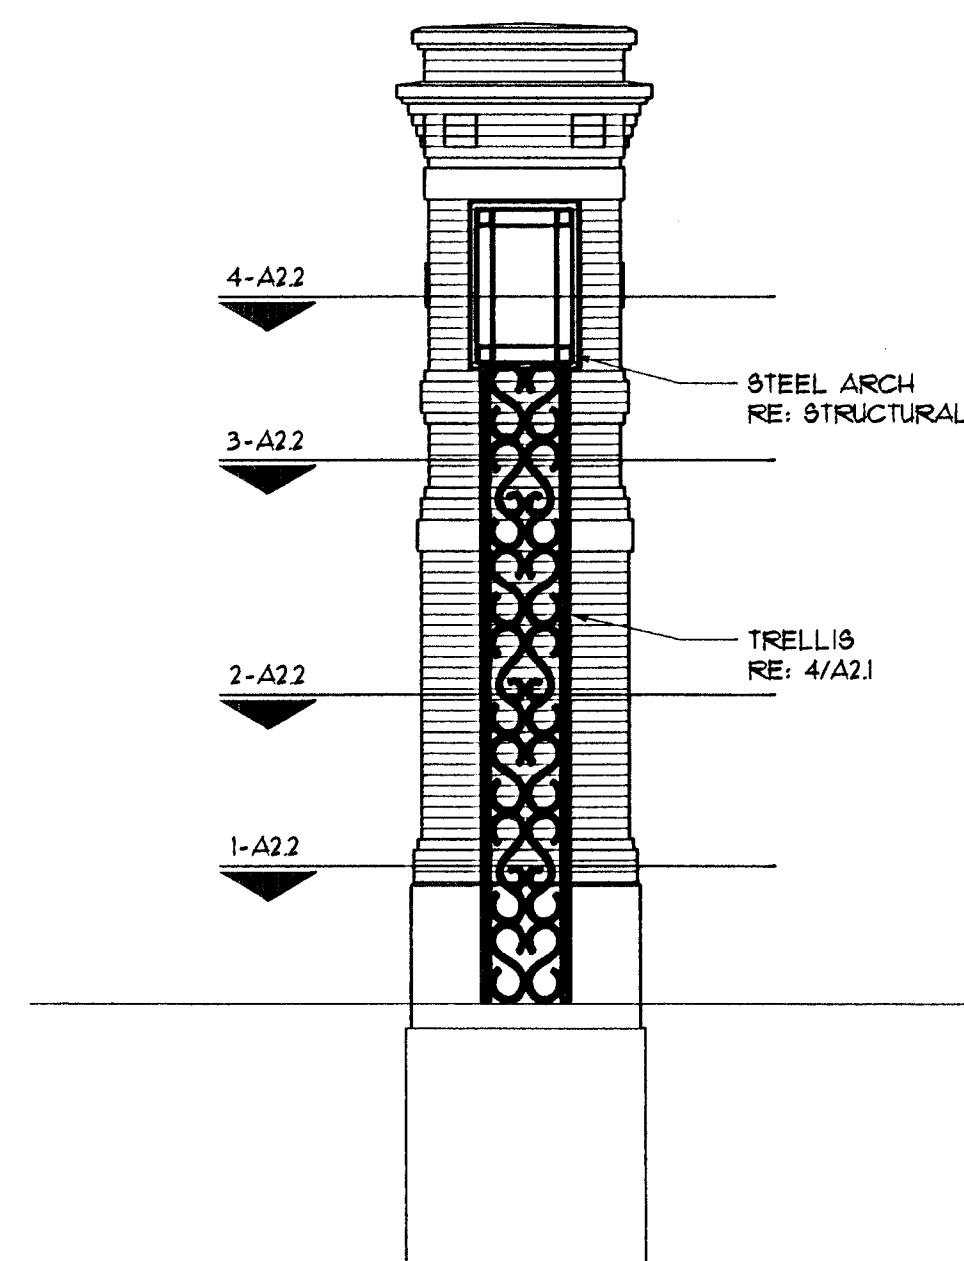

3 ARCH STREETSIDE ELEVATION
SCALE: 1/4" = 1'-0"

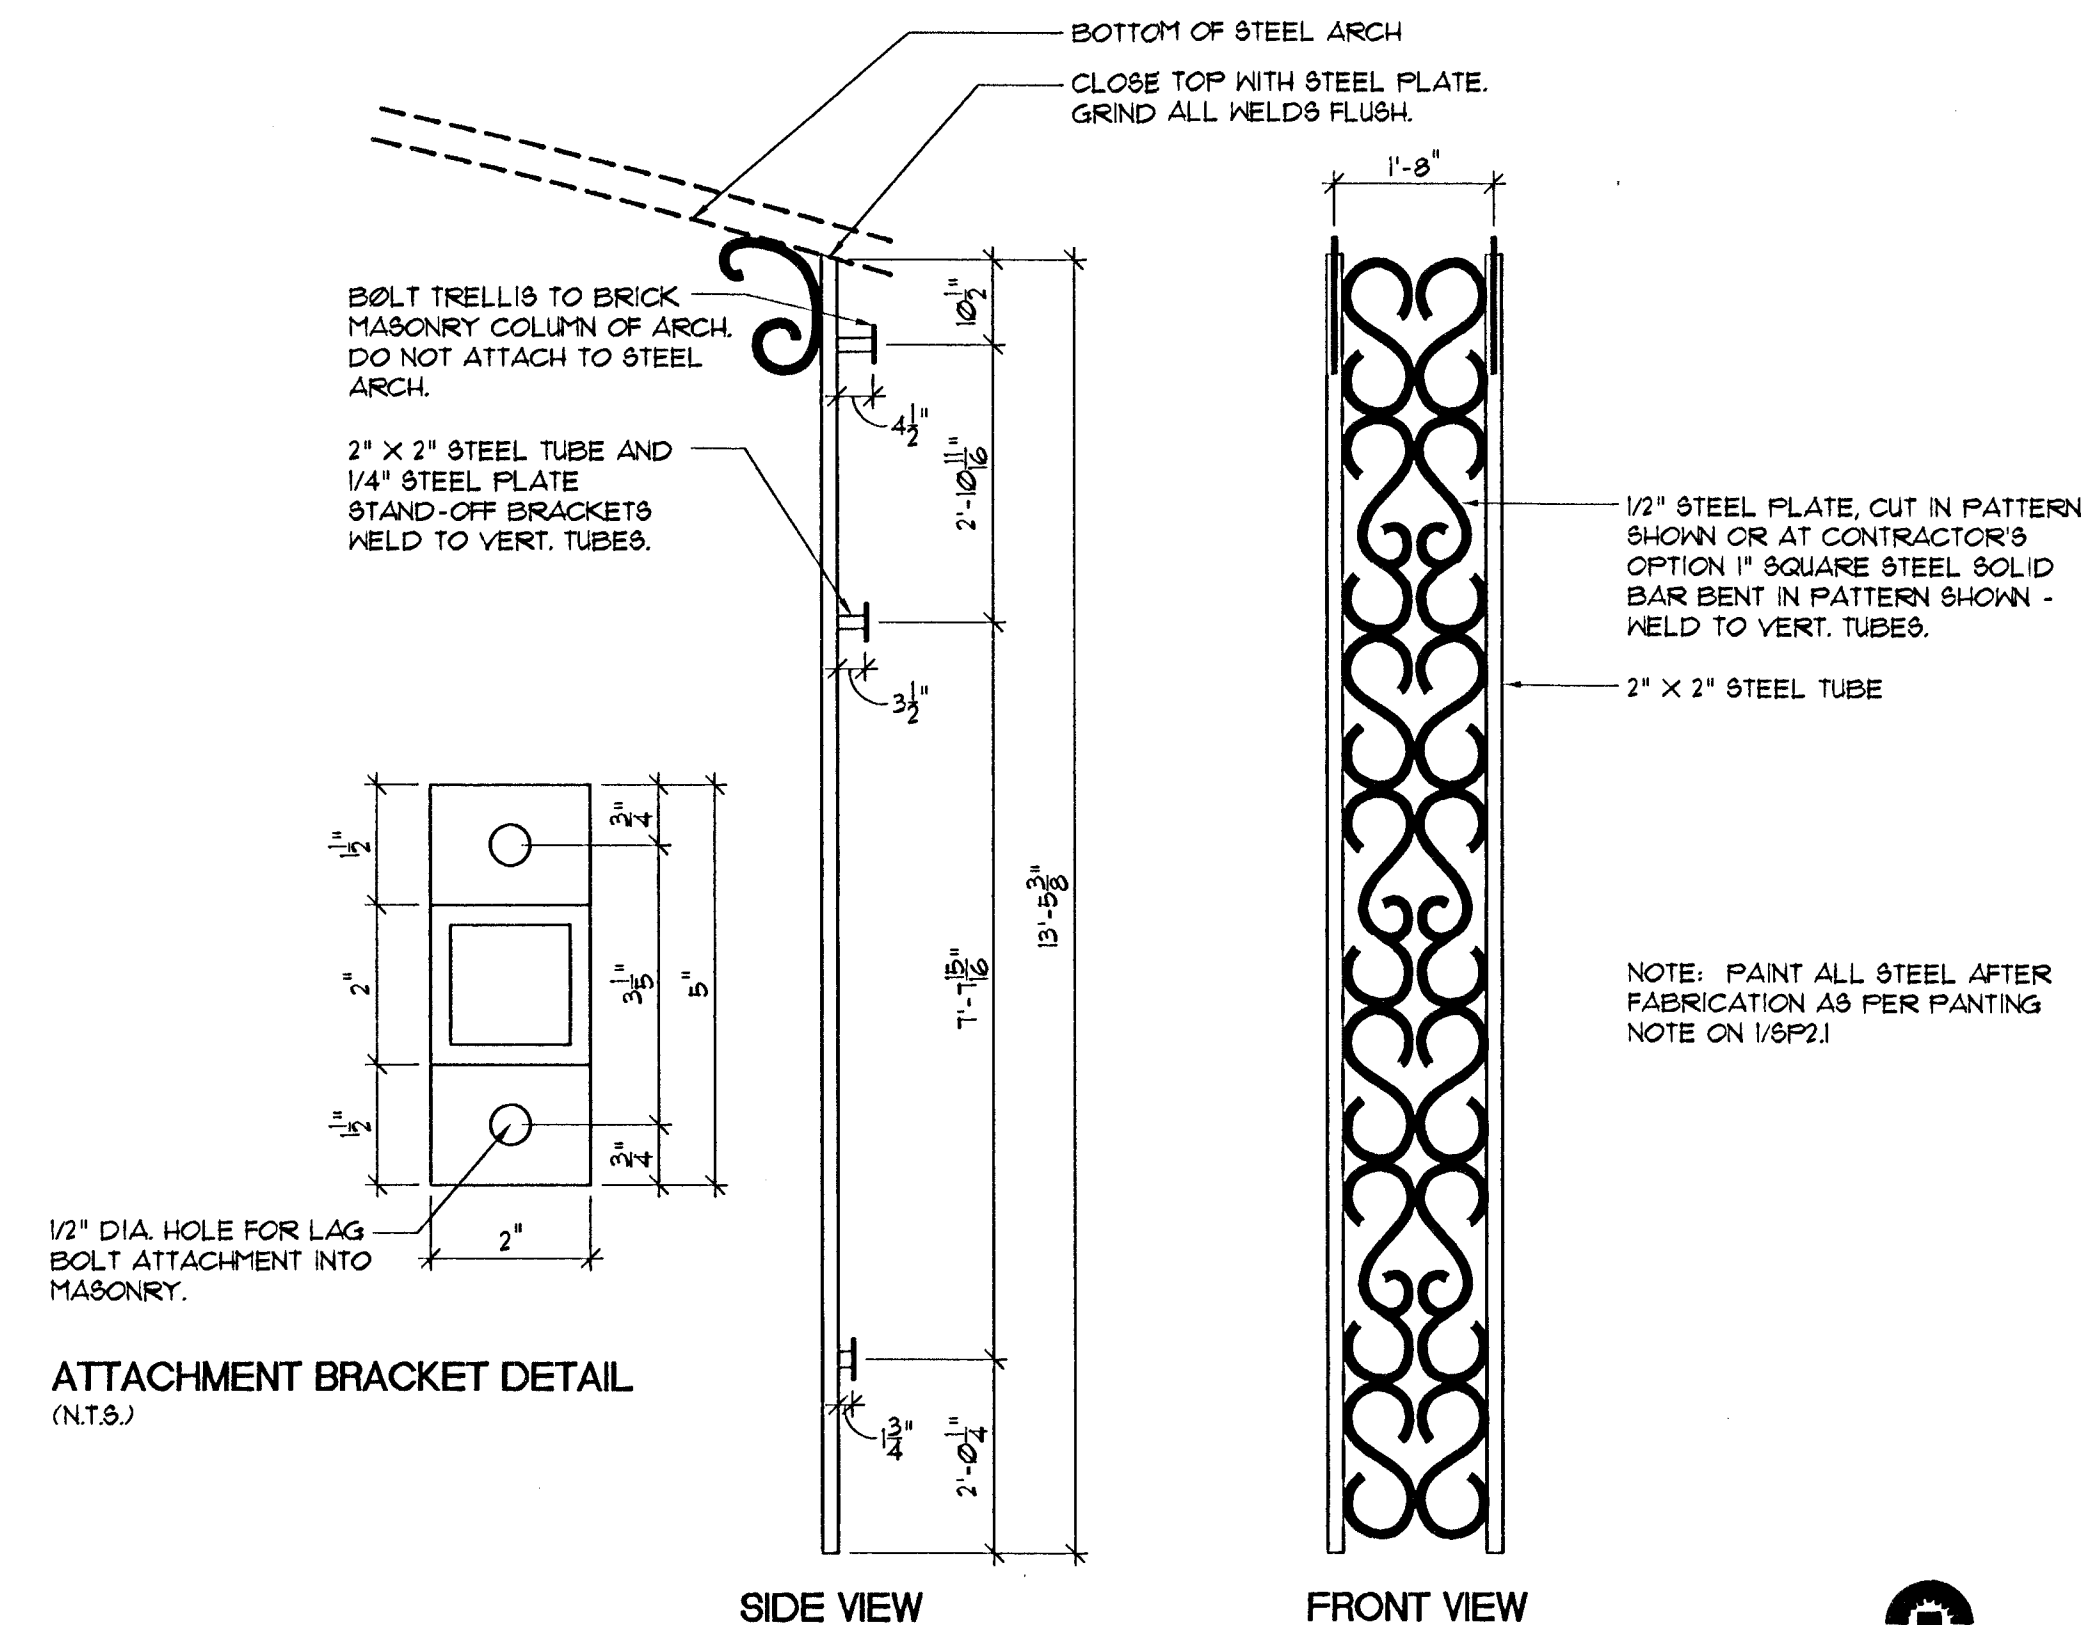

4 TRELLIS AT ARCH COLUMN
(4 REQUIRED) SCALE: 1/2" = 1'-0"



ARCH DETAILS