
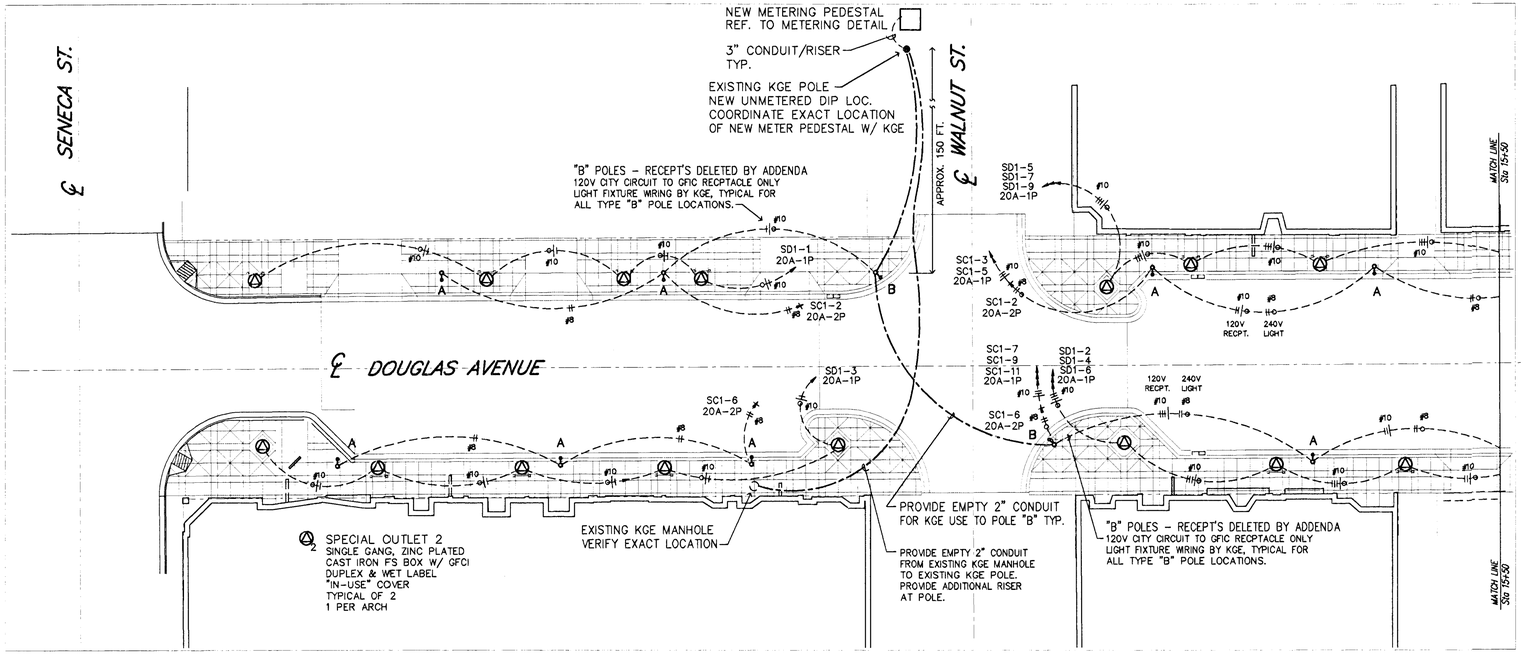


ELECTRICAL PLAN 1

1" = 30'

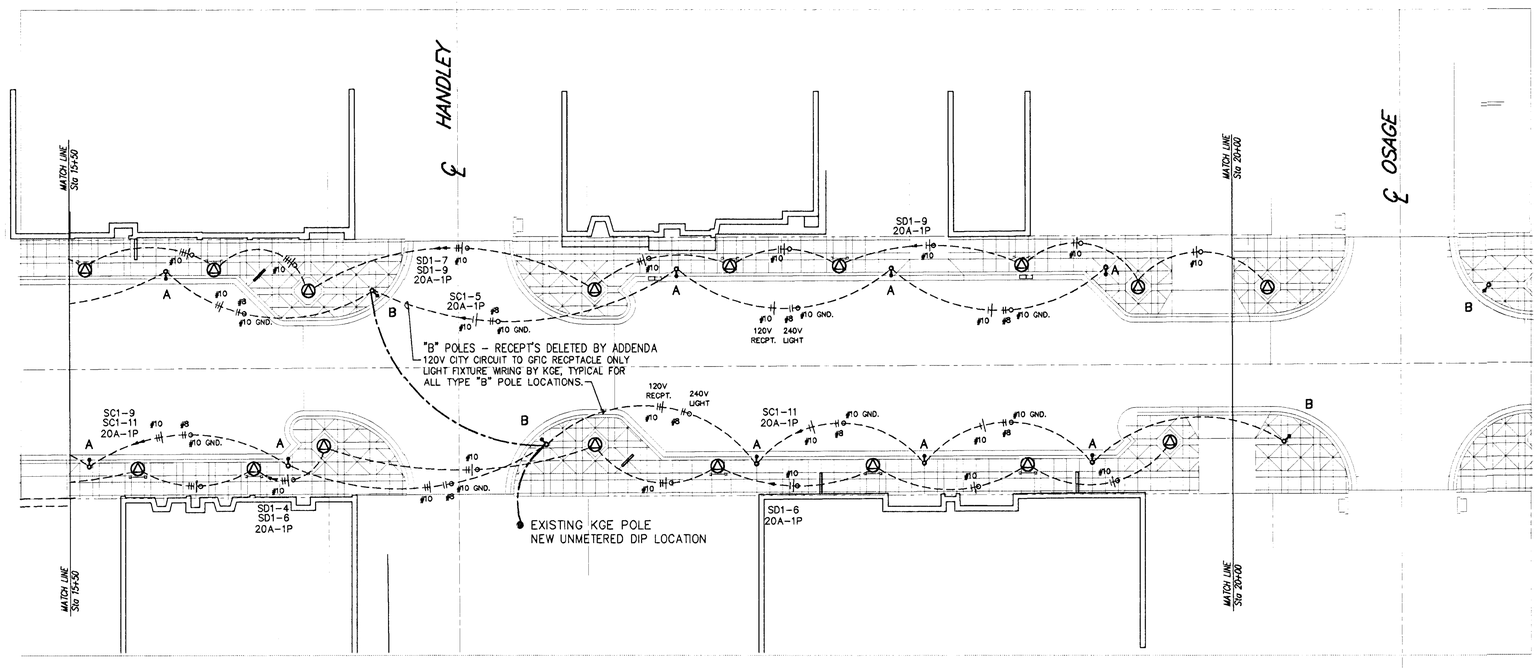

ELECTRICAL PLAN 2

1" = 30'

JOHNSON ENGINEERING
330 S. LAURA
WICHITA, KS 67211
(316) 264-1953
(316) 264-1956 FAX

McCLUGGAGE VAN SICKLE & PERRY
ARCHITECTS • PLANNERS • LANDSCAPE ARCHITECTS
125 S. WASHINGTON WICHITA, KANSAS 67202
P.O. BOX 346 WICHITA, KANSAS 67201
PH. 316/262-1443 • FAX 316/262-1445

WEST DOUGLAS STREETSCAPE
ARKANSAS RIVER TO SENECA
WICHITA, KANSAS

ELECTRICAL PLAN 1 and 2

CITY OF WICHITA

PROJECT NO. 472 83608
MVP PROJECT NO. 01008
JE PROJECT NO. 01006
DATE: AUGUST 1, 2002
REVISED:
REVISED CONST. SET:
FEBRUARY 1, 2003

SHEET

E1.2