

PROJECT NO.	YEAR	SHEET NO.	TOTAL SHEETS
		7	10

GENERAL NOTES





PRECAST BOX CULVERTS: If precast boxes are specified, construct them at the locations shown in the plans and according to the requirement shown on this sheet. When approved by the Engineer, precast box culverts may be used in lieu of cast-in-place box culverts. If the Contractor chooses the precast option, use the cast-in-place quantities as the cost basis. This cost includes all labor equipment, material and incidentals necessary to complete the installation.

Unless otherwise approved by the Engineer, use cast-in-place collars at horizontal and vertical changes in RCB alignment. Use cast-in-place end sections and wingwalls except as noted on this sheet. The Engineer may require cast-in-place sections at junctions of drainage structures.




Cast-in-place concrete work shall conform to the requirements of the KDOT Specifications and KDOT's 'Guidelines for Structural Design and Detail of Reinforced Concrete Box Culverts'. Use Class AAA concrete and Grade 60 reinforcing steel conforming to ASTM A615M for cast-in-place construction.

SPECIFICATIONS: Single-cell Precast Concrete Box Culverts shall conform to the requirements of the following specifications except as noted in the KDOT Specifications. Design multiple-cell precast boxes in accordance with the criteria used to develop the single-cell precast boxes. (See Appendices of ASTM Specification C789M and C850M and the latest AASHTO Specifications.)

Condition	Min. Fill	AASHTO	Equiv. ASTM
> 2'-0" fill	2'-0"	M259, Table 2	C789, Table 2
< 2'-0" fill	0	M273, Table 2	C850, Table 2

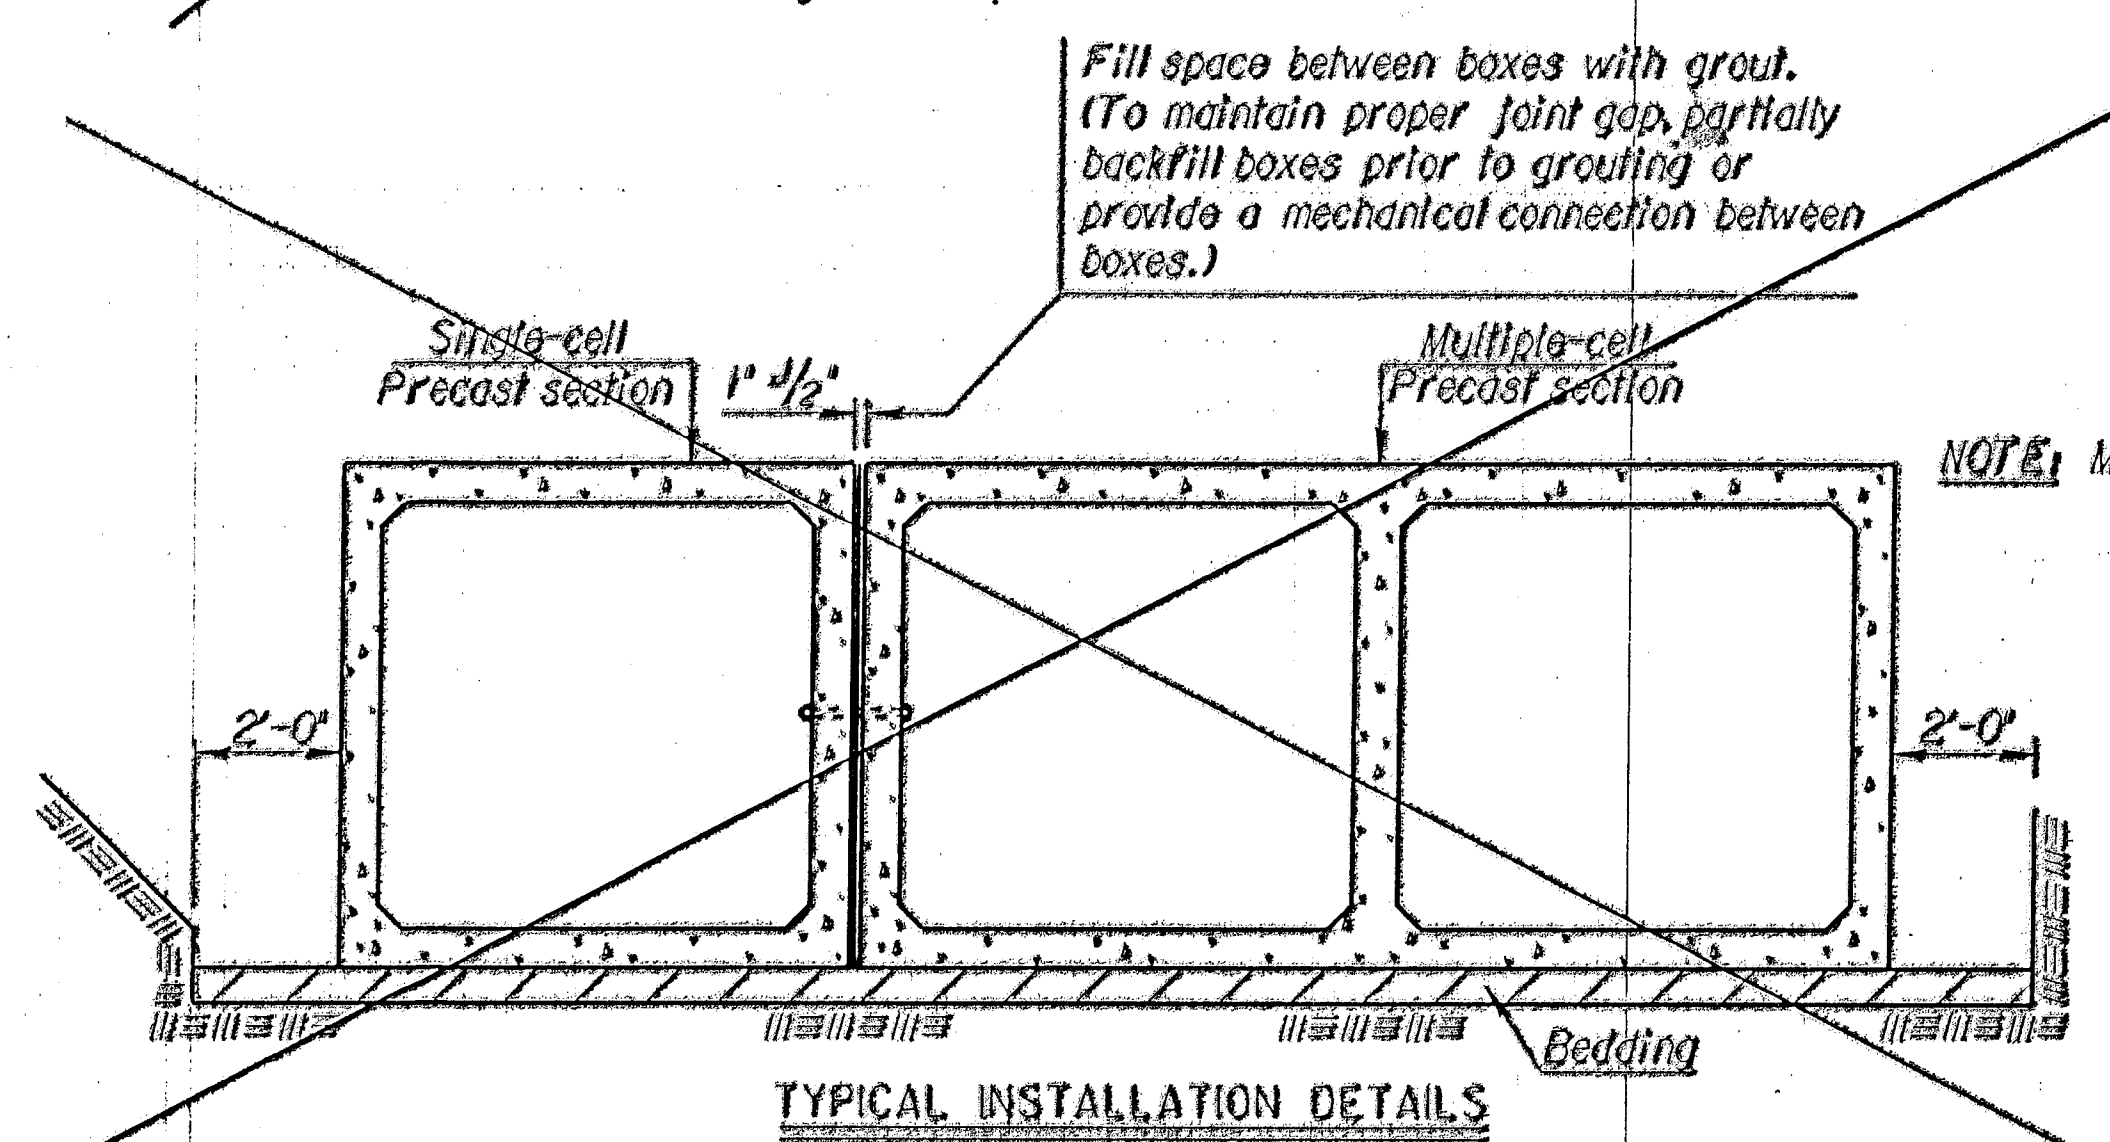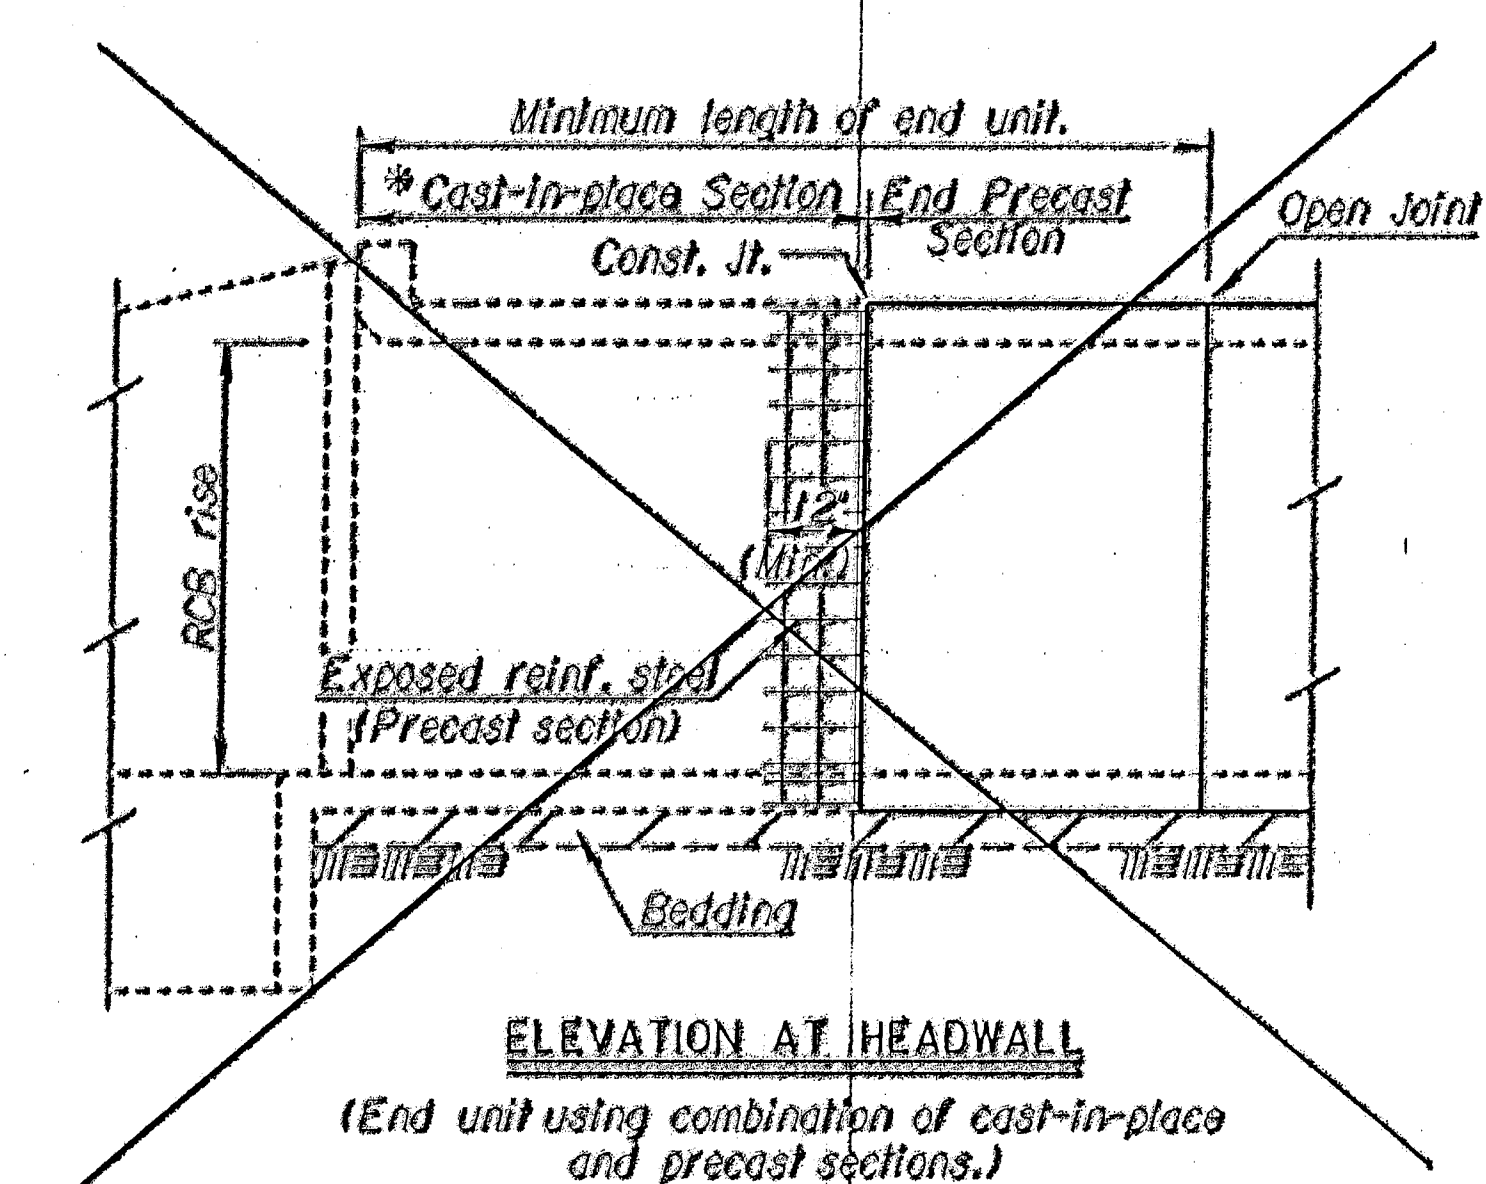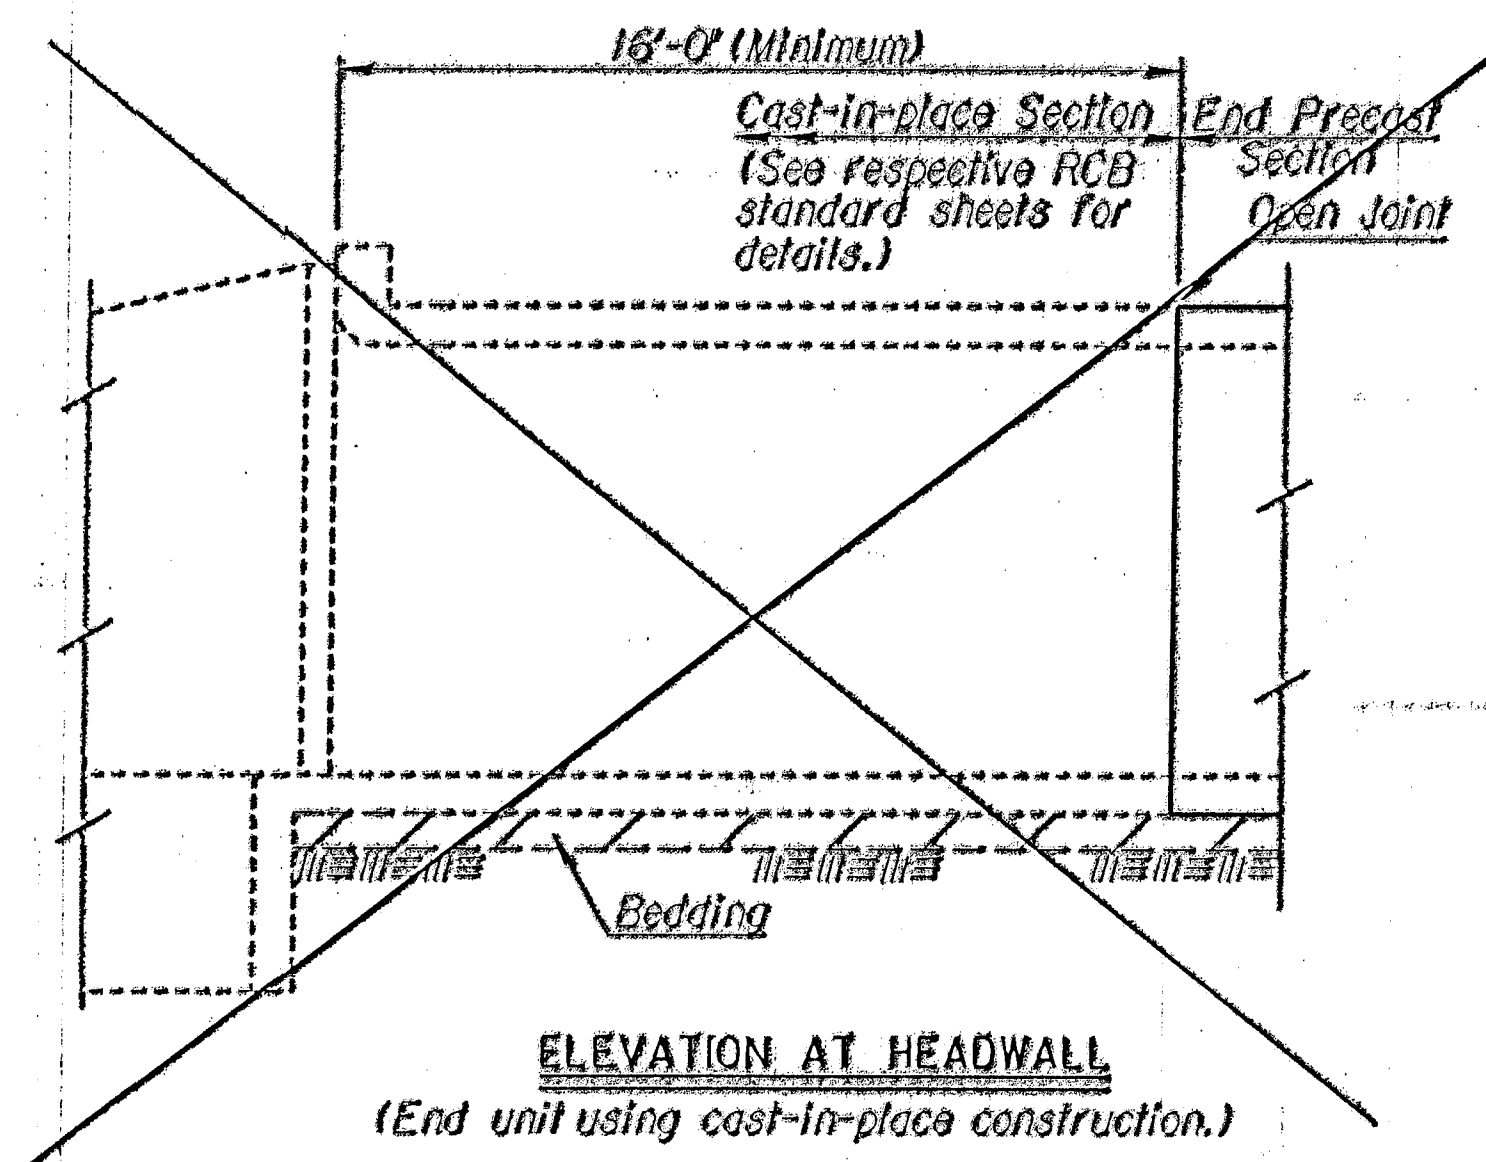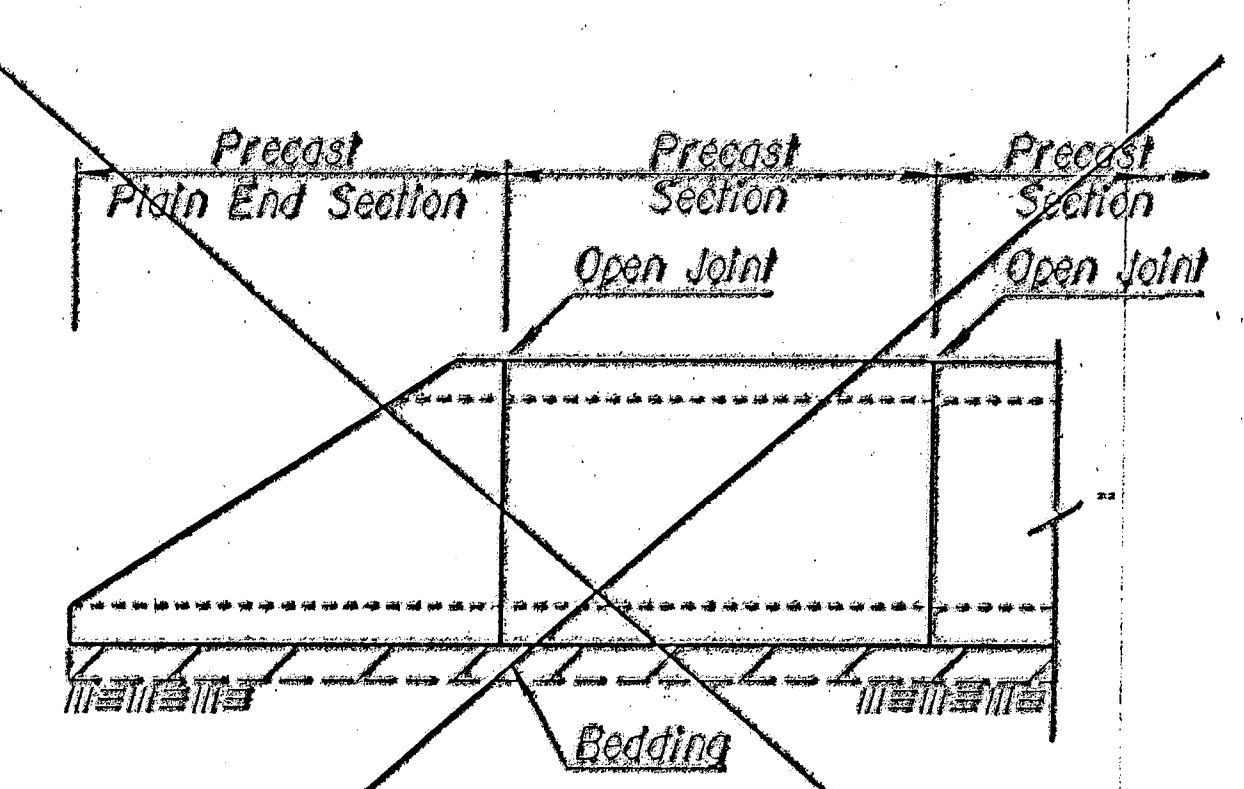

NOTE: Minimum length of precast section shall be 4'-0".

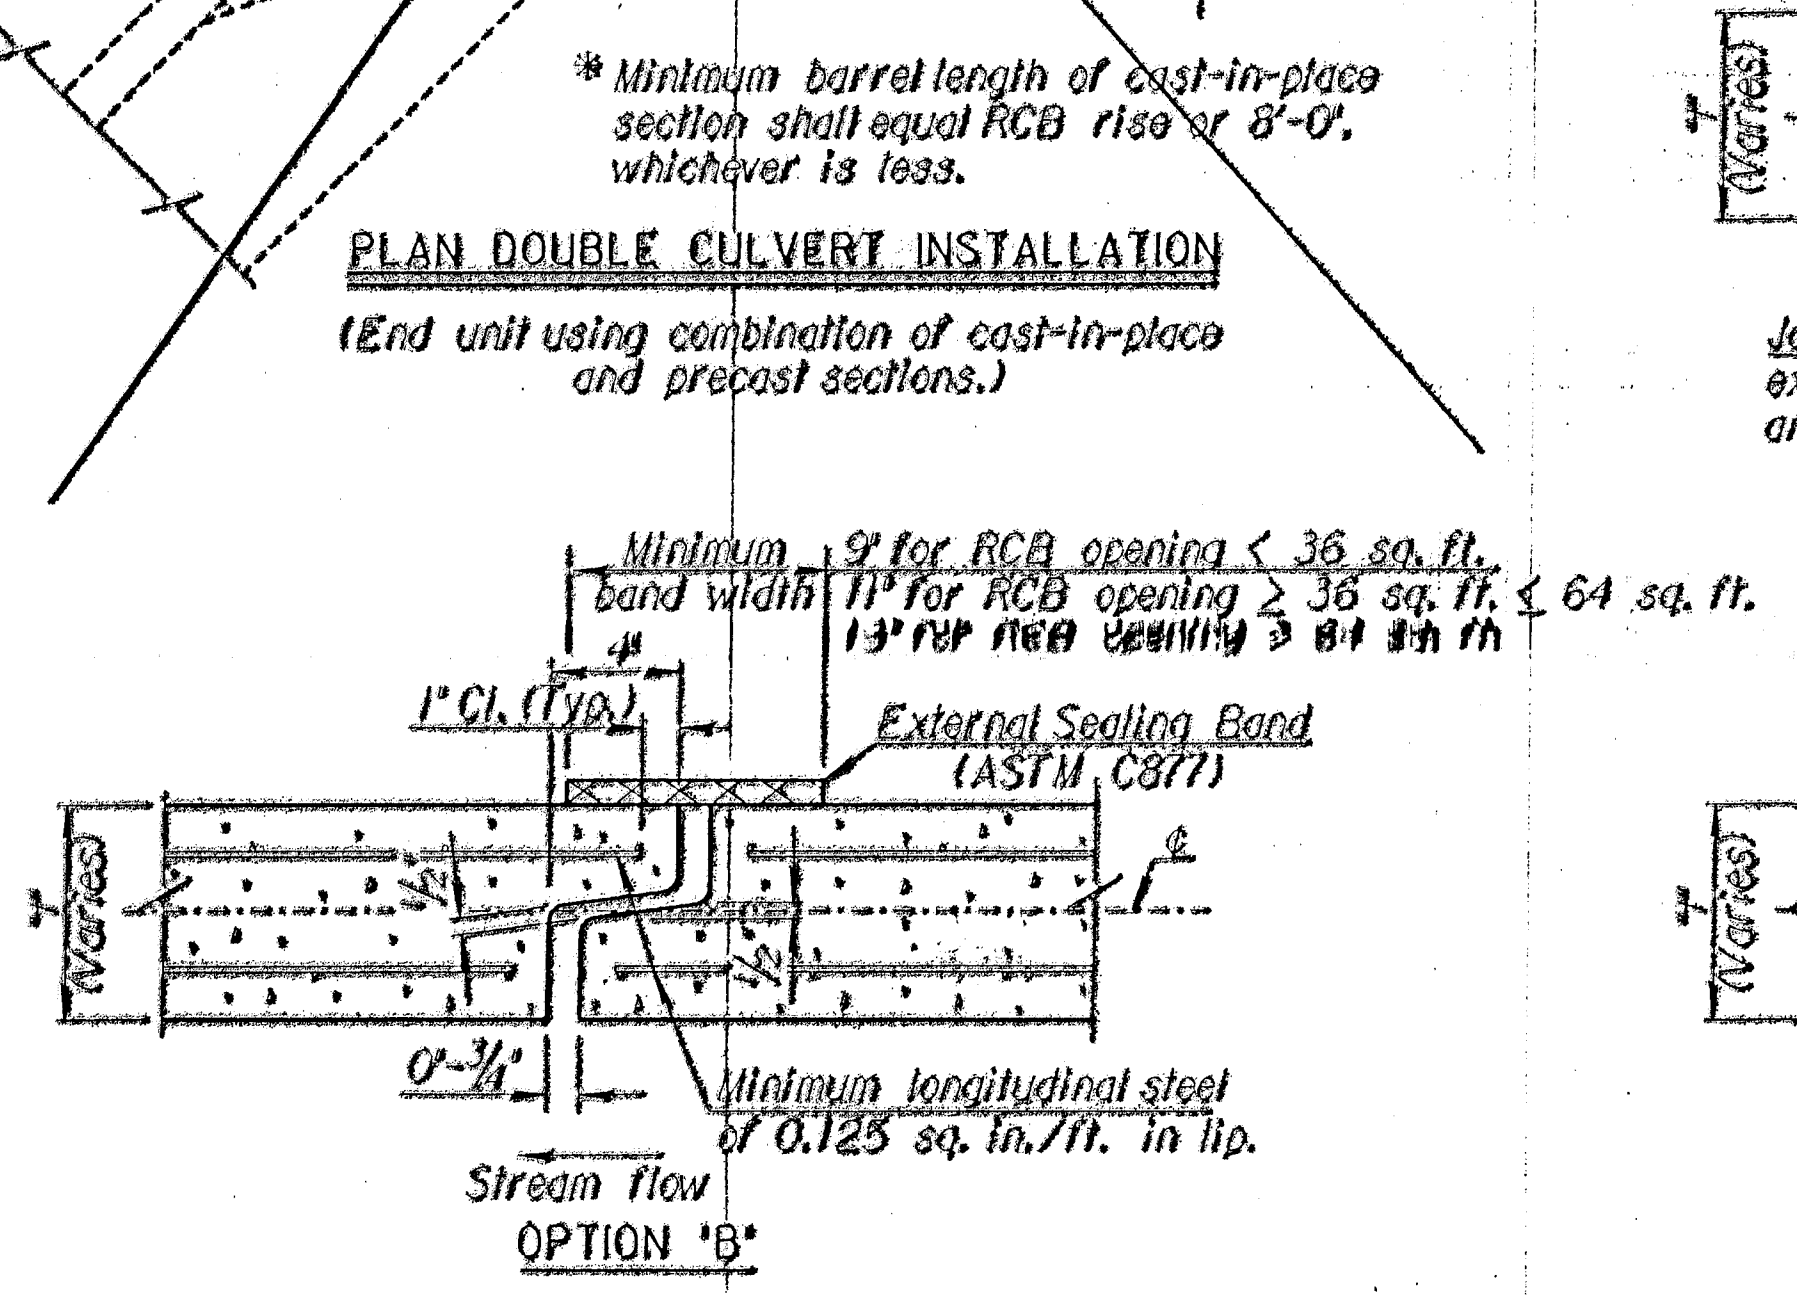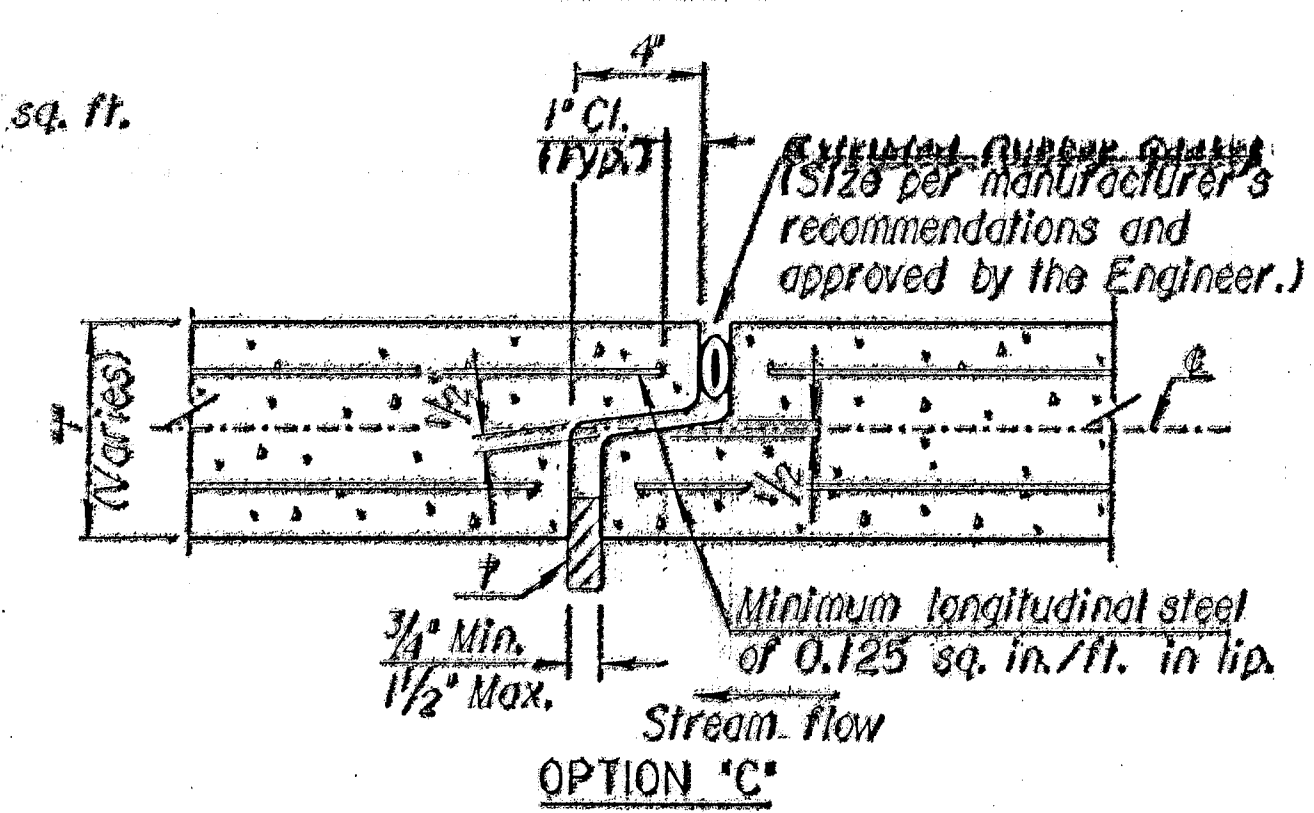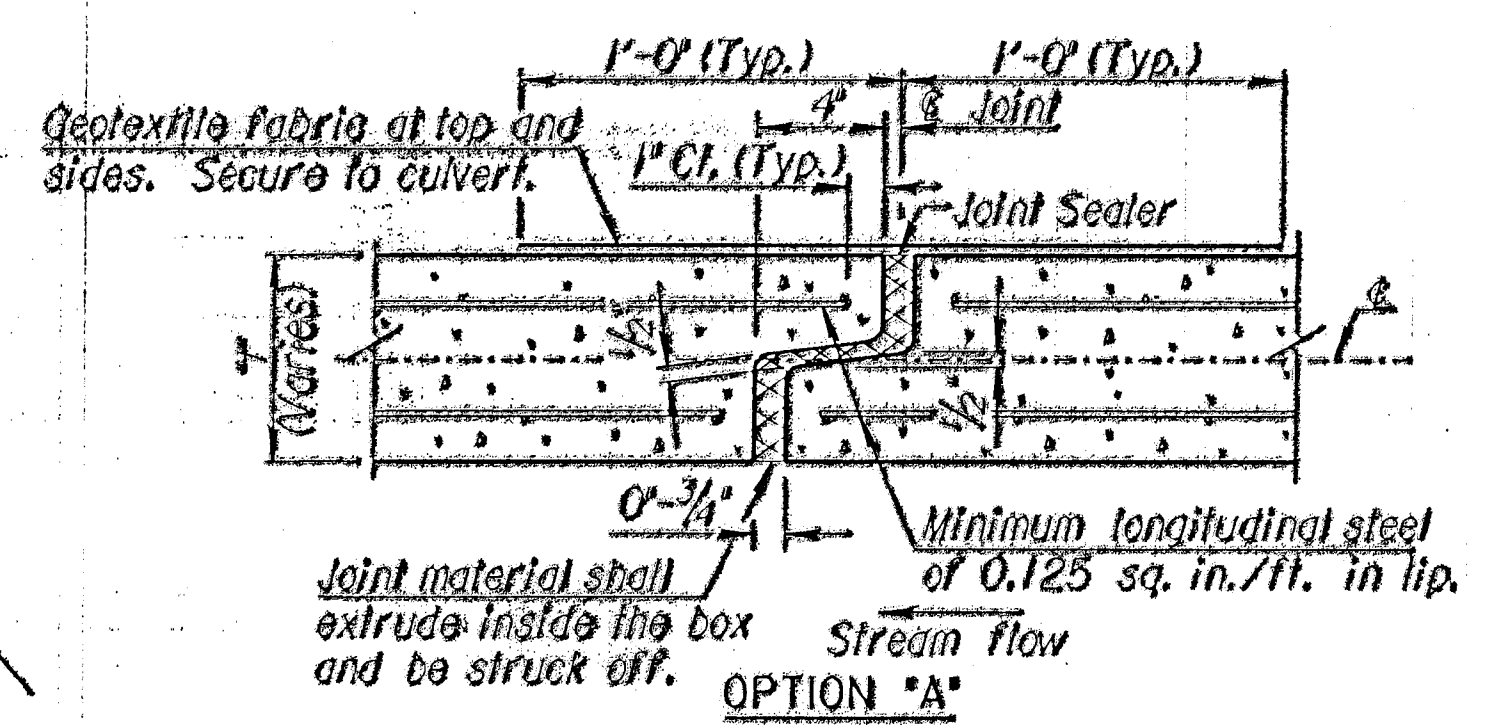

PLAN DOUBLE CULVERT INSTALLATION

(End unit using combination of cast-in-place and precast sections.)

OPEN JOINT DETAIL

* Insert temporary, 3/4"-1" wide, hardwood wedges to prevent over-compressing gasket.

NO.	DATE	REVISIONS	BY	APP'D
4	1-17-95	Revised general notes	LRR	KFH
3	8-22-94	Added option 'C' & revised notes	RAM	KFH
2	3-1-93	Revised general notes	RAM	KFH
1	3-1-92	Revised general notes & detail notes	RAM	KFH

KANSAS DEPARTMENT OF TRANSPORTATION

PRECAST CONCRETE BOX CULVERT DETAILS

DESIGNED BY	DESIGNED BY	DESIGNED BY	DESIGNED BY

Plotted By: DJE
Plot Date: 11-25-00
Server: wch
View: PLOT7