


NOTES:

1. CONTRACTOR TO VERIFY THE DEPTH AND LOCATION OF EXISTING UTILITIES PRIOR TO CONSTRUCTION.
2. CONTRACTOR SHALL REMOVE SILT & DEBRIS FROM EXISTING STORM SEWER INLETS & FLUSH EXISTING PIPE. (COST SUBSIDIARY TO PIPE CONSTRUCTION.)

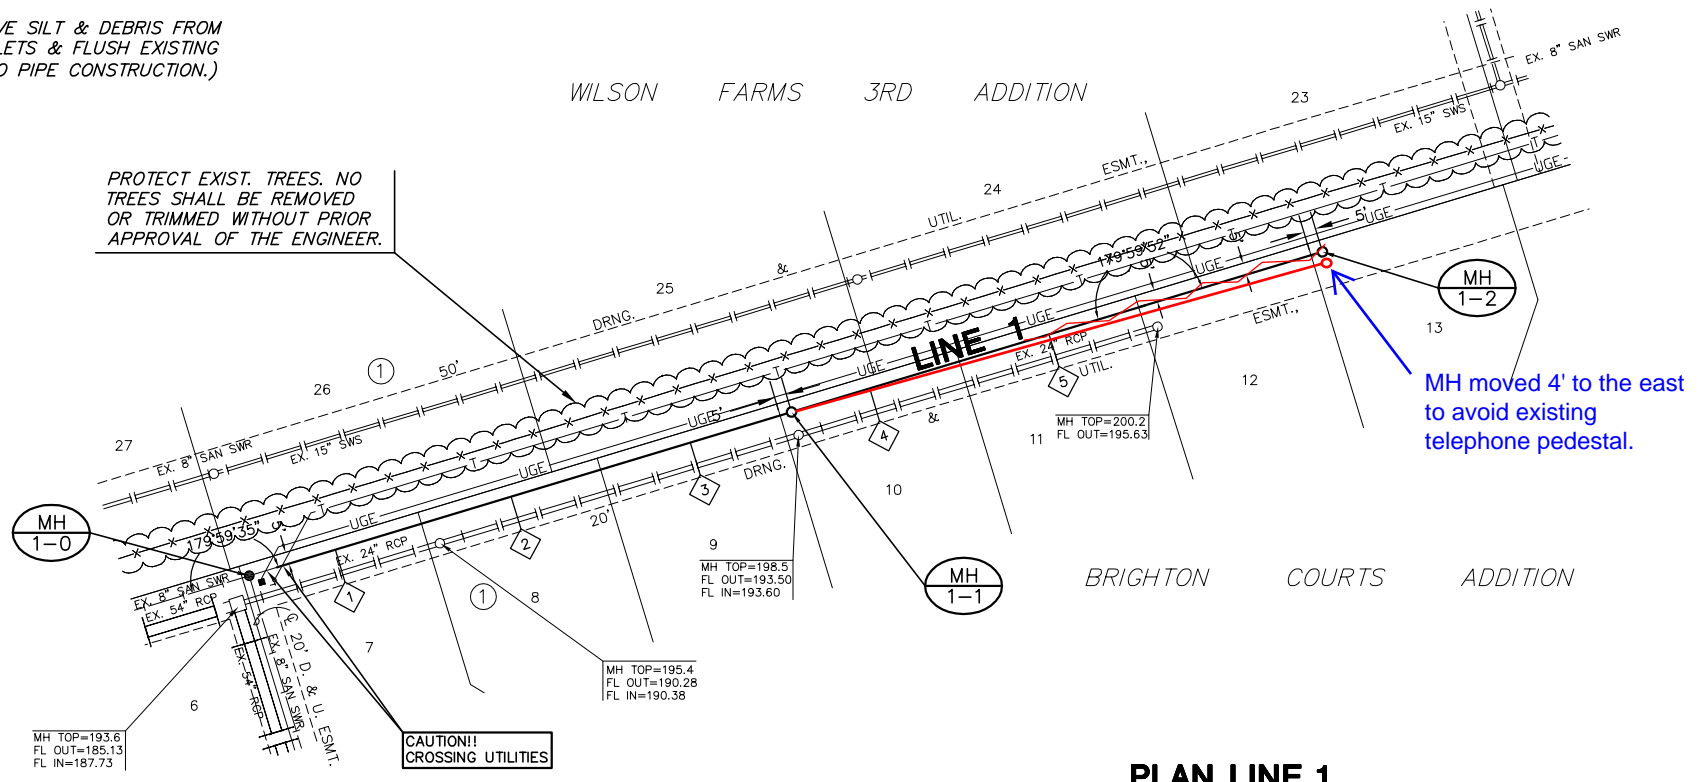


PROTECT EXIST. TREES. NO TREES SHALL BE REMOVED OR TRIMMED WITHOUT PRIOR APPROVAL OF THE ENGINEER.

MH moved 4' to the east to avoid existing telephone pedestal.

CAUTION!! CROSSING UTILITIES



BRIGHTON COURTS ADDITION

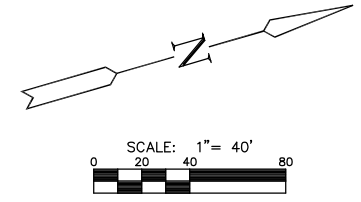

PLAN LINE 1

PROFILE LINE 1

SCALE: HORIZ. 1"=40'
SCALE: VERT. 1"=5'

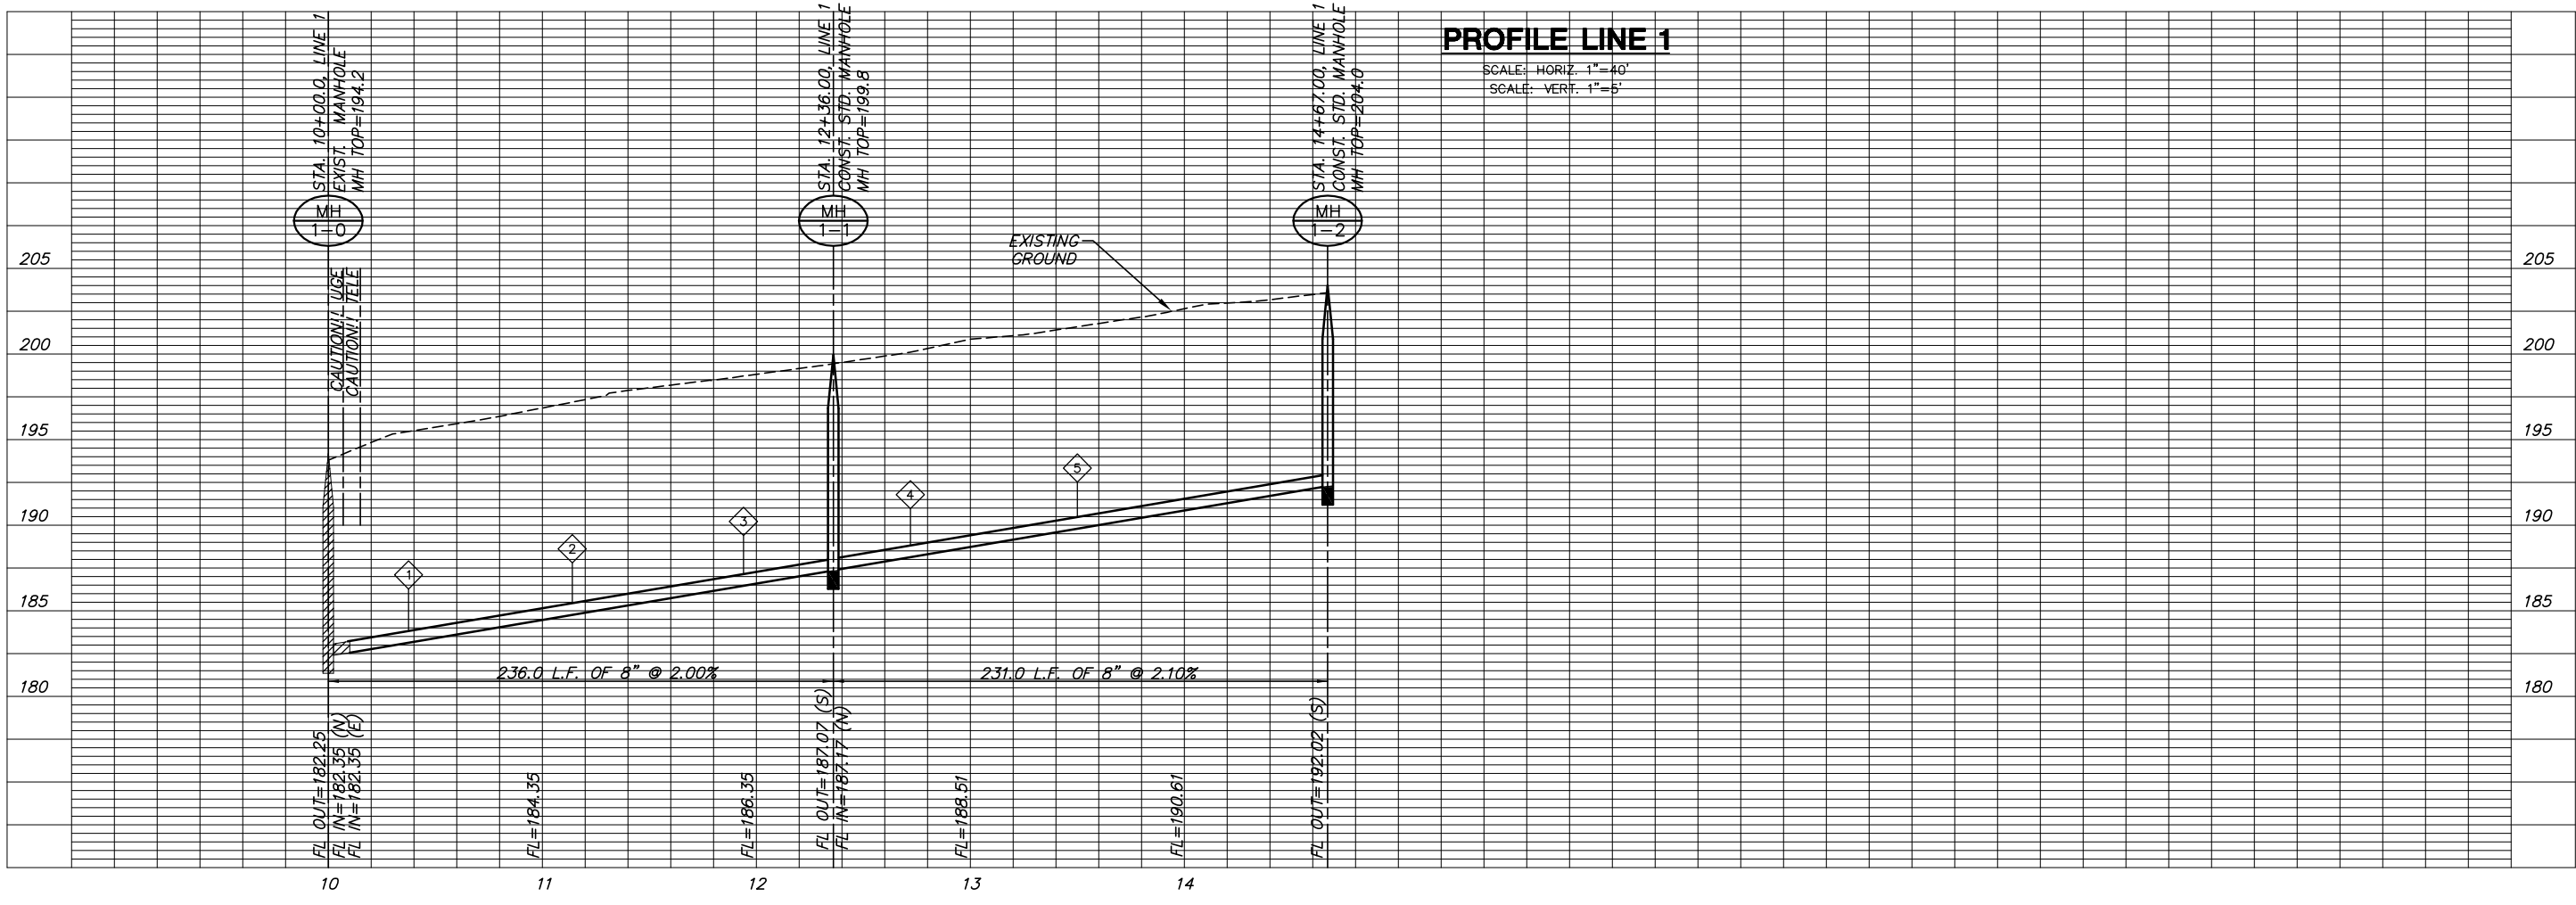

PLOTED: Thursday, July 20, 2006 @ 01:33PM

**SANITARY SEWER PLANS
BRIGHTON COURTS ADDITION
PHASE II**

LINE 1
SHEET TITLE
468-83673
PROJECT NUMBER

DESIGN BY: SRS
DRAWN BY: KWS
CHECKED BY: GJA

ISSUED: JUNE 2006
REVISED:

SHEET NO.
4 of 9