


Scale: 1" = 20'

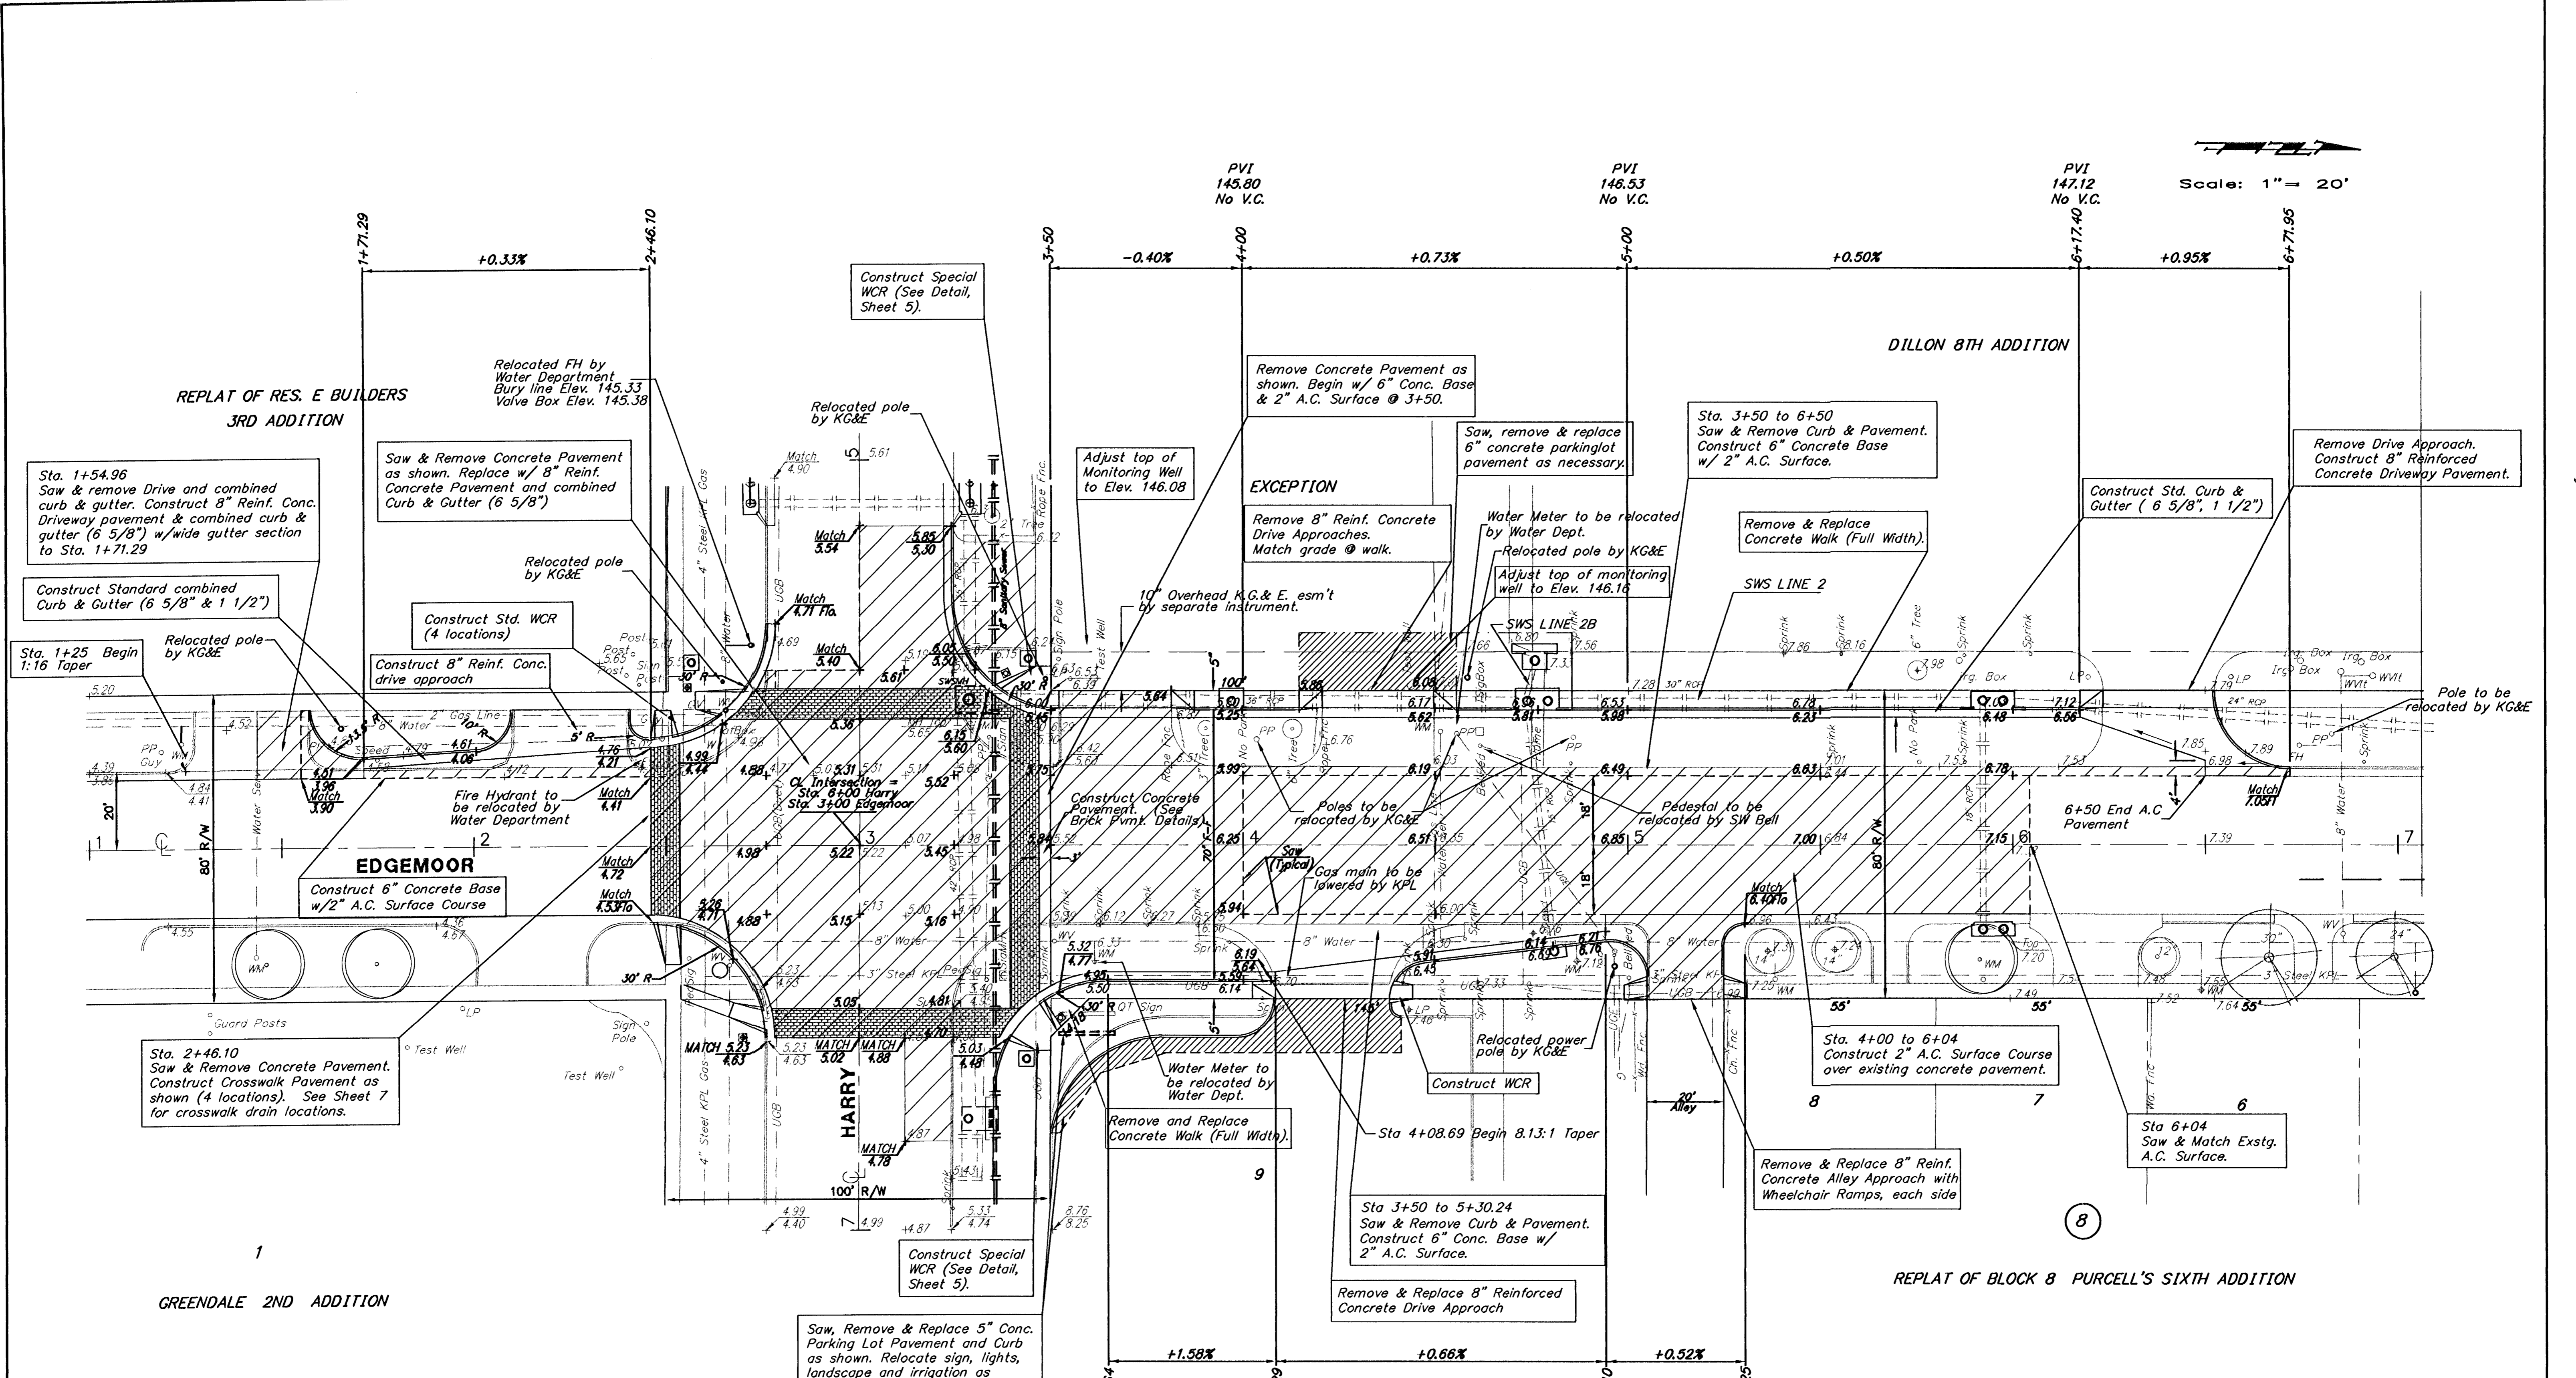

WATER VALVE BOX ADJUSTMENTS

| Sta. | Location | Exist. Elev. | Fin. Elev. |
|------|----------|--------------|------------|
| 2+60 | 31' Lt. | 144.95 | 144.90 |
| 2+65 | 35' Lt. | 145.04 | 144.45 |
| 3+51 | 25' Rt. | 145.35 | 145.15 |

REVISED 8-23-95 JKB
 Pavement Plan
EDGE MOOR STREET
 BAUGHMAN COMPANY P.A.
 ENGINEERING & SURVEYING
 316/262-7271 • 316 ELLIS • WICHITA, KANSAS 67211
 PROJECT NUMBER 468-82138 & 472-82668
 SHEET 6 OF 38
 DESIGN T.C.R. DRAWN Sonny UTIL. CHECKED T.C.R. DATE 10-29-92 SCALE 1" = 20'

Saw, Remove & Replace 5" Conc. Parking Lot Pavement and Curb as shown. Relocate sign, lights, landscape and irrigation as necessary for construction. See details, Sheet 4.

PVI 145.80 No V.C.

PVI 146.53 No V.C.

PVI 147.12 No V.C.

PVI 146.19 No V.C.

PVI 146.76 No V.C.