

GREENDALE 2ND ADDITION

EDGEMOOR

REPLAT OF RESERVE E - BUILDERS 3RD ADDITION



RESERVE J

PARKWOOD LN.

REPLAT OF RESERVES D AND E
BUILDER'S THIRD ADDITION

30

Scale: 1" = 20' Horz.
1" = 5' Vert.

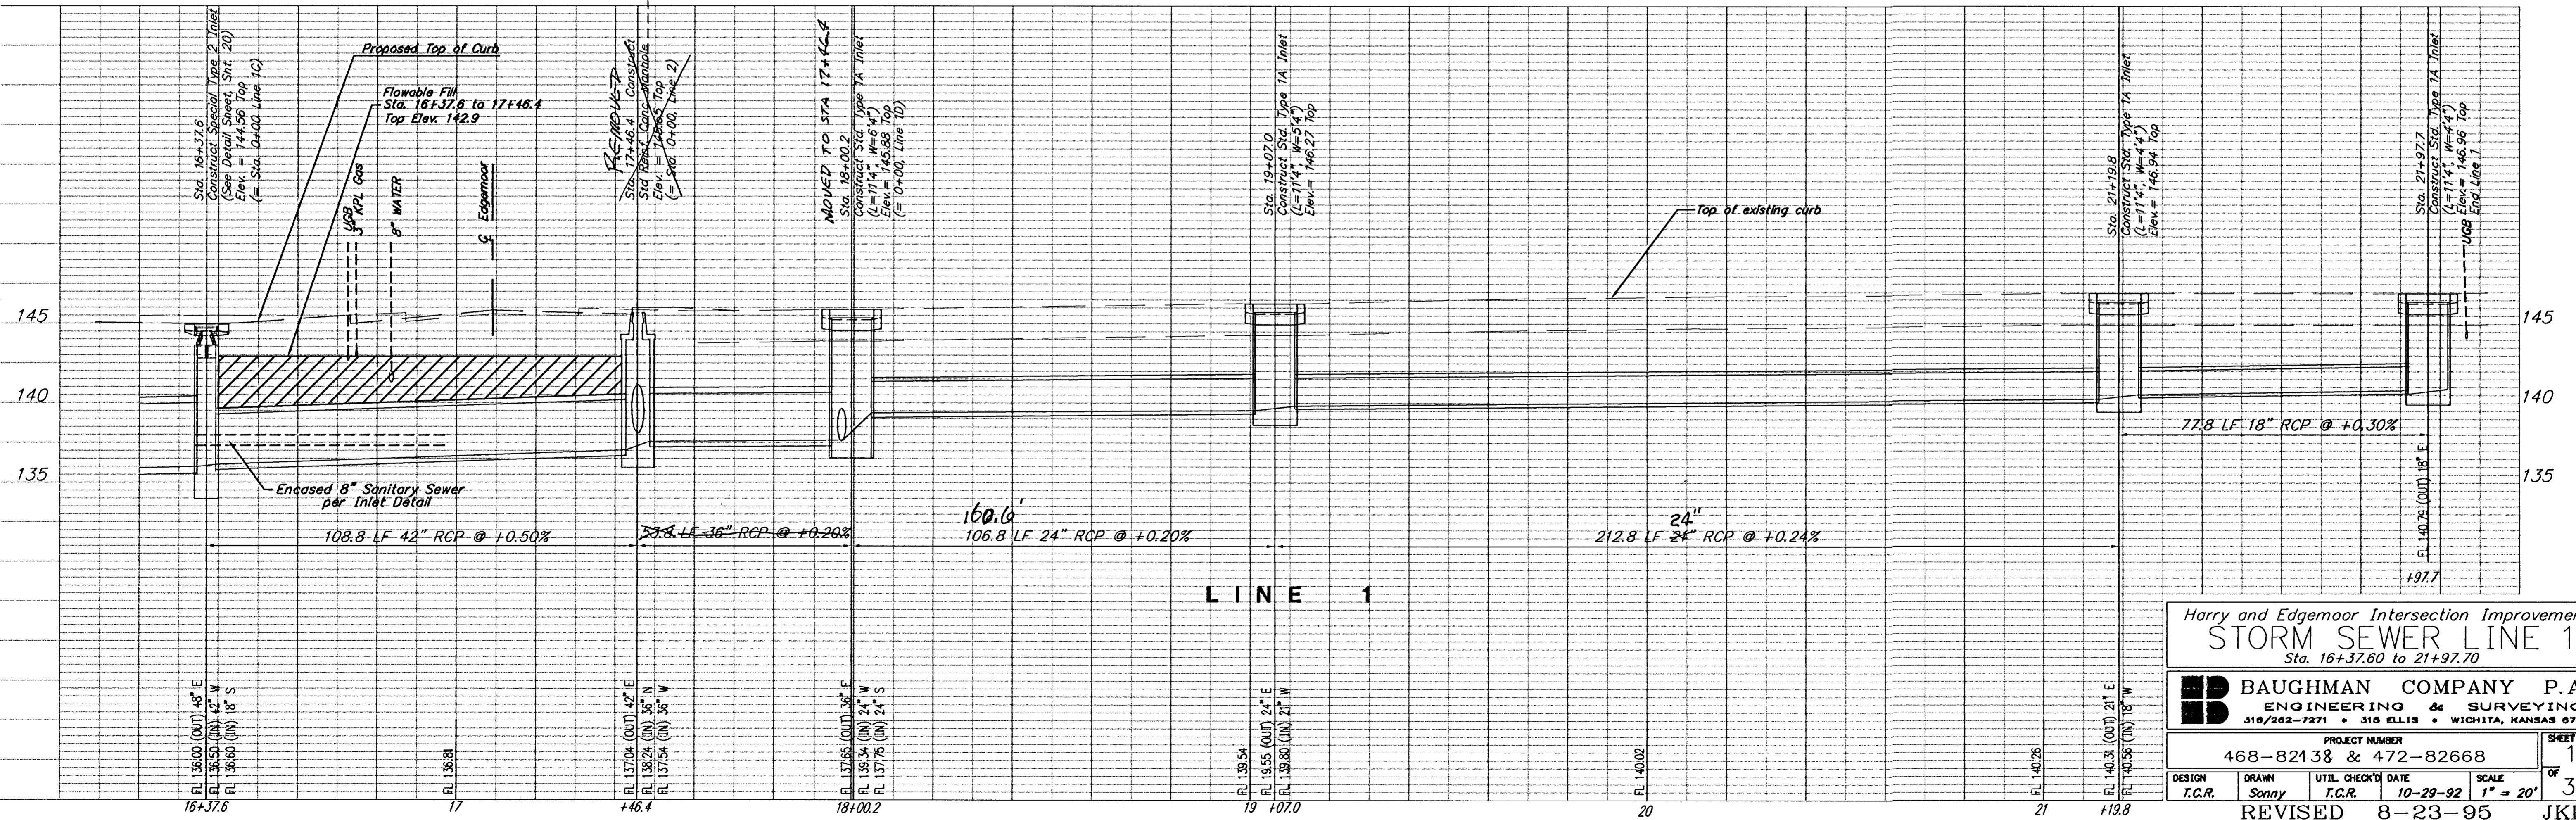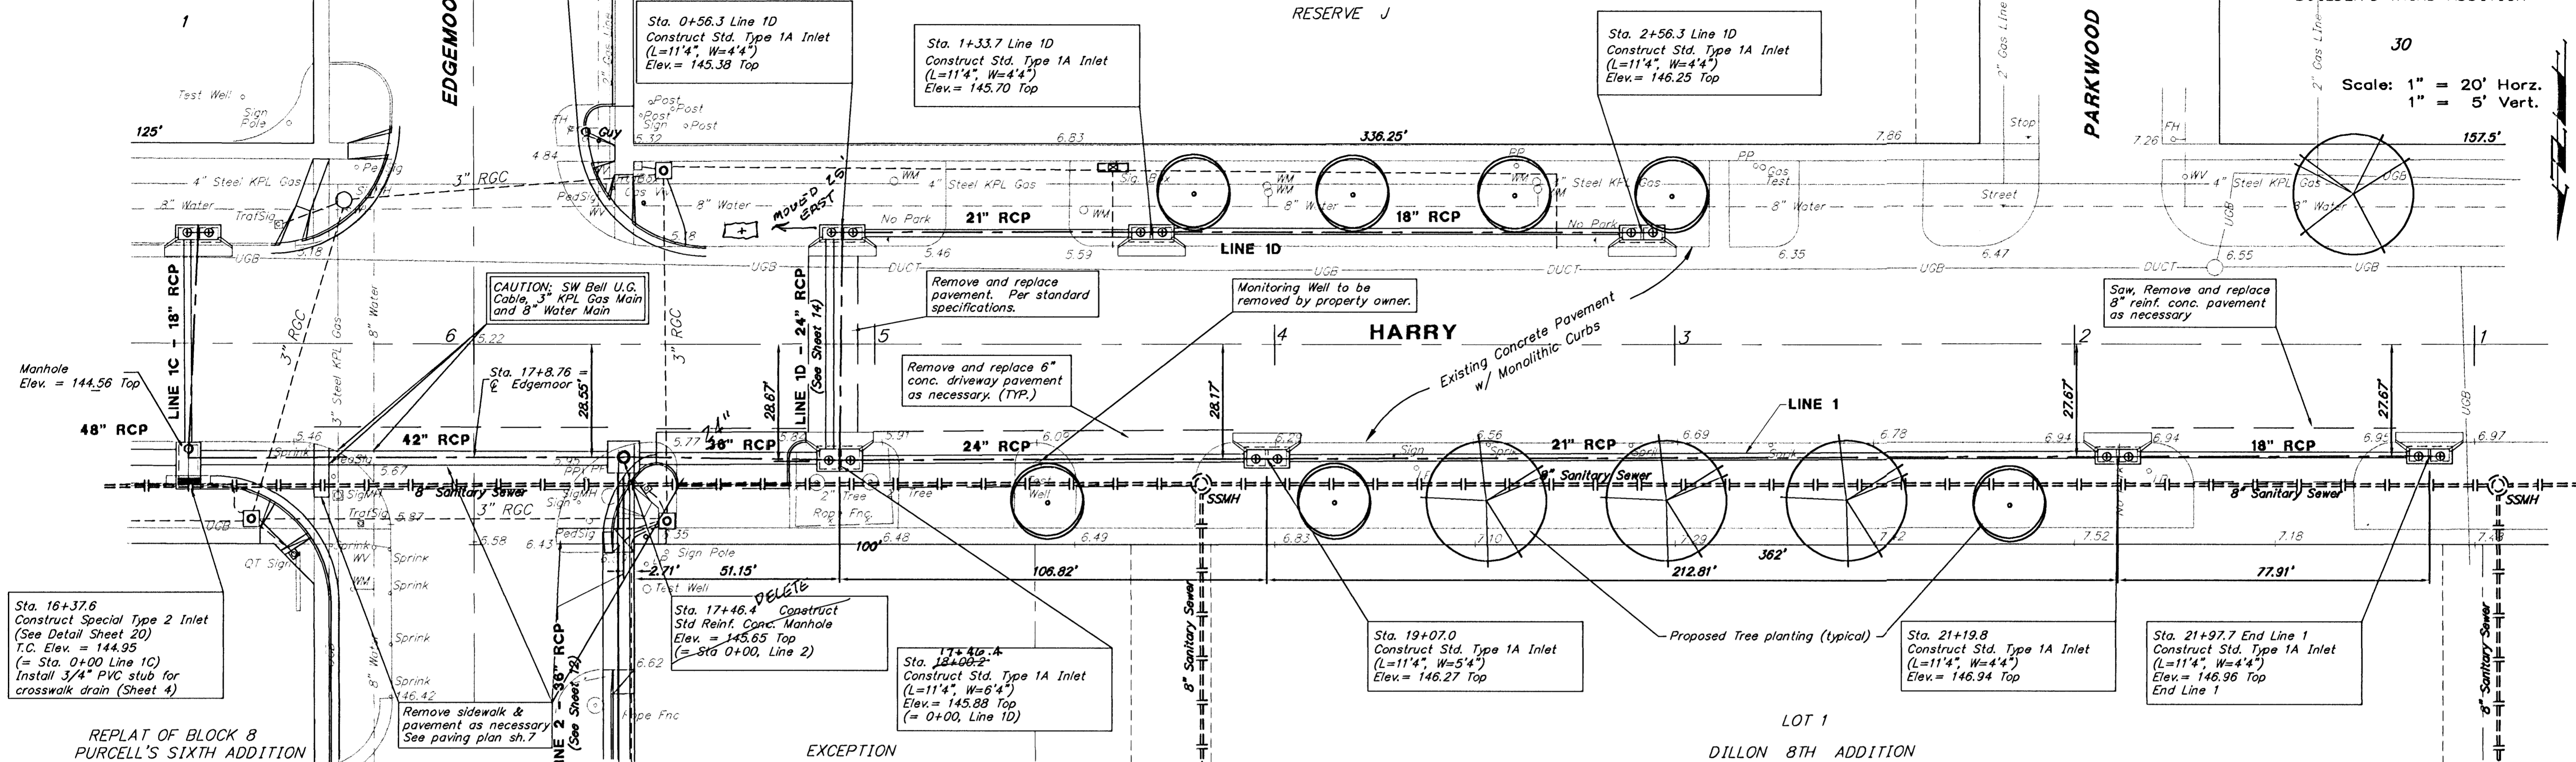

Harry and Edgemoor Intersection Improvements
STORM SEWER LINE 1
 Sta. 16+37.60 to 21+97.70

BAUGHMAN COMPANY P.A.
 ENGINEERING & SURVEYING
 316/282-7271 • 316 ELLIS • WICHITA, KANSAS 67211

PROJECT NUMBER: 468-82138 & 472-82668
 SHEET: 11 OF 38
 DESIGN: T.C.R. DRAWN: Sonny UTIL. CHECK'D DATE: 10-29-92 SCALE: 1" = 20'
 REVISED: 8-23-95 JKB