
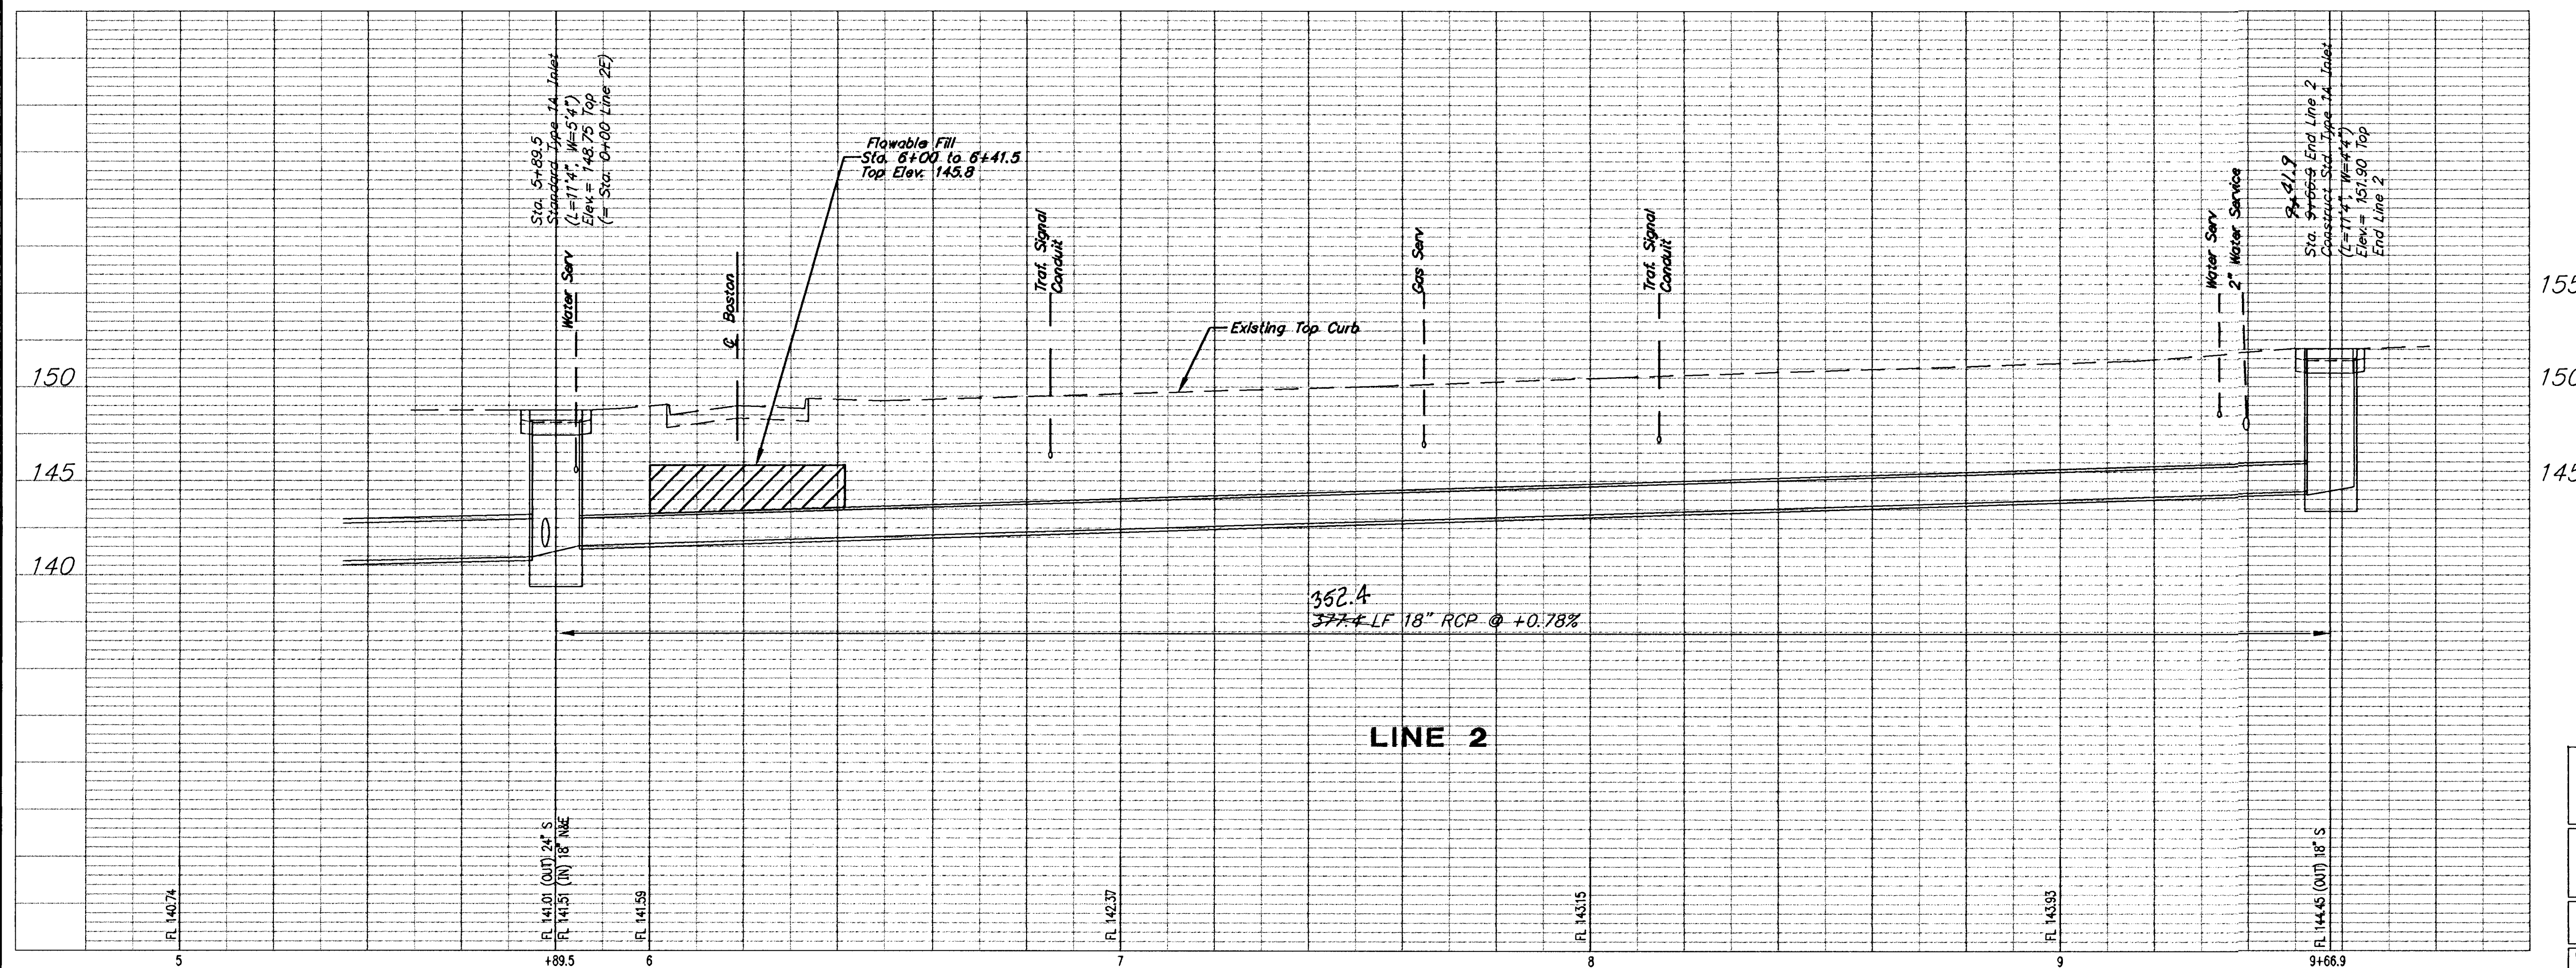


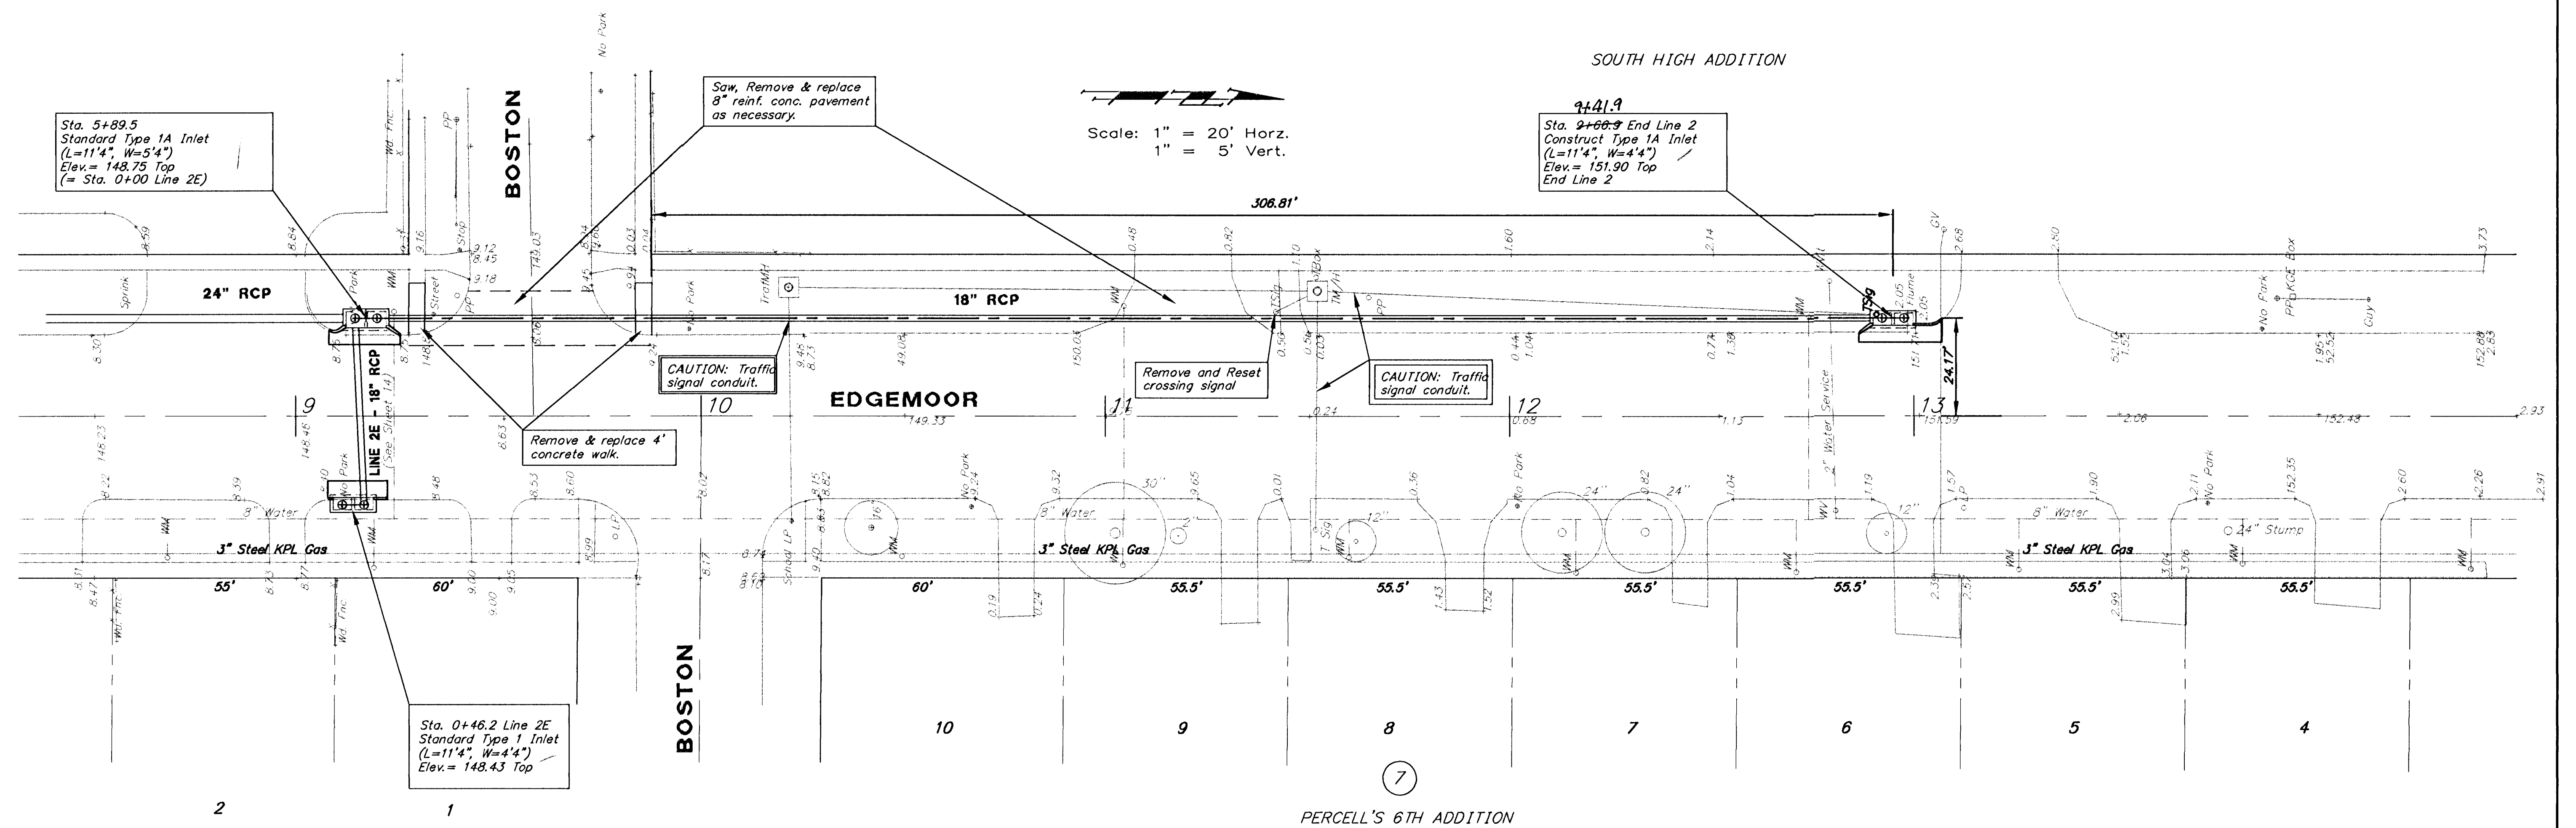

REVISED 8-23-95 JKB

Harry and Edgemoor Intersection Improvements

STORM SEWER LINE 2

Sta 5+89.14 to 9+66.54

BAUGHMAN COMPANY P.A.
ENGINEERING & SURVEYING
318/202-7271 • 316 ELLIS • WICHITA, KANSAS 67211

PROJECT NUMBER
468-82138 & 472-82668

DESIGN
T.C.R.

DRAWN
Sonny

UTIL. CHECK'D
T.C.R.

DATE
10-26-92

SCALE
1" = 20'

SHEET
13
OF
38