

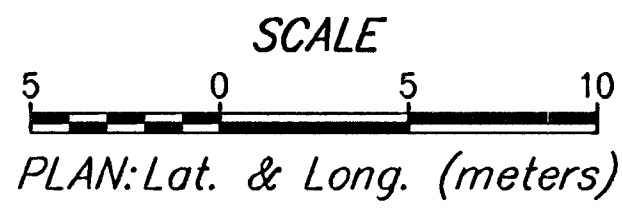
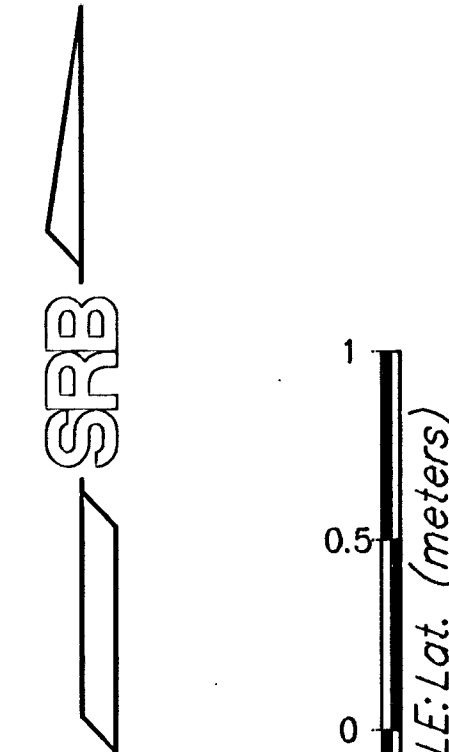


FHWA REGION NO.	STATE	PROJECT NUMBER	FISCAL YEAR	SHEET NUMBER	TOTAL SHEETS
7	KANSAS	87N-0127-01	1999	43	90

DATE	BY	REFERENCES NOTED	CHECKED

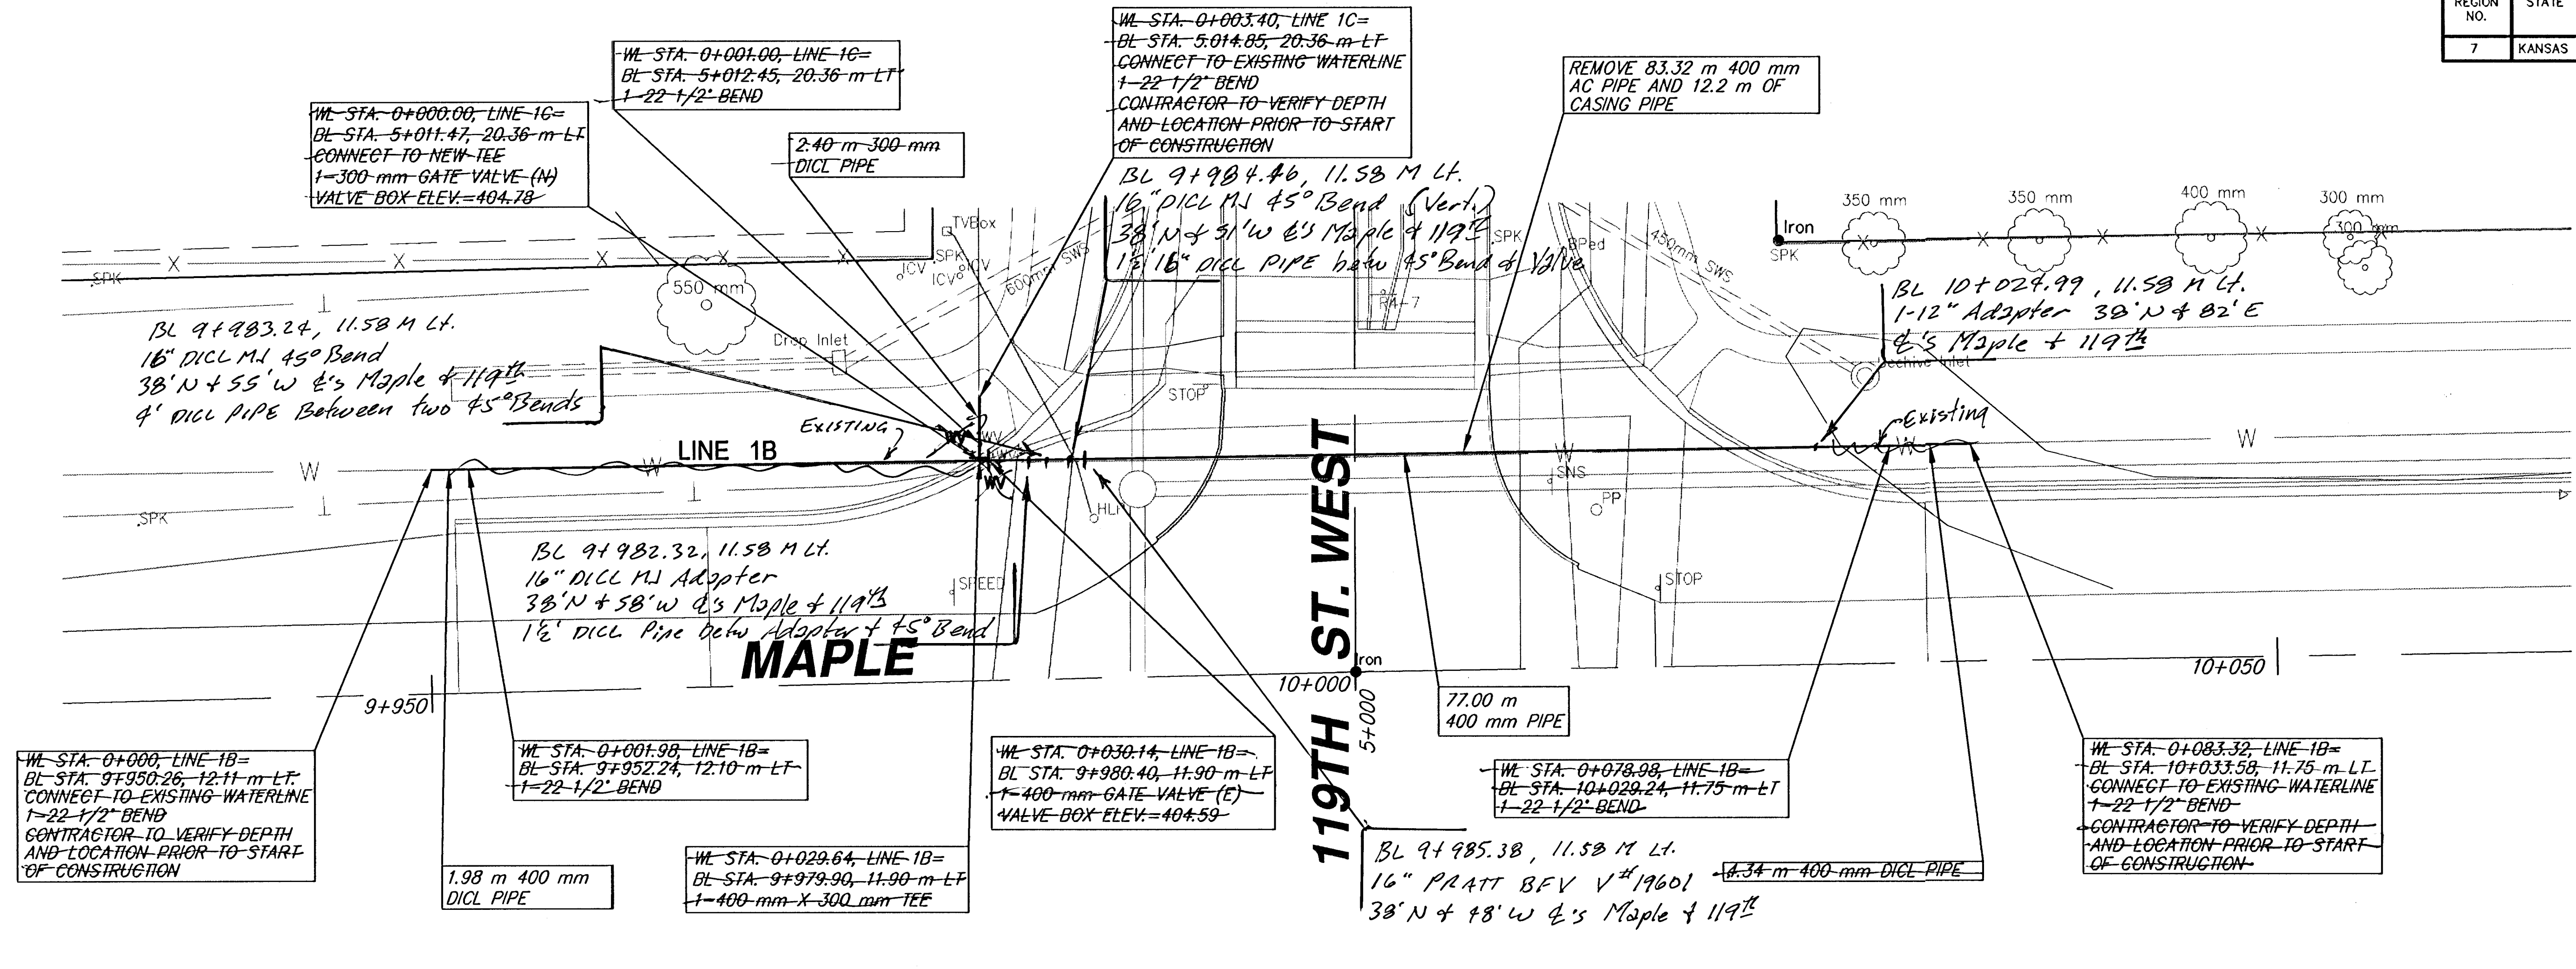

\*\*\* UNLESS OTHERWISE NOTED, ALL ELEVATIONS SHOWN ARE TO TOP OF PIPE \*\*\*

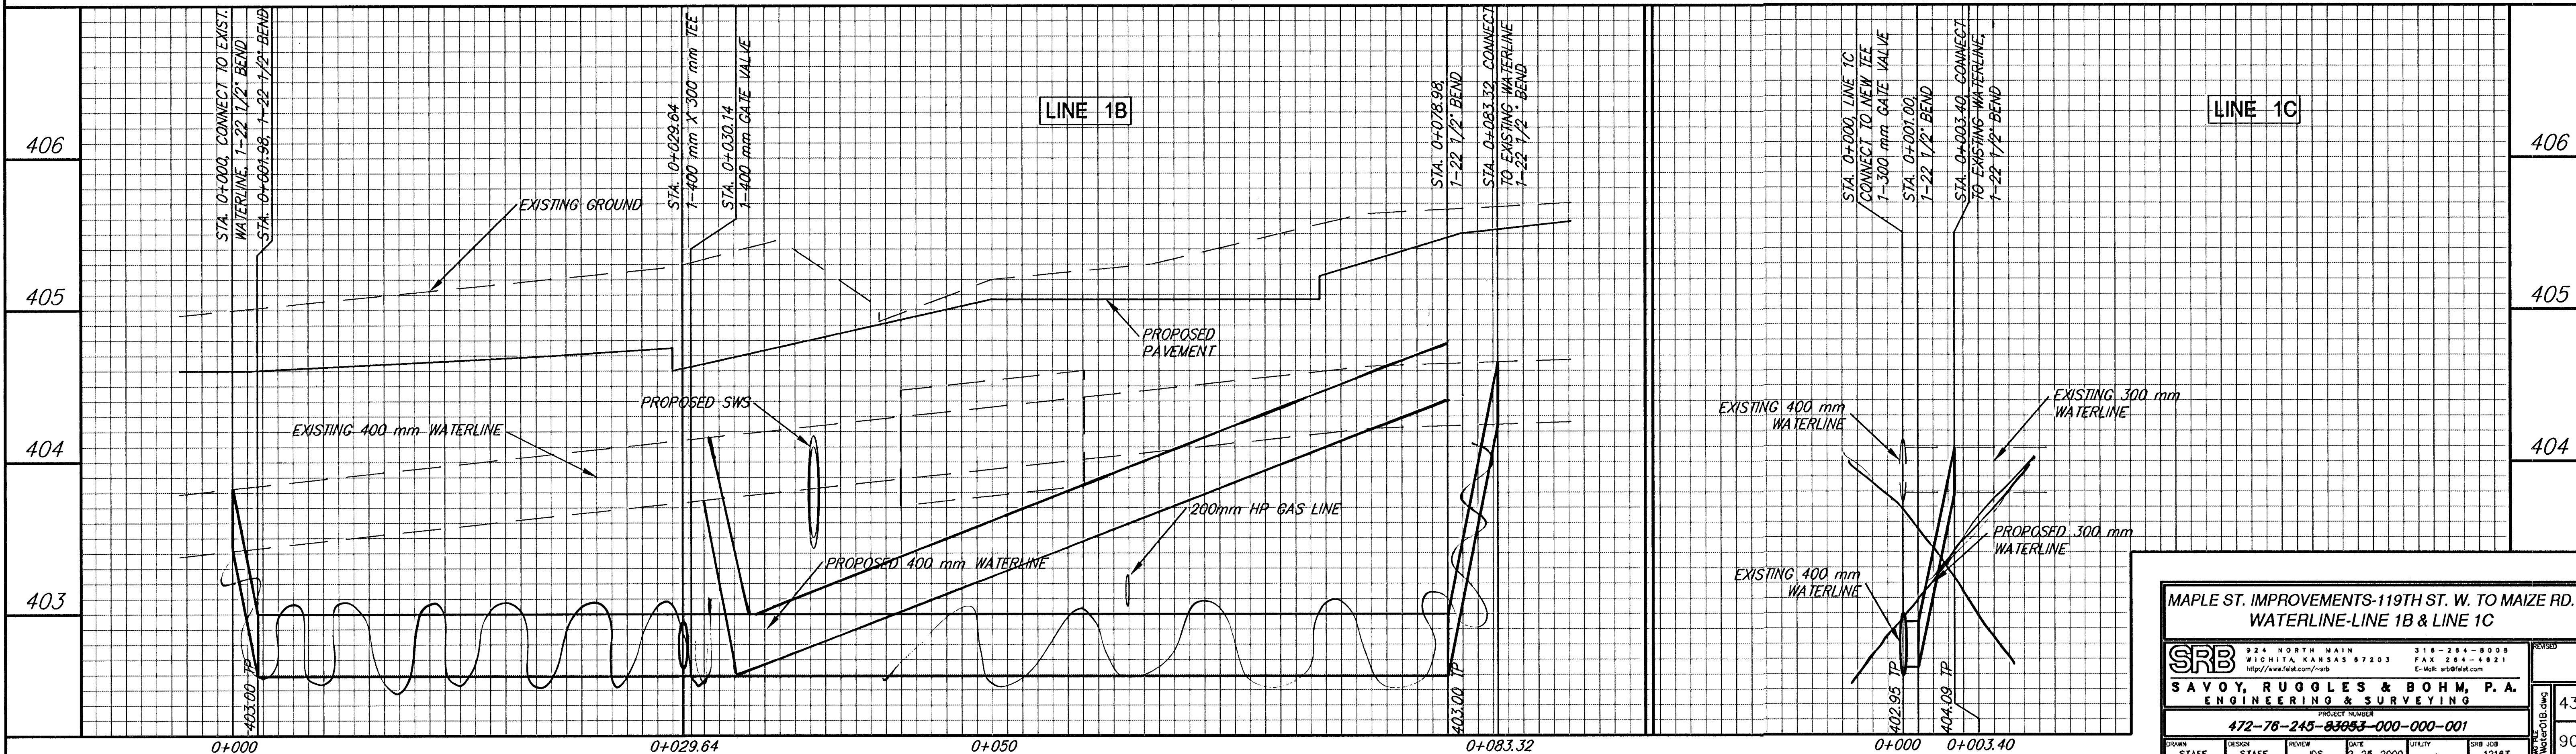

**MAPLE ST. IMPROVEMENTS-119TH ST. W. TO MAIZE RD.  
WATERLINE-LINE 1B & LINE 1C**

**SRB**  
224 NORTH MAIN  
WICHITA, KANSAS 67203  
http://www.srb.com/ks

318-264-8008  
FAX 264-4821  
E-Mail: info@srb.com

**SAVOY, RUGGLES & BOHM, P.A.**  
ENGINEERING & SURVEYING

PROJECT NUMBER  
**472-78-245-83093-000-000-001**

DATE: 2-23-2000  
UTILITY: SRB JOB 1218T

43  
90