

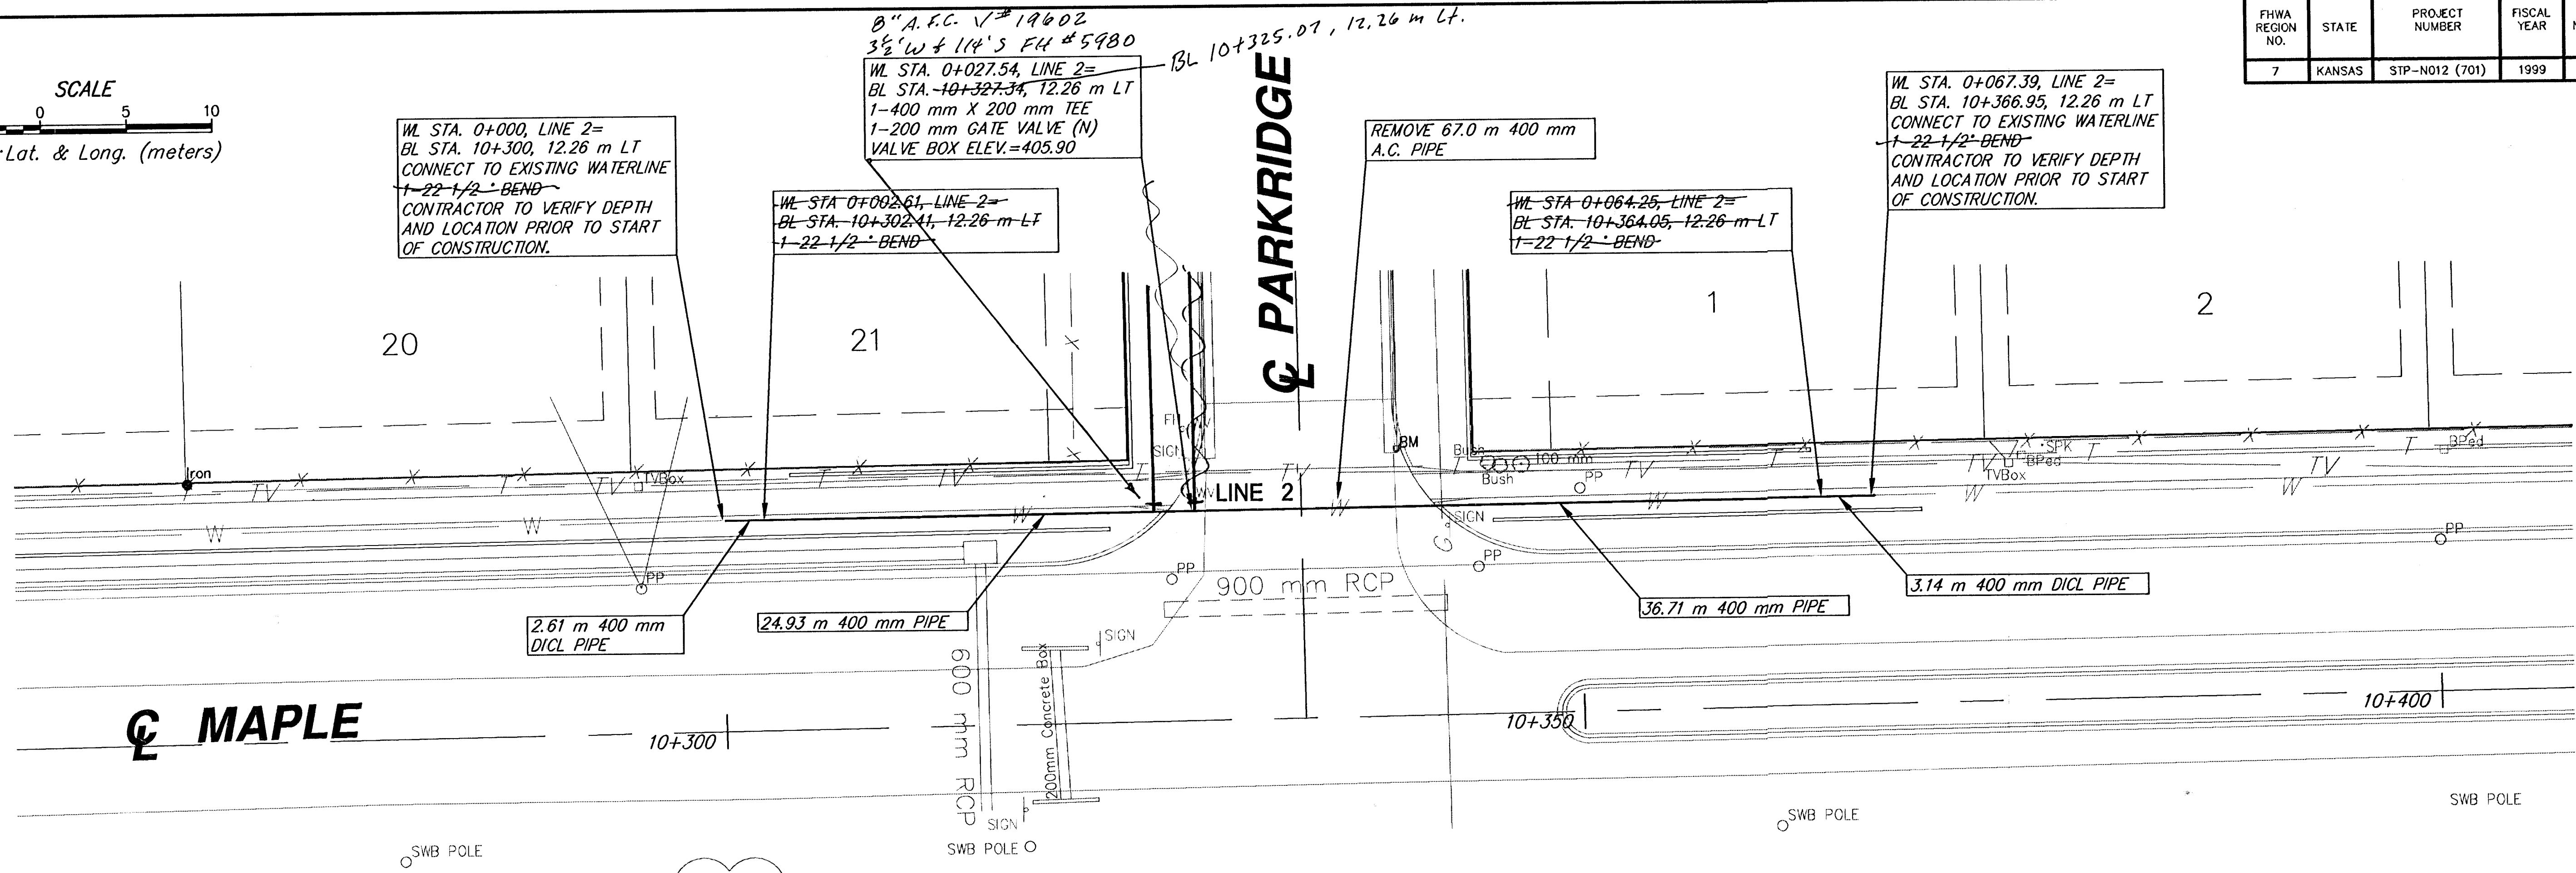
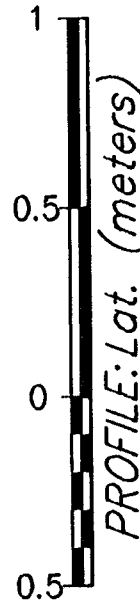
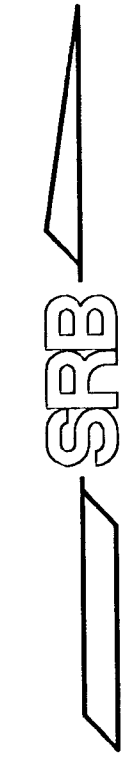


DATE	
BY	
REFERENCES NOTED	
REFERENCES CHECKED	

FHWA REGION NO.	STATE	PROJECT NUMBER	FISCAL YEAR	SHEET NUMBER	TOTAL SHEETS
7	KANSAS	STP-N012 (701)	1999	44	90

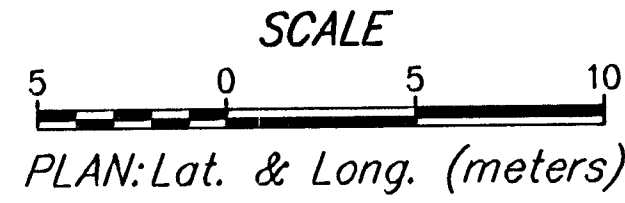

*** UNLESS OTHERWISE NOTED, ALL ELEVATIONS SHOWN ARE TO TOP OF PIPE ***

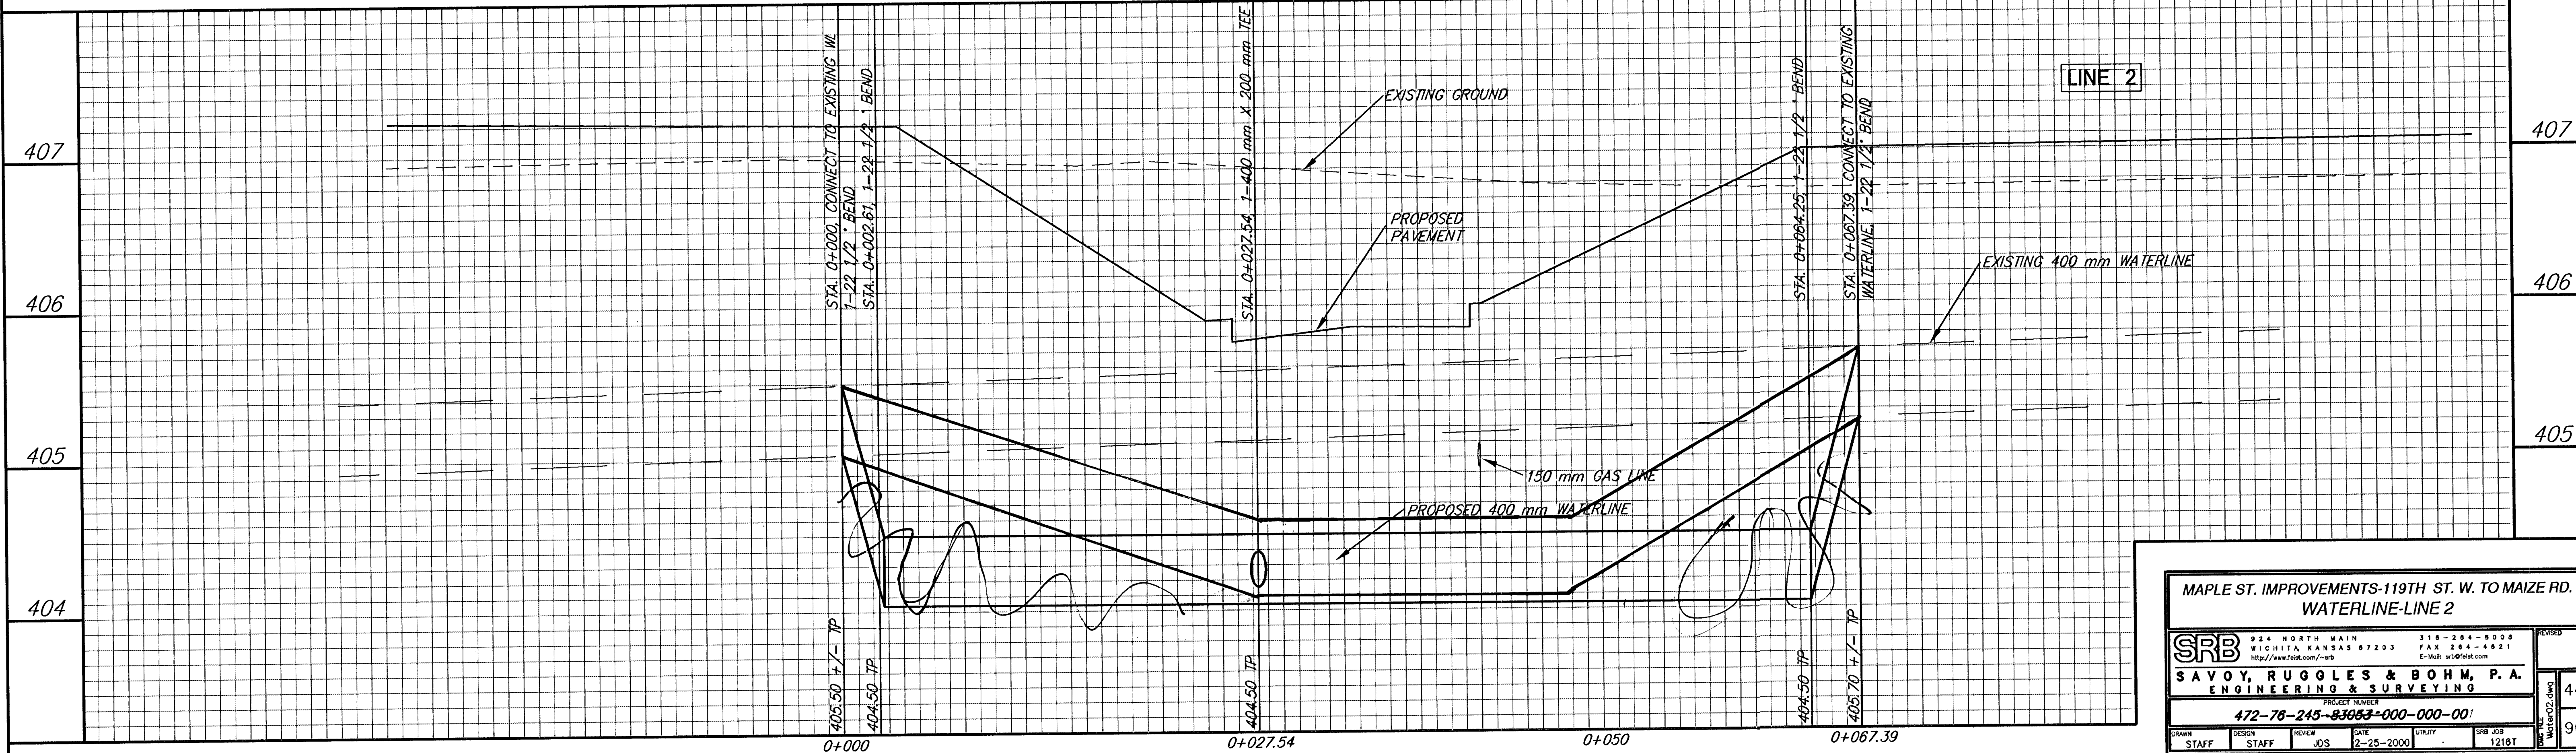

MAPLE ST. IMPROVEMENTS-119TH ST. W. TO MAIZE RD.
WATERLINE-LINE 2

SRB
SAVOY, RUGGLES & BOHM, P.A.
ENGINEERING & SURVEYING

924 NORTH MAIN
WICHITA, KANSAS 67203
http://www.feld.com/~srb

316-284-8008
FAX 264-4621
E-Mail: sr@feld.com

PROJECT NUMBER
472-78-245-83653-000-000-001

DATE
2-25-2000

UTILITY
SRB JOB
1218T

REVISIONS

NO.	DATE	DESCRIPTION
1	2-25-2000	ISSUED FOR PERMIT

44

90