


Scale: 1" = 20'

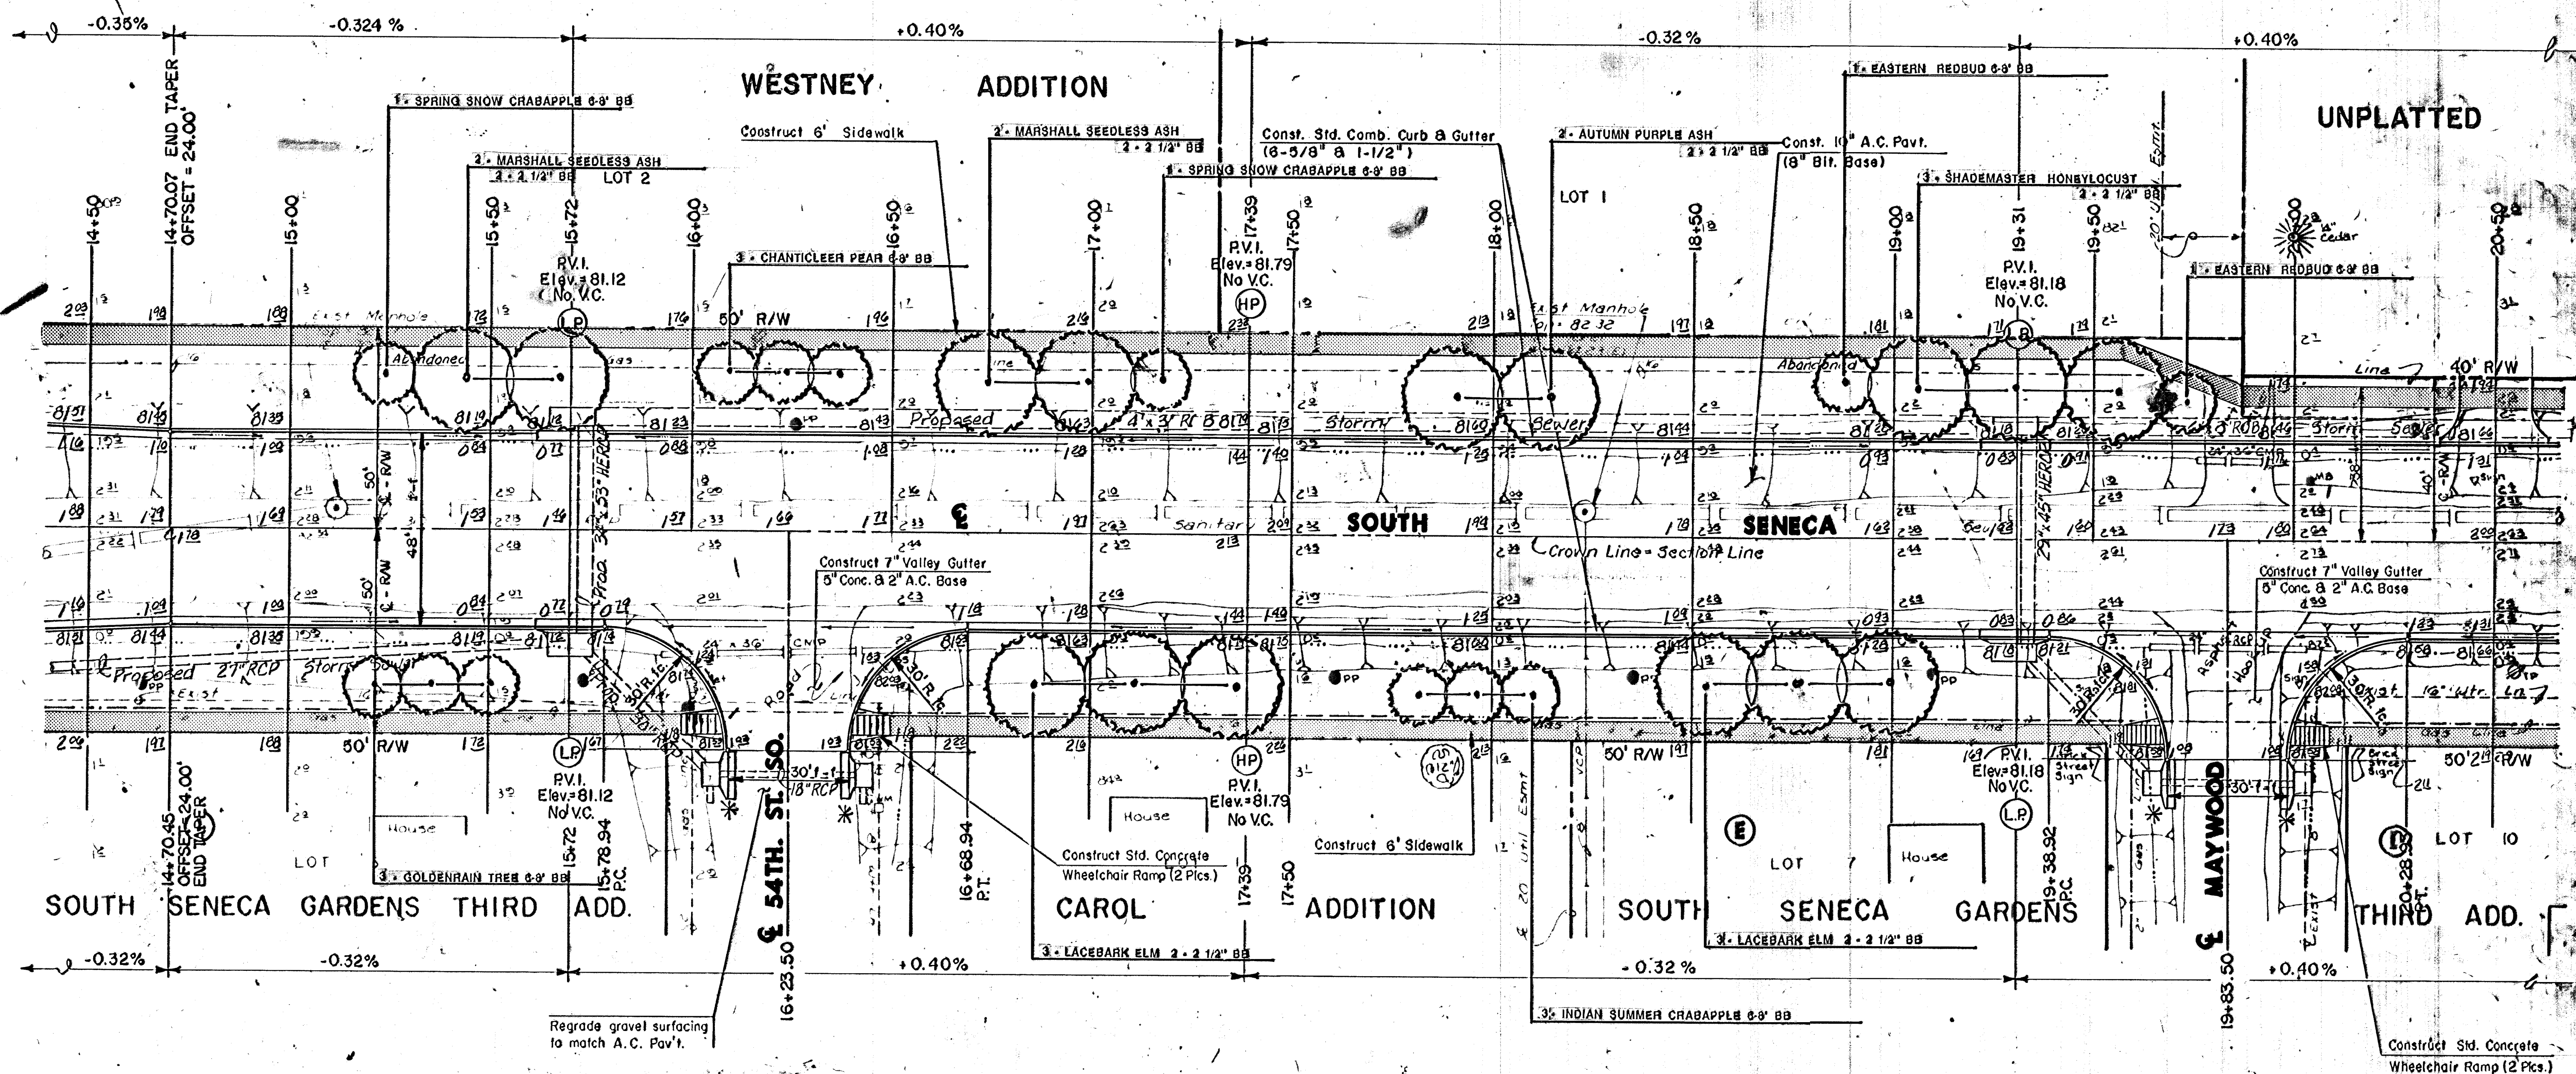

SOUTH SENECA IMPROVEMENTS

PAVING PLAN
55TH ST. SO. TO 48TH ST. SO.

MID-KANSAS ENGINEERING CONSULTANTS PA
3500 NORTH ROCK ROAD
BUILDING #800
WICHITA, KANSAS 67226

636-5566

Drawn by	DLM
Checked by	
Date	OCT 1989
Job No.	
Sheet	3
of	9

BB-03-113E