

PROJECT NO.	YEAR	SHEET NO.	TOTAL SHEETS
618-33	1995	100	100


DATE	BY	REFERENCES NOTED	REFERENCES CHECKED

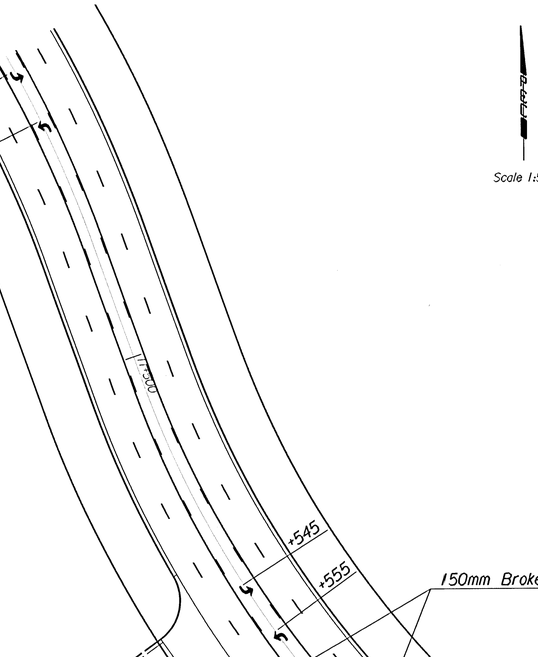

Scale 1:500

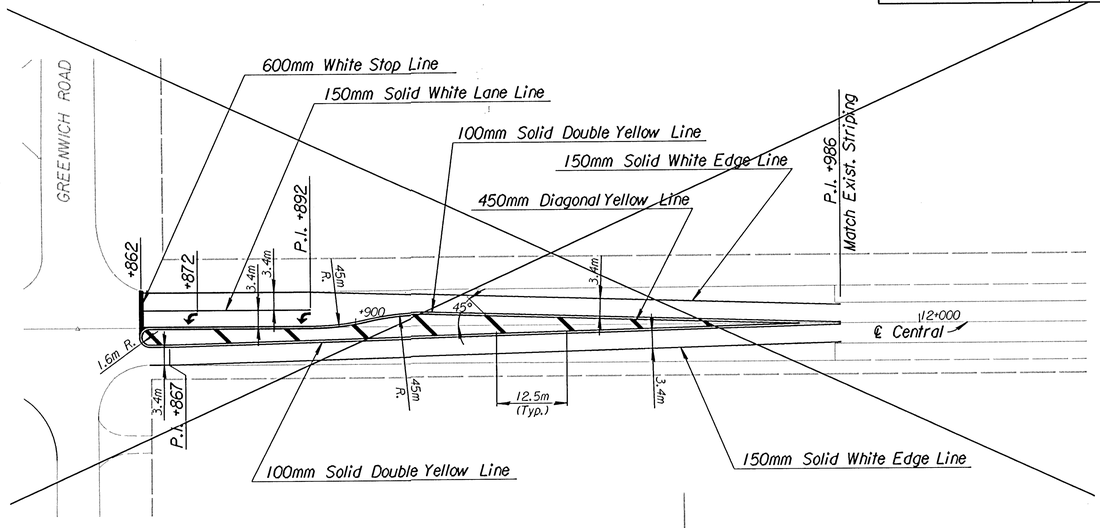

Note:
This sheet is for information only to show existing marking west of Greenwich Road prior to beginning construction. Quantities have been included for pavement markings to replace markings removed for traffic handling.

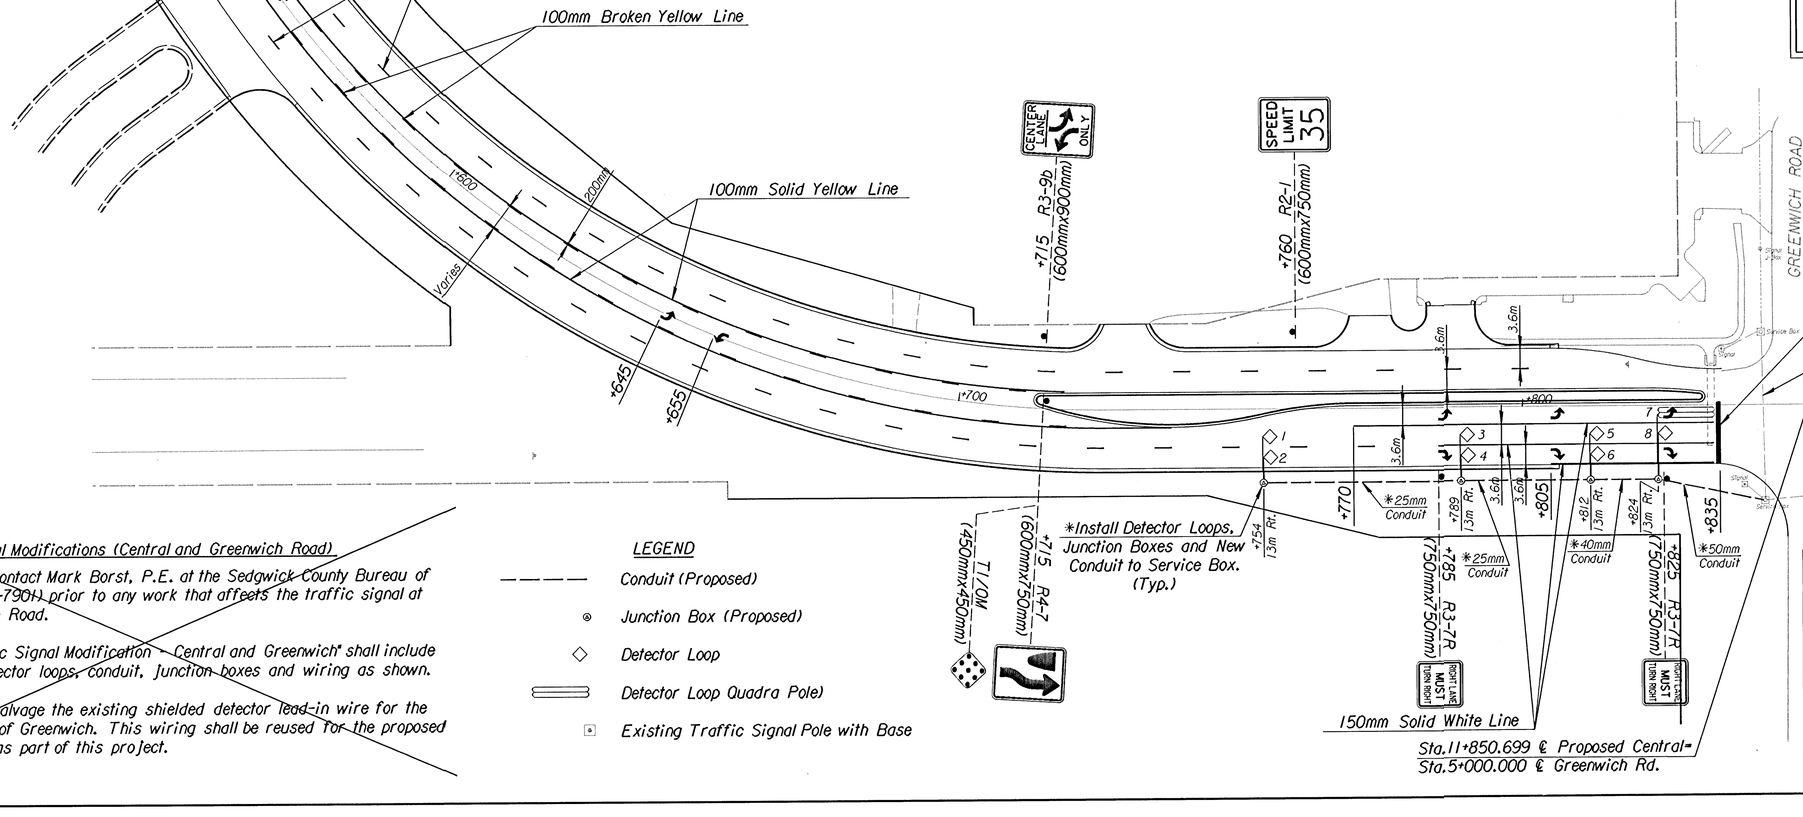

Traffic Signal Modifications (Central and Greenwich Road)

The Contractor shall contact Mark Borst, P.E. at the Sedgwick County Bureau of Public Services (383-7901) prior to any work that affects the traffic signal at Central and Greenwich Road.

*This bid item "Traffic Signal Modification - Central and Greenwich" shall include the installation of detector loops, conduit, junction boxes and wiring as shown.

The Contractor shall salvage the existing shielded detector lead-in wire for the loops on Central west of Greenwich. This wiring shall be reused for the proposed loops to be installed as part of this project.

LEGEND

- Conduit (Proposed)
- Junction Box (Proposed)
- Detector Loop
- Detector Loop Quadra Pole)
- Existing Traffic Signal Pole with Base

No.	Revisions	By	Date
1			

SEDGWICK COUNTY BUREAU OF PUBLIC SERVICES

MARKING PLAN
STA. 11+450 TO STA. 12+000

PROJECT NO. 618-33 — SEDGWICK COUNTY

PROFESSIONAL ENGINEERING CONSULTANTS, P.A.
ENGINEERS
WICHITA, KANSAS

Designed by	RPG	Checked by	WDH	
Drawn by	CDR	Date	Sept. 1995	Job No. 93563

100

i:/1995/95297/marking/mrkexist.dgn
Drawn By: GDR
Plotted By: mdf 7-25-97