


SOUTH SENECA 48TH TO MAC ARTHUR
IMPROVEMENTS
PAVING CROSS SECTIONS

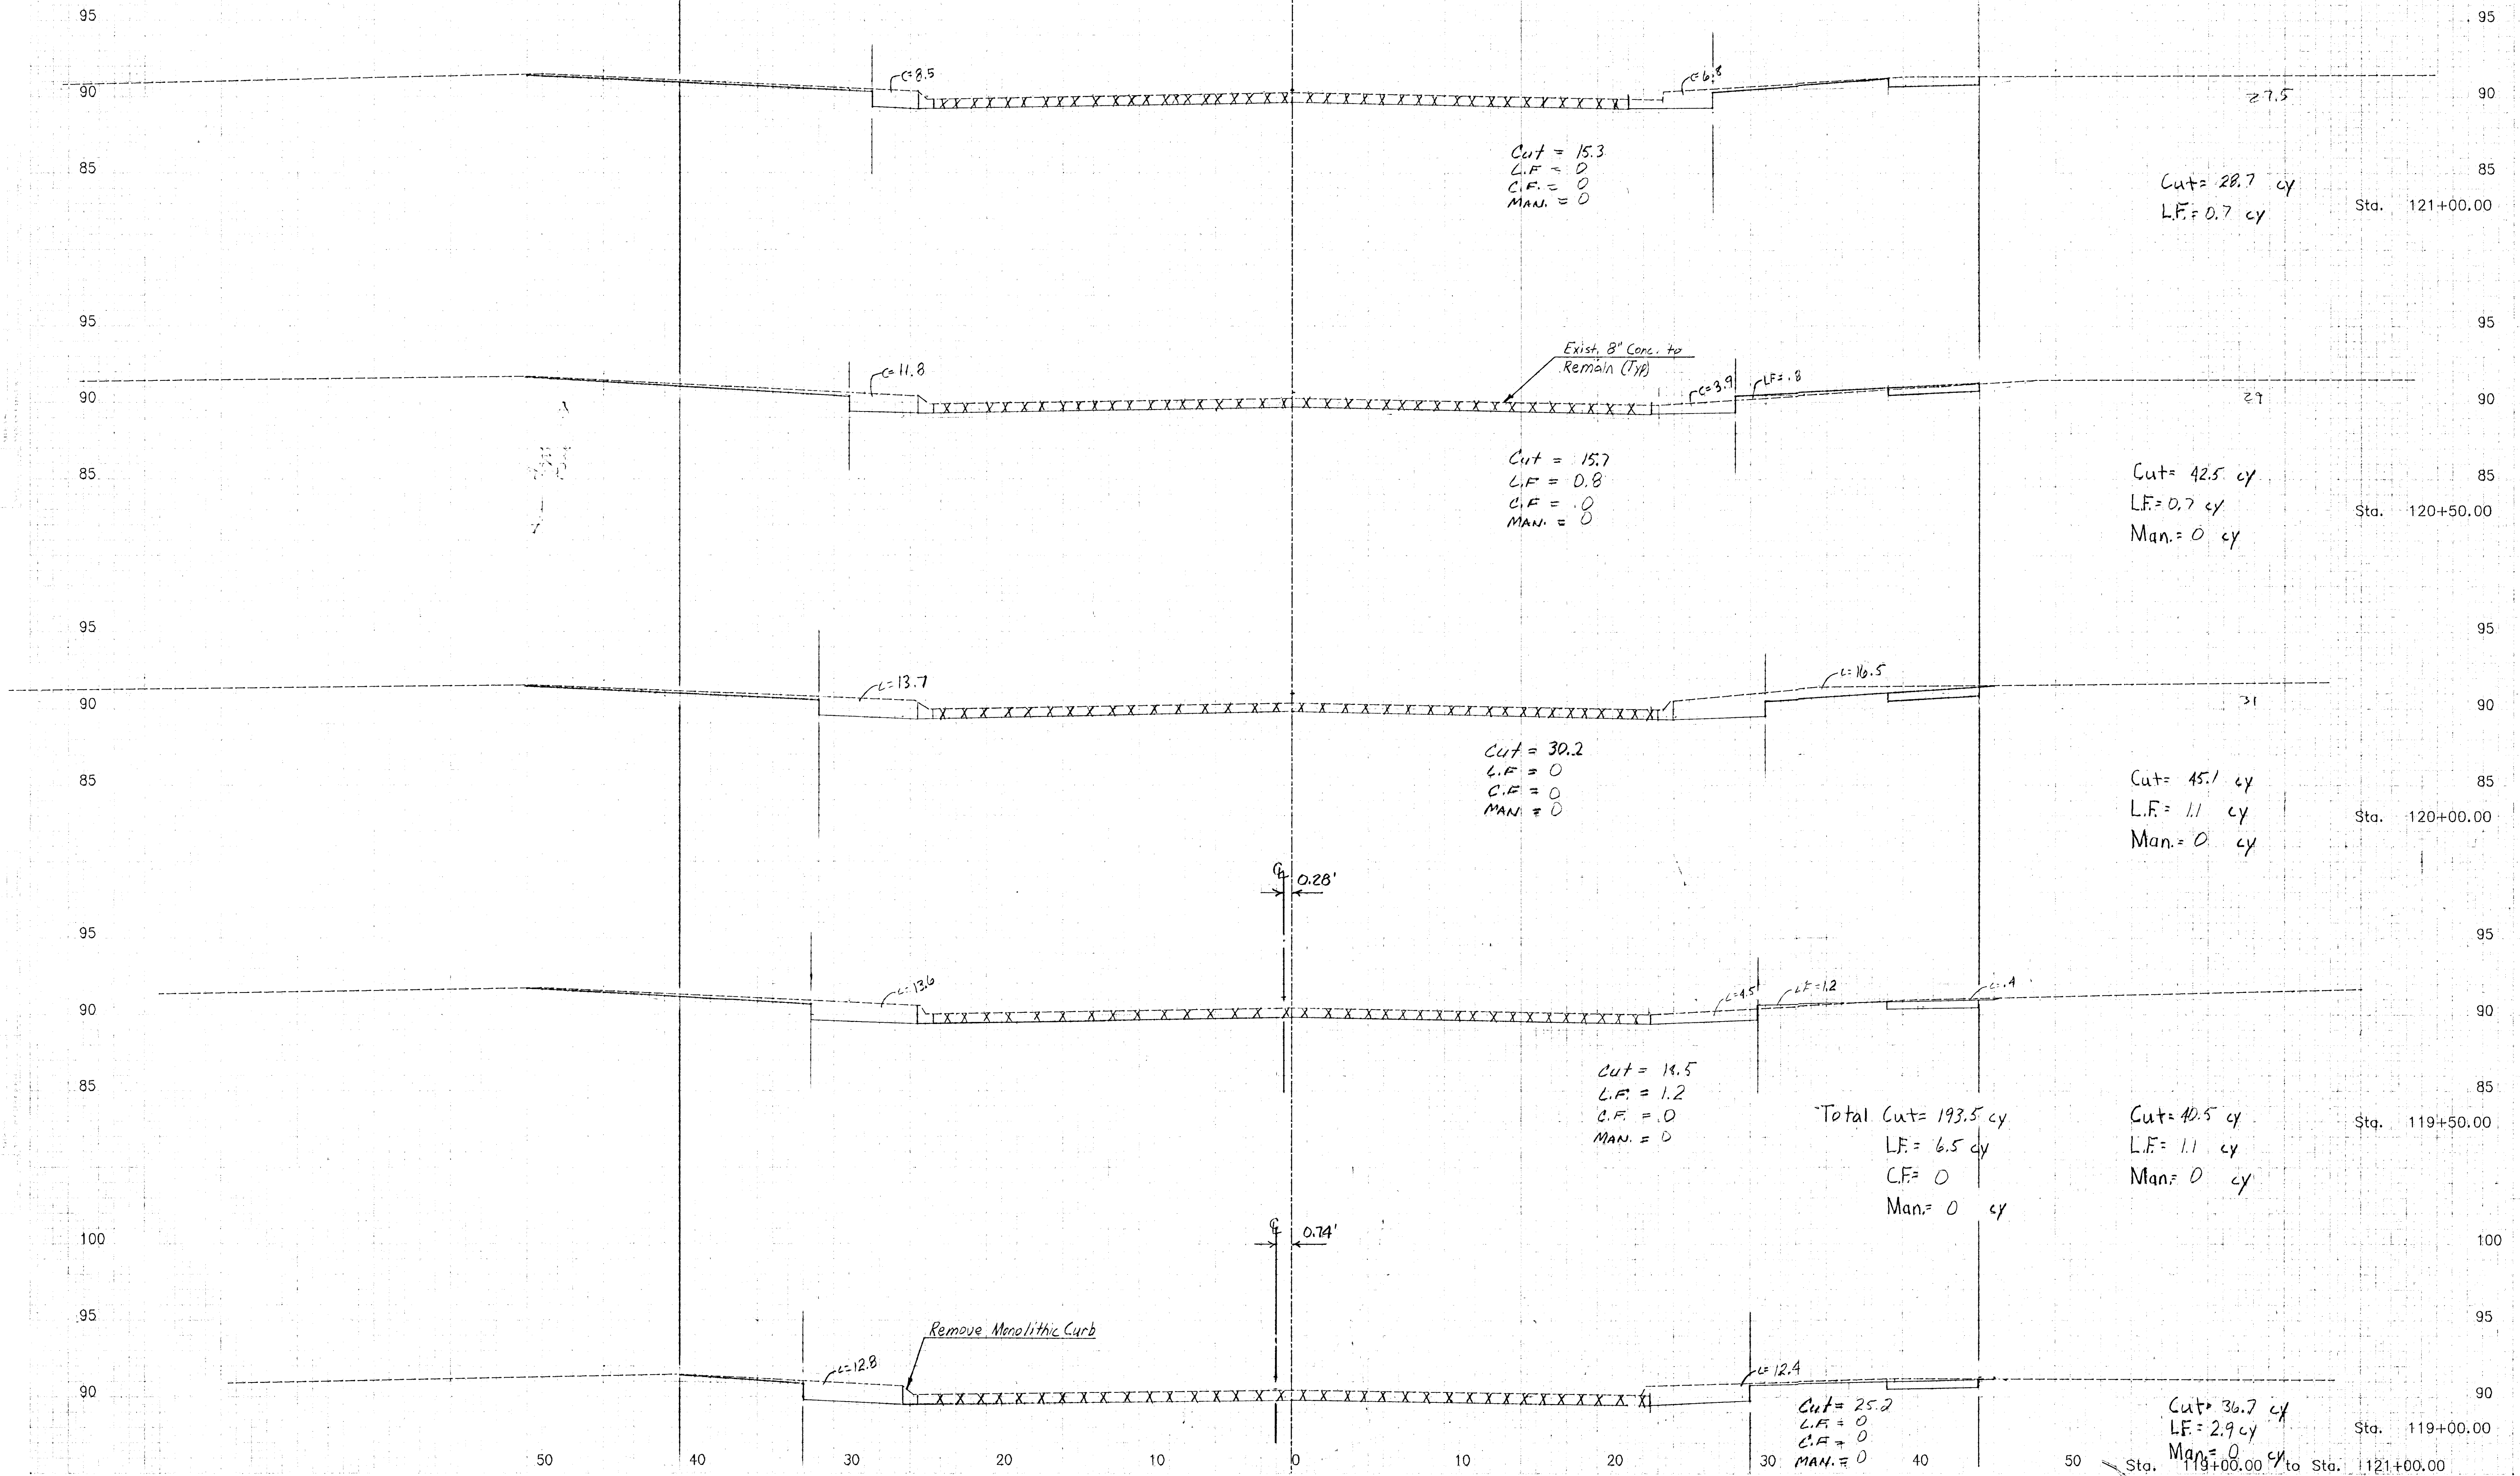

SOUTH SENECA