**PHASE 1A-GRASS & LANDSCAPE PLANTING**

PAVING PLANS FOR

# SOUTH SENECA

From N.L. of ~~48th~~ 41st St. So. to 400' N of N. Line of Mac Arthur Rd.

&

47th. St. So. from 400' W. to 590' E. of ℄ Seneca

&

MacArthur Rd. from 400' W. to Seneca

## PROJECT NO.
## 472·76·245·82009·000·000·001

**CITY OF WICHITA, KANSAS**

**MICHAEL E. LINDEBAK, CITY ENGINEER**

**INDEX NO. 705319**


### GENERAL NOTES

1. INFORMATION SHOWN ON PLANS NOT DIRECTLY RELATED TO THE TREE PLANTINGS IS NOT A PART OF THIS CONTRACT AND SHALL BE CONSIDERED AS DELETED.
2. ALL AREAS DISTURBED BY THE CONTRACTOR SHALL BE RESTORED TO A CONDITION ACCEPTABLE TO THE ENGINEER. THIS WORK SHALL BE SUBSIDIARY TO OTHER BID ITEMS.
3. EXACT LOCATION FOR TREE PLANTINGS TO BE DETERMINED BY THE ENGINEER.
4. LANDSCAPE CONTRACTOR IS TO VERIFY THE LOCATION OF ALL UNDERGROUND UTILITIES PRIOR TO INSTALLATION OF PLANT MATERIAL ( INCLUDING SANITARY SEWERS ). UTILITIES CAN BE FLAGGED BY CALLING 687-2470.

### INDEX TO DRAWINGS


| Sheet No. | Description |
|---|---|
| 1 | Title Sheet |
| 2–8 | Landscape Plans |


Revised 3-10-93

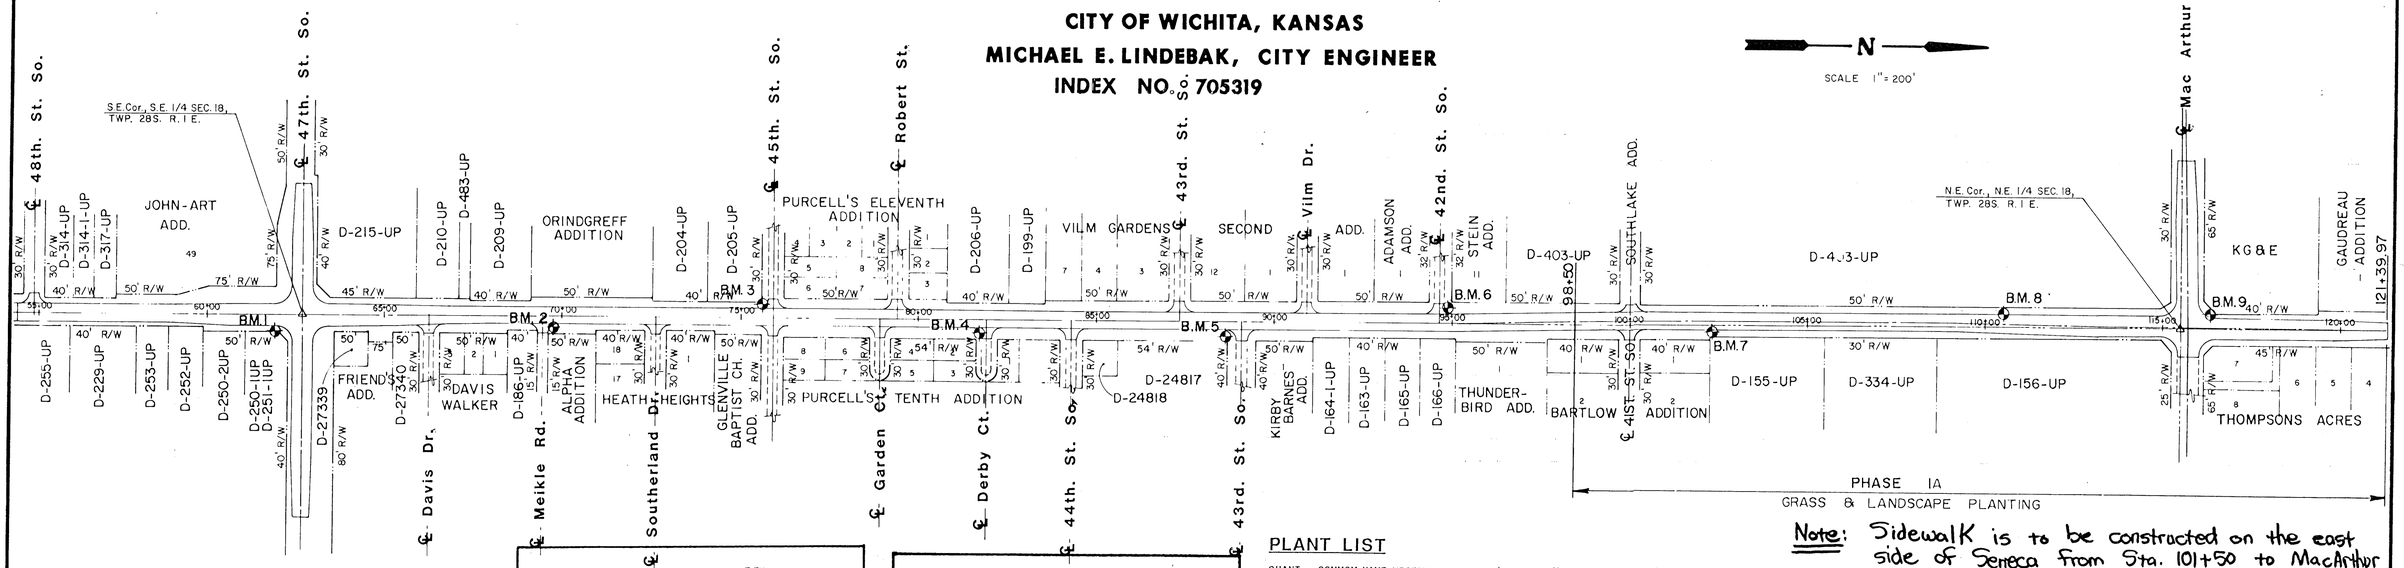


### BENCHMARKS

BM #1 C.O.W. B.M. Disc, Seneca & 47th St. S. 74' S & 44' E of CL's
Elev. = 87.341

BM #2 Near Sta. 69+60, 30' Right, Step nail in pole.
Elev. = 89.44

BM #3 Near Sta. 75+68, 30' Left, Step nail in pole.
Elev. = 88.55

BM #4 Near Sta. 81+78, 30' Right, Step nail in pole.
Elev. = 89.86


BM #5 C.O.W. B.M. Disc, Seneca & 43rd St. S. 48' E & 42.8' S of CL's
Elev. = 88.008


BM #6 Near Sta. 94+85, 30' Left, Step nail in pole.
Elev. = 89.83

BM #7 Near Sta. 102+30, 28' Right, Step nail in pole.
Elev. = 90.75

BM #8 Near Sta. 110+50, 30' Left, Step nail in pole.
Elev. = 93.40

BM #9 C.O.W. B.M. Disc, Seneca & MacArthur Road 86' N & 28.5 W of Sec. Cor.
Elev. = 90.370

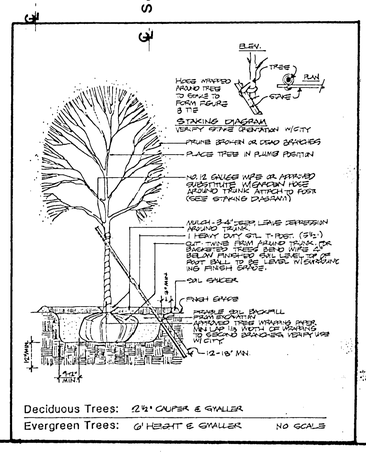

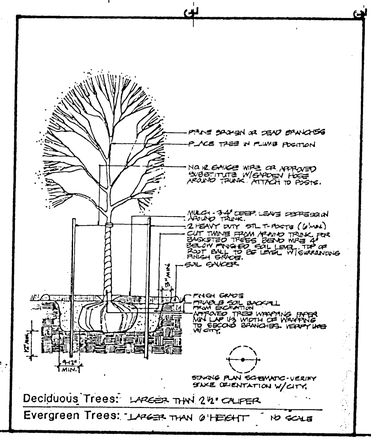
### PLANT LIST

| QUANT. | COMMON NAME / BOTANICAL NAME | SIZE | COND. | REMARKS |
|---|---|---|---|---|
| 6 | MARSHALL SEEDLESS ASH *Fraxinus pennsylvanica* 'Marshall Seedless' | 2 - 2 1/2" | BB | |
| 4 | ROSEHILL ASH *Fraxinus americana* 'Rosehill' | 2 - 2 1/2" | BB | |
| 14 | SHADEMASTER HONEYLOCUST *Gleditsia triacanthos* 'Shademaster' | 2 - 2 1/2" | BB | |
| 6 | AUTUMN PURPLE ASH *Fraxinus americana* 'Autumn purple' | 2 - 2 1/2" | BB | |
| 5 | LACEBARK ELM *Ulmus parvifolia* 'Lacebark' | 2 - 2 1/2" | BB | |
| 2 | CHINESE PISTACHE *Pistachia chinensis* | 2 - 2 1/2" | BB | |
| 33 | CHANTICLEER PEAR *Pyrus calleryana* 'Chanticleer' | 6 - 8' | BB | |
| 9 | INDIAN SUMMER CRABAPPLE *Malus* 'Indian Summer' | 6 - 8' | BB | |
| 9 | GOLDENRAINTREE *Koelreuteria paniculata* | 6 - 8' | BB | |
| 8 | VAN ESELTINE CRABAPPLE *Malus* 'Van Eseltine' | 6 - 8' | BB | |
| 8 | SPRING SNOW CRABAPPLE *Malus* 'Spring Snow' | 6 - 8' | BB | |
| 2 | SNOWDRIFT CRABAPPLE *Malus* 'Snowdrift' | 6 - 8' | BB | |
| 9 | PRAIRIE FIRE CRABAPPLE *Malus* 'Prairie Fire' | 6 - 8' | BB | |

**Note:** Sidewalk is to be constructed on the east side of Seneca from Sta. 101+50 to MacArthur Rd. Field engineer to adjust tree locations for future sidewalk construction.

**NOTE: TRAFFIC TO BE CARRIED THRU CONSTRUCTION**

MKEC 2-3-92

**SOUTH SENECA IMPROVEMENTS**

**TITLE SHEET**

48th. St. So. to Mac Arthur Rd.

Design
Drawn by
Checked by DCH
Date Feb., 1992
Job no


MID-KANSAS ENGINEERING CONSULTANTS PA
3500 NORTH ROCK ROAD
BUILDING #800
WICHITA, KANSAS 67226
636-5566


Sheet 1 of 8

Phase IA