


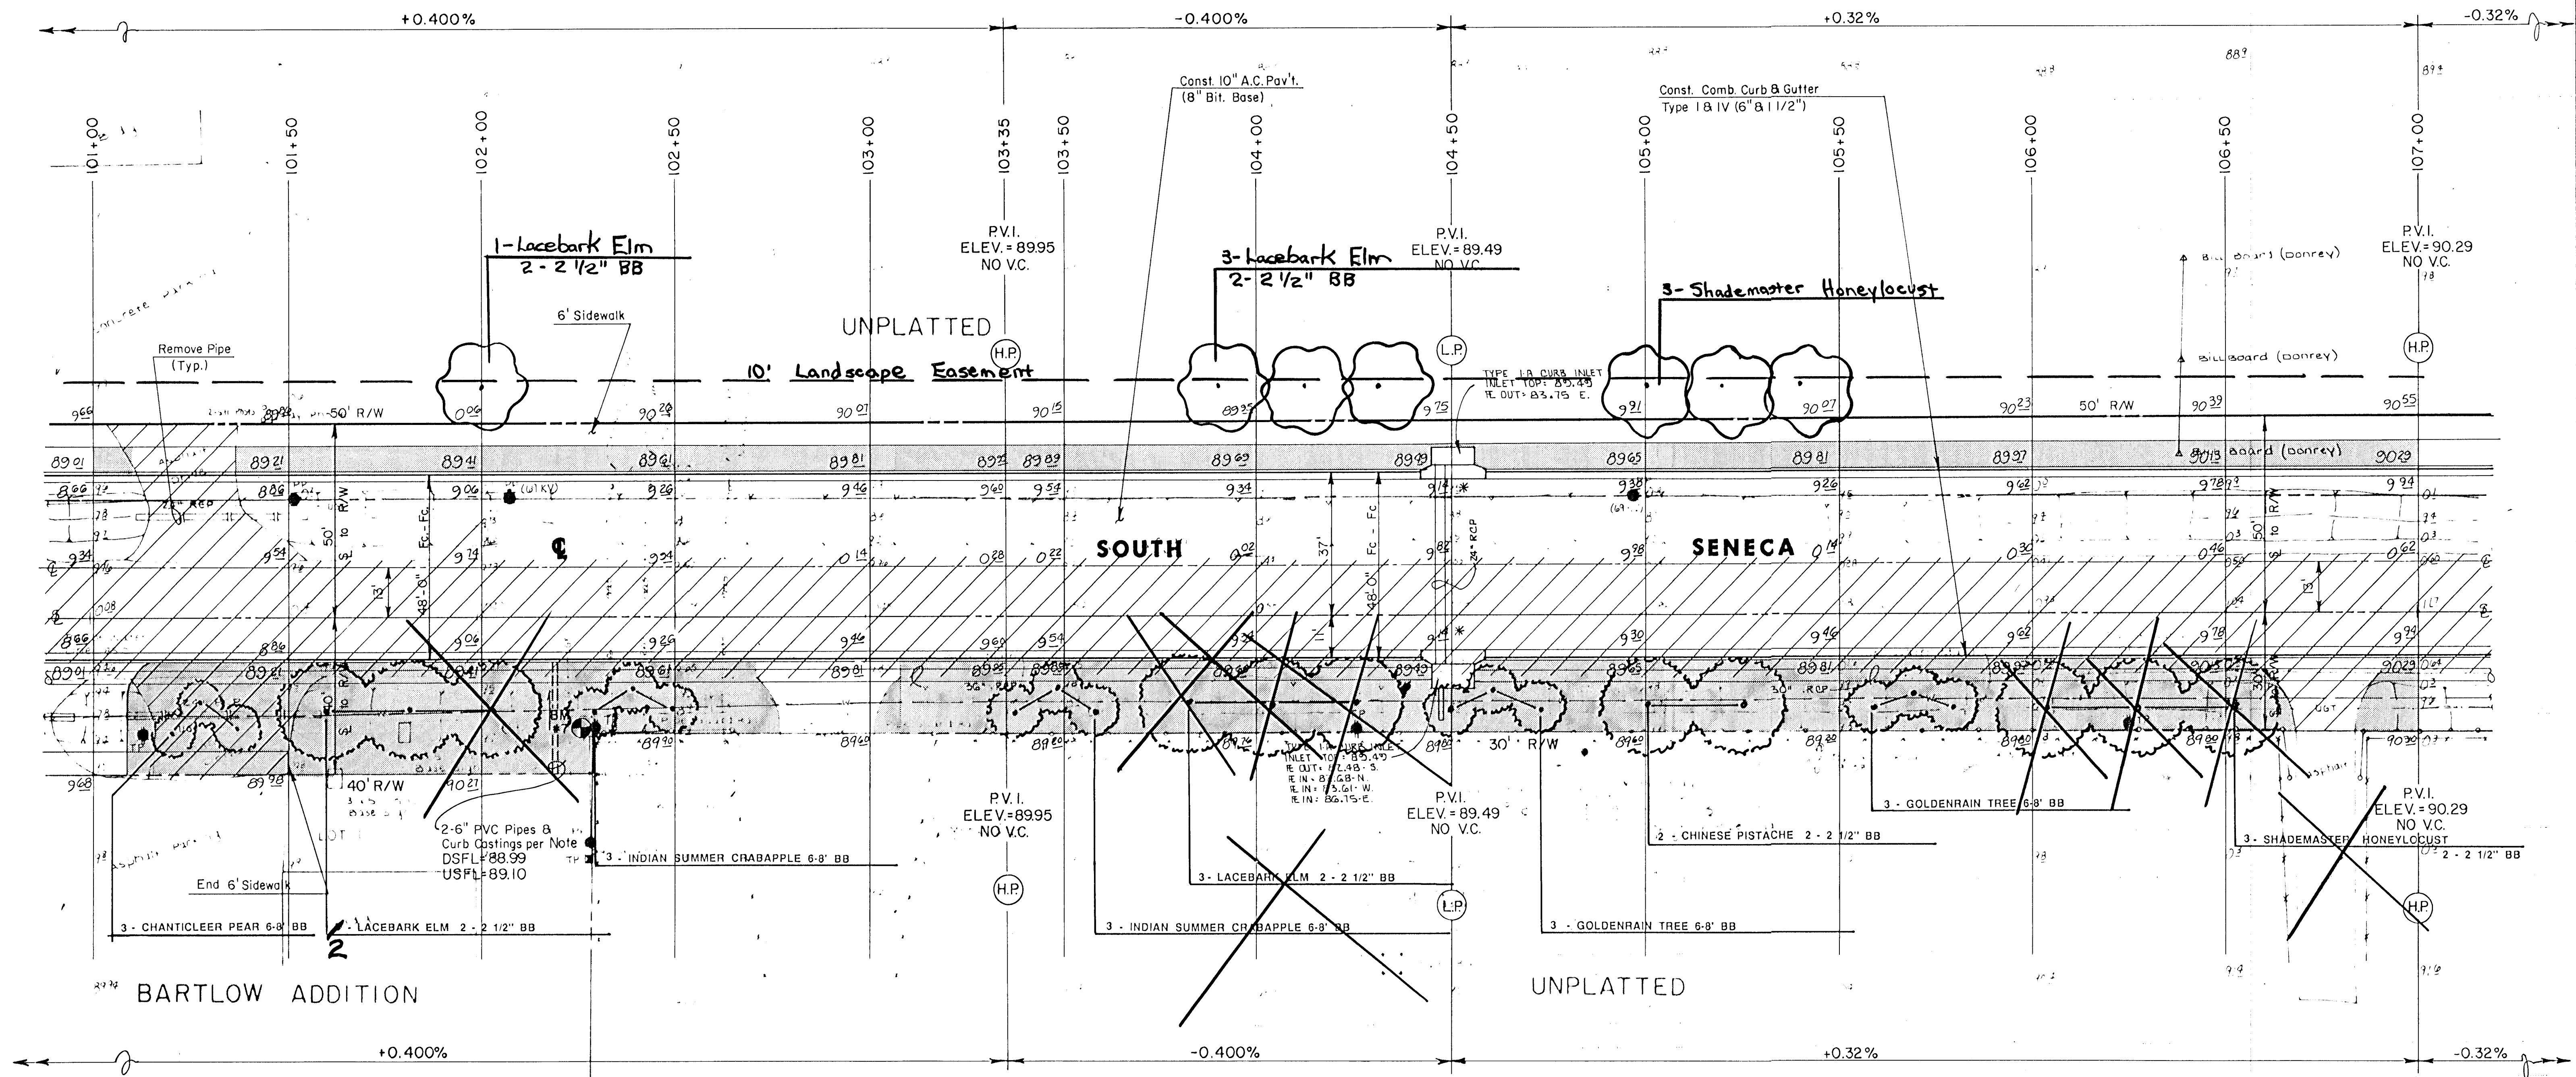

Scale: 1" = 20'



Note: Install 2 Curb Castings, Deeter #2449-B or approved equal, at curb & gutter. Casting units shall be bolted & anchored with galvanized 3/8" x 1 3/4" #2-1/2 bolts, respectively. Castings shall be painted two coats of grey paint, applied in accordance with manufacturer's recommendation.

Note: 17 trees originally to be planted on the east side of Seneca are now to be placed on the west side of Seneca.

* For 2" Depression, subtract 0.31' from H.E. (0.17' from gutter IL)

	SOUTH SENECA IMPROVEMENTS		Design
	LANDSCAPE PLAN		Drawn by
			Checked by
	48TH ST. SO. TO MACARTHUR RD.		Date
MID-KANSAS ENGINEERING CONSULTANTS PA 3500 NORTH ROCK ROAD BUILDING #800 WICHITA, KANSAS 67226		636-5566	Sheet 3 of 8

89-33-113E