


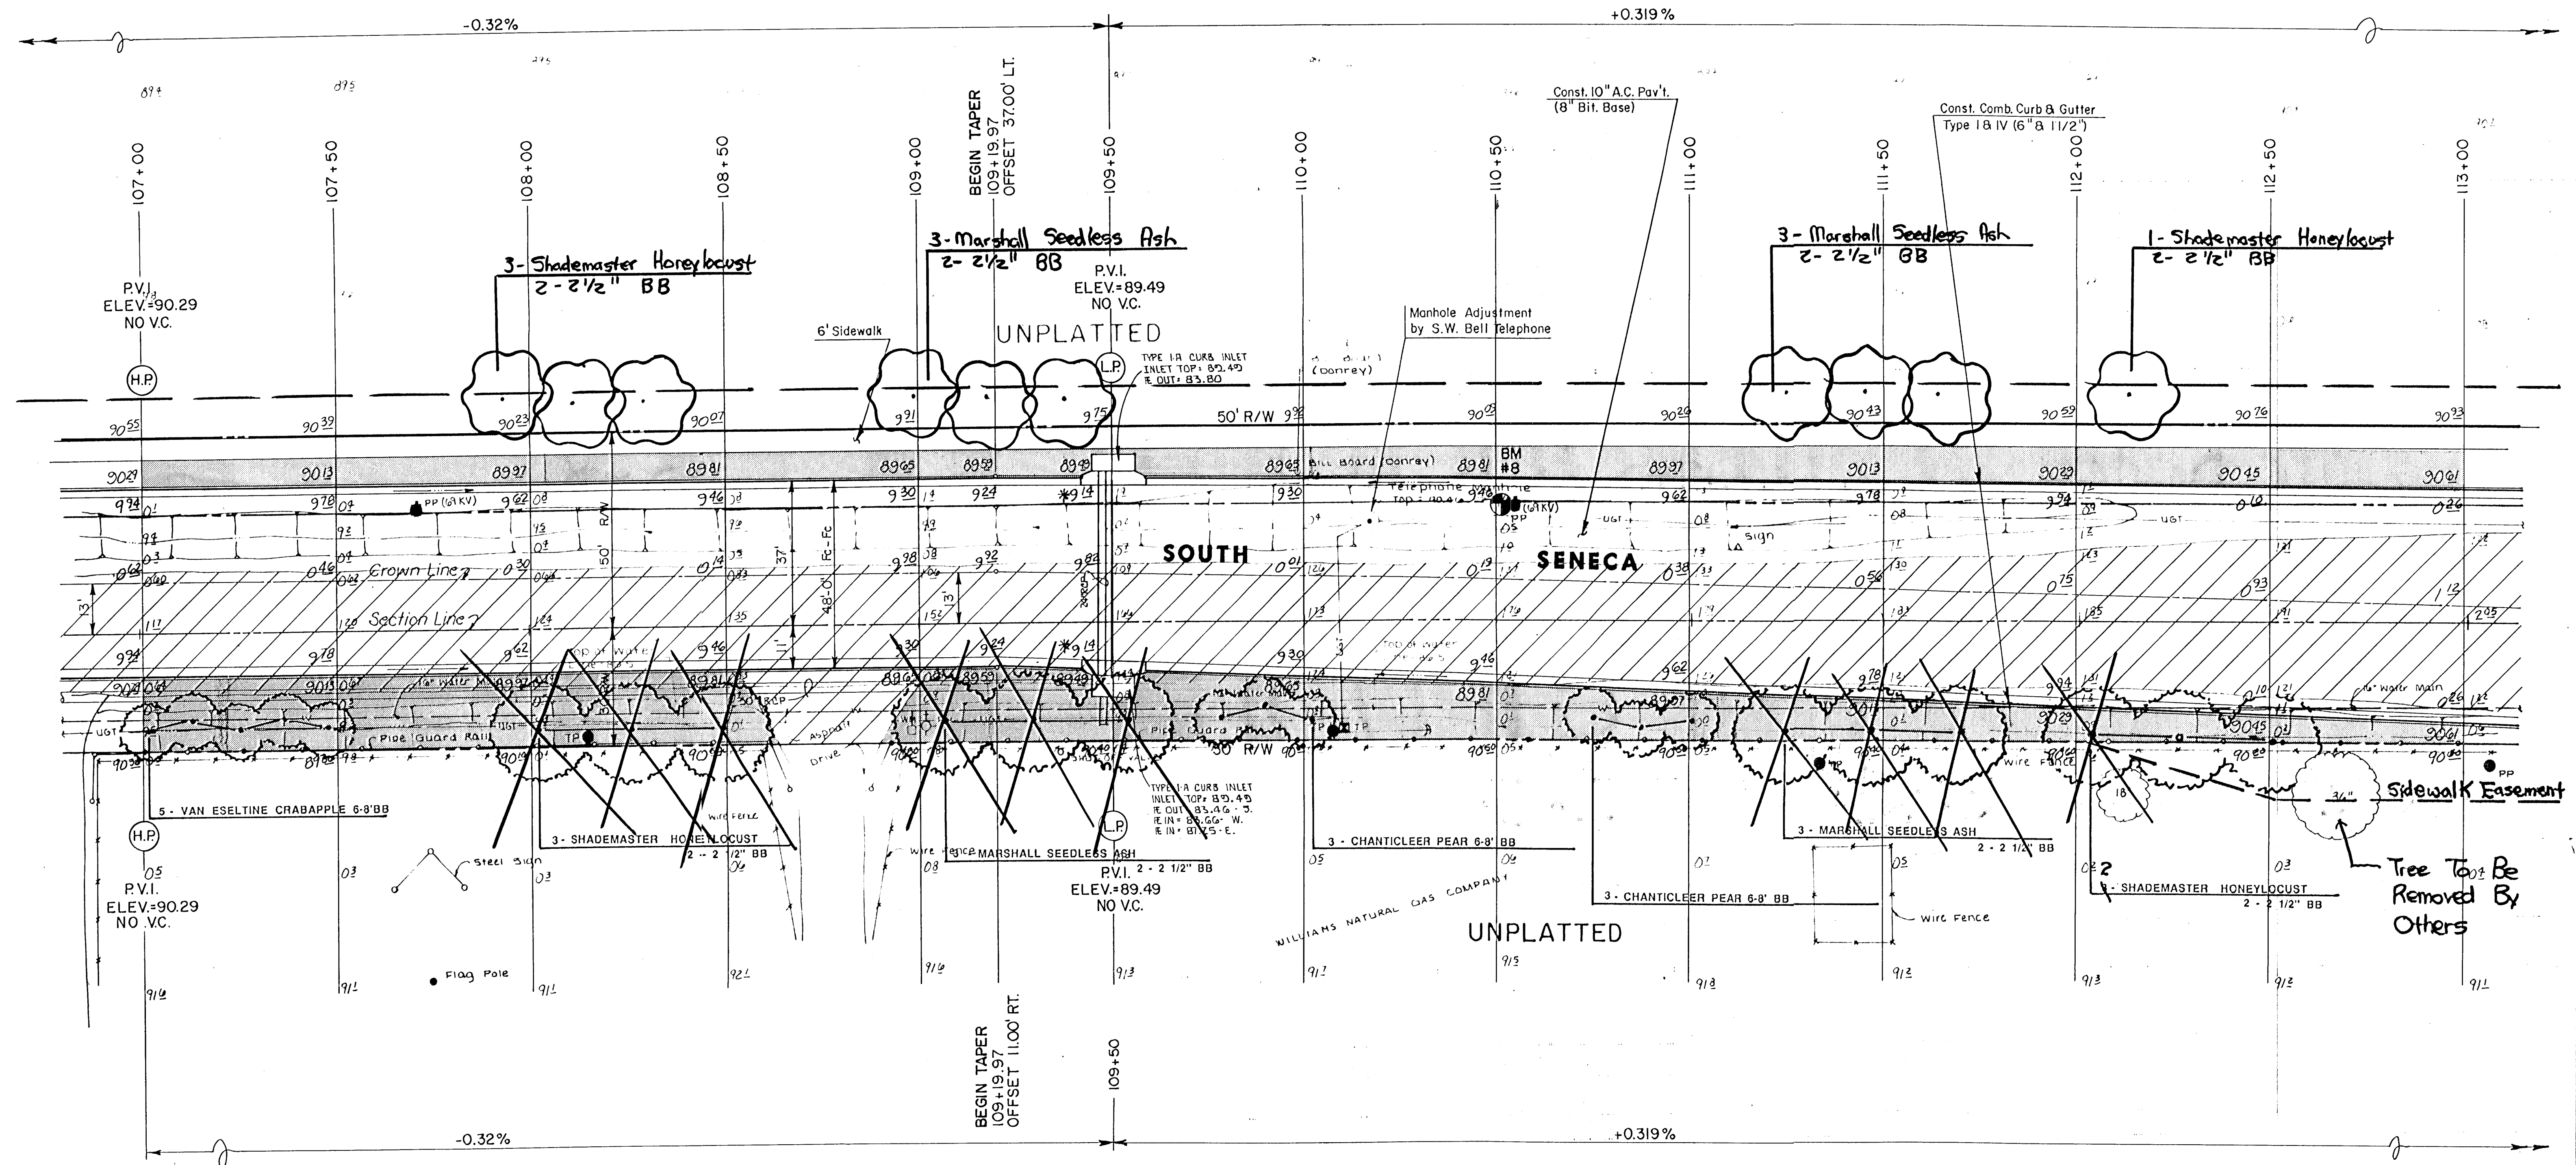

*For 2" depression, Subtract 0.31' from H.E. (0.17' from gutter H.E.)

	SOUTH SENECA IMPROVEMENTS	Design	
	LANDSCAPE PLAN	Drawn by	EAF
		Checked by	
	48TH ST. SO. TO MACARTHUR RD.	Date	
MID-KANSAS ENGINEERING CONSULTANTS PA 3500 NORTH ROCK ROAD BUILDING #800 WICHITA, KANSAS 67226		Job no.	
636-5566		Sheet	4
		of	8

89-33-113E