

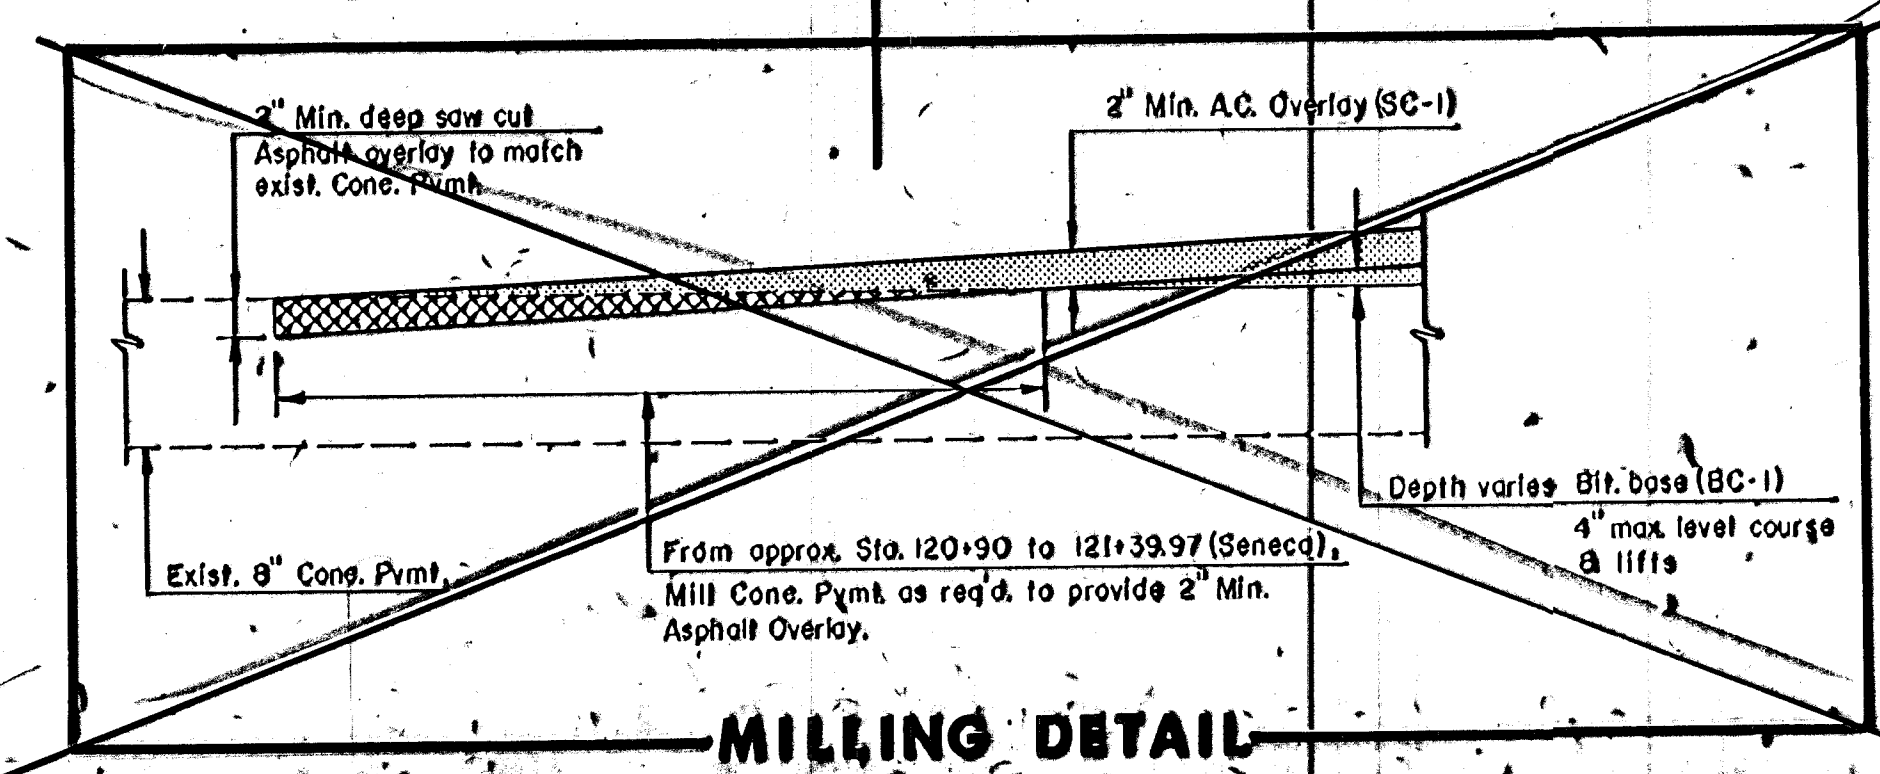


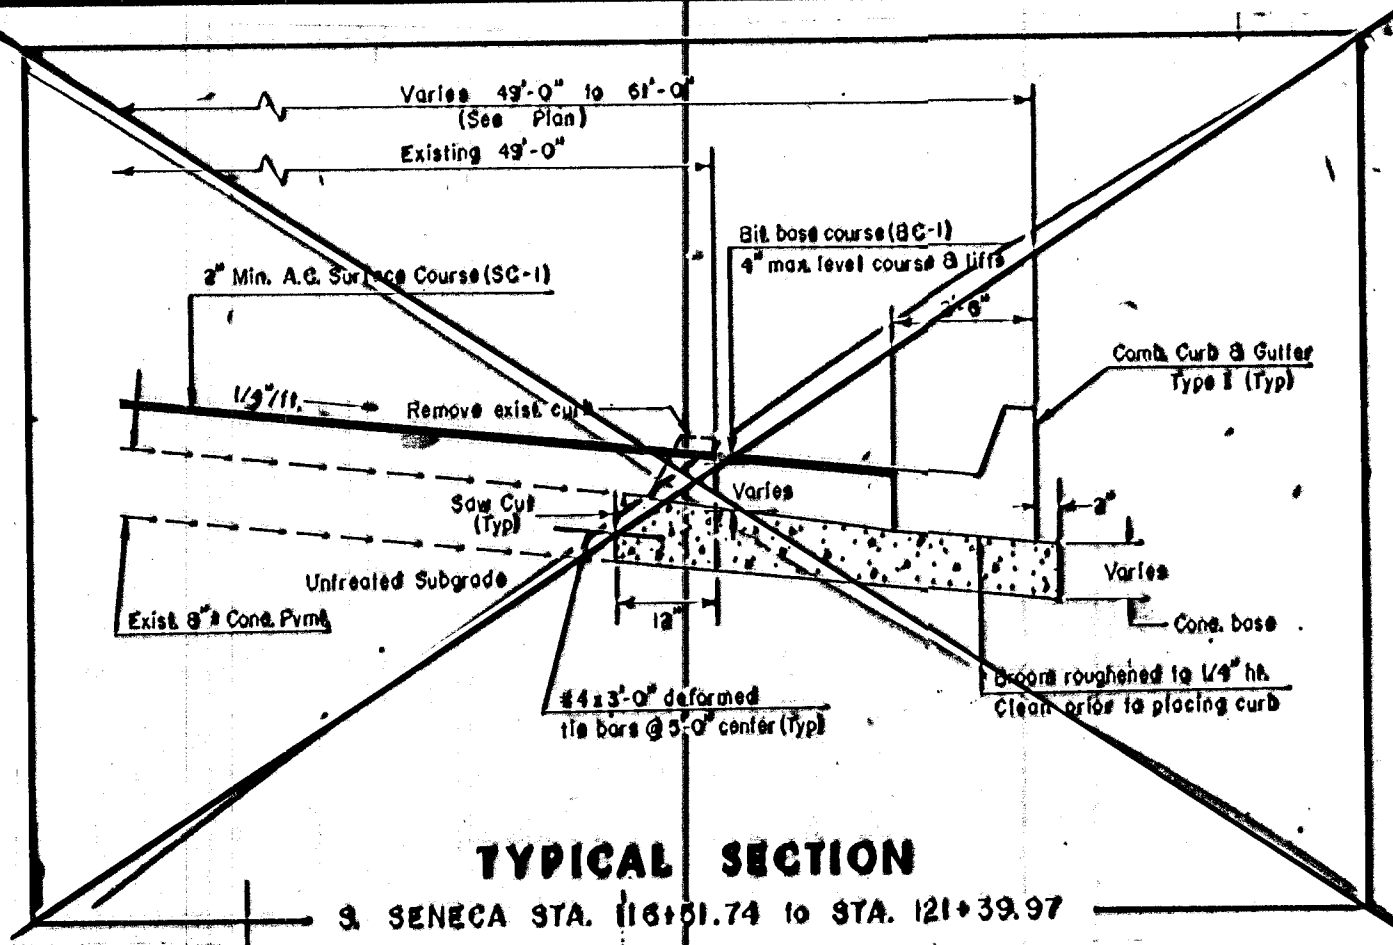

N
Scale: 1" = 20'

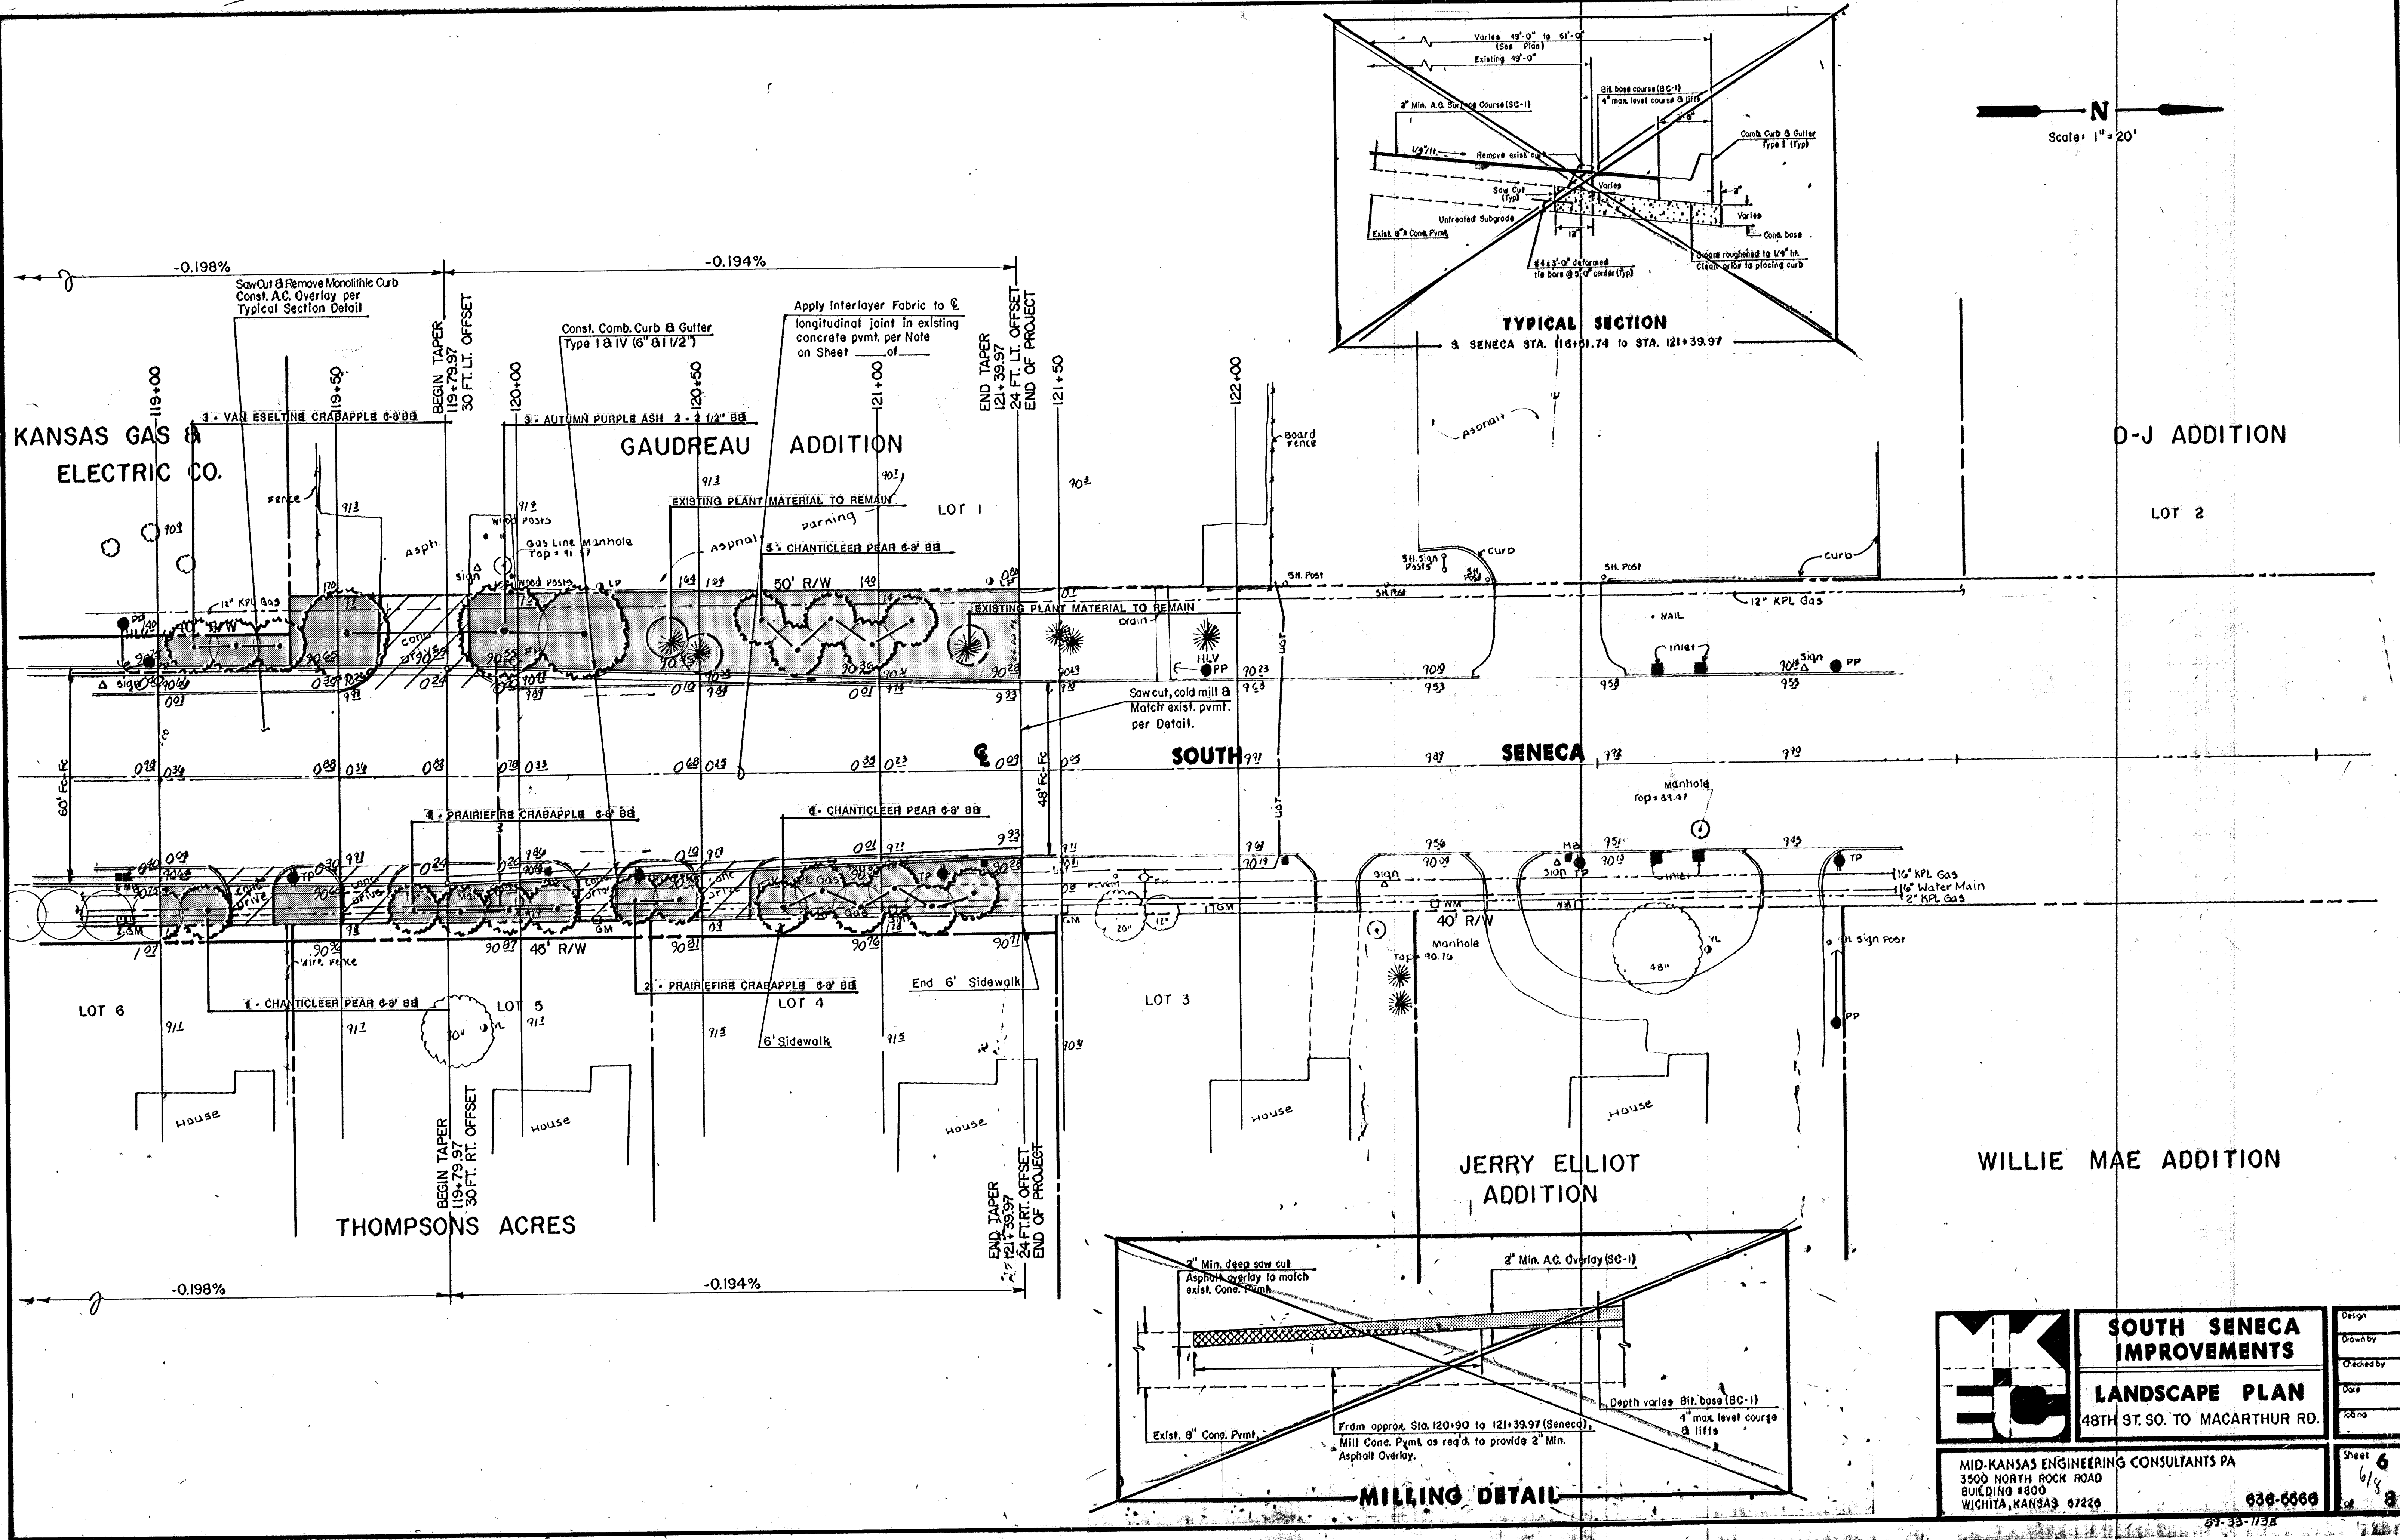

SOUTH SENECA IMPROVEMENTS
LANDSCAPE PLAN
48TH ST. SO. TO MACARTHUR RD.

MID-KANSAS ENGINEERING CONSULTANTS PA
3500 NORTH ROCK ROAD
BUILDING #800
WICHITA, KANSAS 67220
620-6660

Design	
Drawn by	
Checked by	
Date	
Job no.	
Sheet	6
	6/8
	8