
INDEX OF SHEETS

SHEET NO.:		
	1	TITLE SHEET
	2	GENERAL NOTES AND TYPICAL SECTIONS
	3-7	PLAN SHEETS
	8	CONC. PAVING PLAN
	9-10	STORM SEWER PROFILE SHEET
	11-13	INTERSECTION DETAILS
	14	SUMMARY OF QUANTITIES
	15	SUMMARY OF QUANTITIES (SURFACING)
	16-20	TEMPORARY WATER POLLUTION CONTROL
	21	EROSION CONTROL (SEEDING)
	22	CURB & GUTTER & COMB. CURB & GUTTER
	23	SIDEWALK & STEPS
	24	CONC. PAVEMENT, DOWEL JOINTED, NON-REINFORCED
	25	CONTRACTION AND EXPANSION JOINTS
	26	STANDARD DRIVE ENTRANCE
	27	PRE-CAST MANHOLE
	28	R.C. MANHOLE
	29	TYPE 'I' CURB INLET
	30-31	REINFORCING STEEL FOR INLETS AND MANHOLES
	32	SCHEDULE OF INLETS AND MANHOLES
	33	TRAFFIC SIGNAL PLAN
	34	SIGNAL QUANTITIES SHEET
	35	SERVICE/JUNCTION BOX, CONTROLLER PAD DETAILS
	36	STEEL SIGNAL POLE ASSEMBLY DETAILS
	37	POWER POLE AND SPAN POLE ASSEMBLY
	38	LOOP DETECTORS
	39-44	TRAFFIC SIGNAL SPECIFICATIONS
	45	~~TRAFFIC SIGNAL SPECIFICATIONS~~ LIGHT POLE FOOTING
	46	PAVEMENT MARKING PLAN
	47	TYP. MISC. PAVEMENT MARKING DETAIL SHEEET
	48	SUMMARY AND RECAPITULATION OF PAVEMENT MARKING QUANTITIES
	49	TRAFFIC CONTROL -- GENERAL NOTES
	50	TYPICAL TRAFFIC CONTROL
	51-54	TRAFFIC CONTROL PLAN
	55	TEMPORARY TRAFFIC SIGNAL PLAN
	56	SUMMARY OF DEVICES AND RECAPITULATION OF QUANTITIES
	57	I-104 ("GIVE 'EM A BREAK") SIGN
	58	DESIGN DETAILS FOR BARRICADES
	59	TYPICAL TRAFFIC CONTROL SIGNS
	60-68	CROSS-SECTIONS

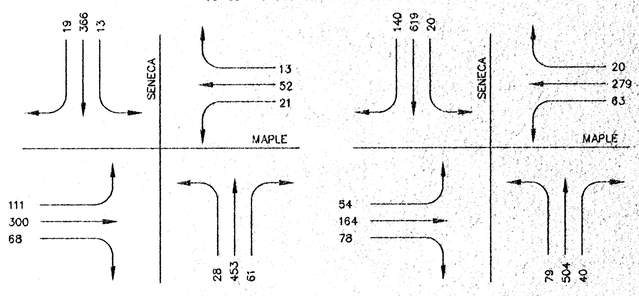

A.M. PEAK HOUR
7:15 A.M. TO 8:15 A.M.

P.M. PEAK HOUR
4:30 P.M. TO 5:30 P.M.


DESIGN DESIGNATION

MAPLE & SENECA

AADT (1994) = 21,333
AADT (2010) = 28,500
T = 3 %
V = 60 KM/HOUR
CLEAR ZONE = 1.8 M

CONVENTIONAL SIGNS

COUNTY LINE	CENTER LINE OF PROJECT
CITY LIMITS	TERRACE
STATE OR NATIONAL LINE	CULVERTS
TOWNSHIP, SECTION or GRANT LINE	DROP INLET & STORM SEWER
PROPERTY LINE	ACCESS CONTROL
HIGHWAY FENCE	POWER POLE
EXISTING FENCE	TELEPHONE POLE
GUARD FENCE	MARSH
CONSTRUCTION LIMITS	HEDGE
RIGHT OF WAY LINE	TREES
TRAVELED WAY	PROFILE ELEVATION
RAILROADS	STREAM or CREEK

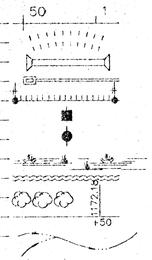



STATE OF KANSAS
DEPARTMENT OF TRANSPORTATION

PLAN AND PROFILE OF PROPOSED
FEDERAL AID PROJECT

SENECA AND MAPLE INTERSECTION
WICHITA, SEDGWICK COUNTY, KANSAS

POPULATION = 304,011

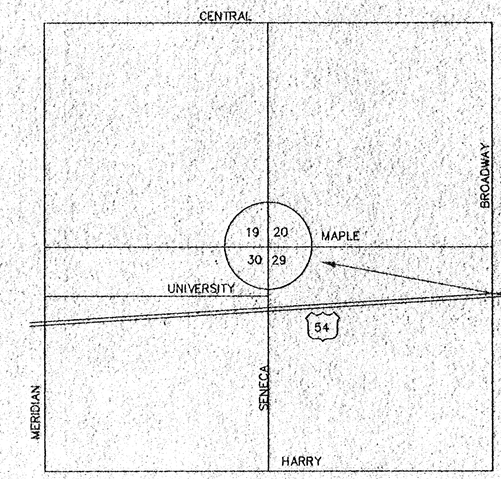

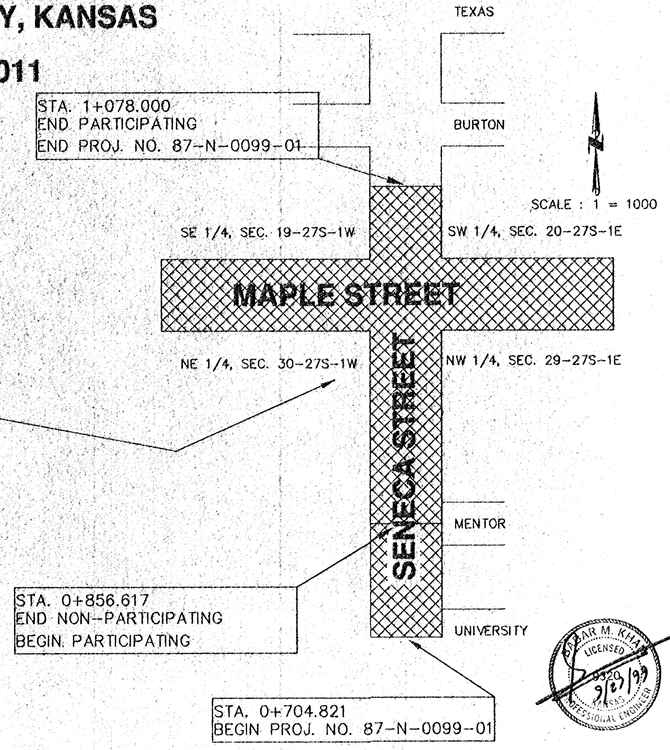

GROSS LENGTH OF PROJECT	373.179	m
EXCEPTIONS	0.00	
ADDITIONS	0.00	
NET LENGTH OF PROJECT	373.179	m
NET LENGTH OF BRIDGES	0.00	m
NET LENGTH OF ROAD	373.179	m

RECOM. FOR APPROVAL--DATE

CHIEF, BUREAU OF TRAFFIC ENGINEERING
KANSAS DEPARTMENT OF TRANSPORTATION

APPROVED -- DATE

STATE TRANSPORTATION ENGINEER
KANSAS DEPARTMENT OF TRANSPORTATION

FHWA REG. NO.	STATE	PROJECT NO.:	YEAR	SHEET NUMBER	TOTAL SHEETS
7	KANSAS	87 N-0099-01	1999	1	68

STP-N009(901)

GRADING
SURFACING
CONCRETE PAVEMENT
SEEDING
SIGNALIZATION
PAVEMENT MARKINGS

TRAFFIC TO BE CARRIED THROUGH CONSTRUCTION. SEE SHEETS 51-54 FOR CONSTRUCTION TRAFFIC CONTROL PLAN.

KDOT **METRIC**

All dimensions shown, without an SI suffix, are in millimeters. All elevations shown are in meters.

OMAR M. KHA
LICENSED
9320
9/27/99
PROFESSIONAL ENGINEER

APPROVED--DATE

MICHAEL E. LINDEBAK, P.E.
CITY ENGINEER
CITY OF WICHITA, SEDGWICK COUNTY, KANSAS

TITLE SHEET

SCALE:	APPROVED:	DRAWN BY:
DATE:		CHECKED:
PROJECT NO:		SHEET NO.:

MUNICIPAL ENGINEERS, P.A.
254-LAURA, SUITE 201, WICHITA, KANSAS 67211
316-262-5842 (TEL.)
316-262-5634 (FAX)