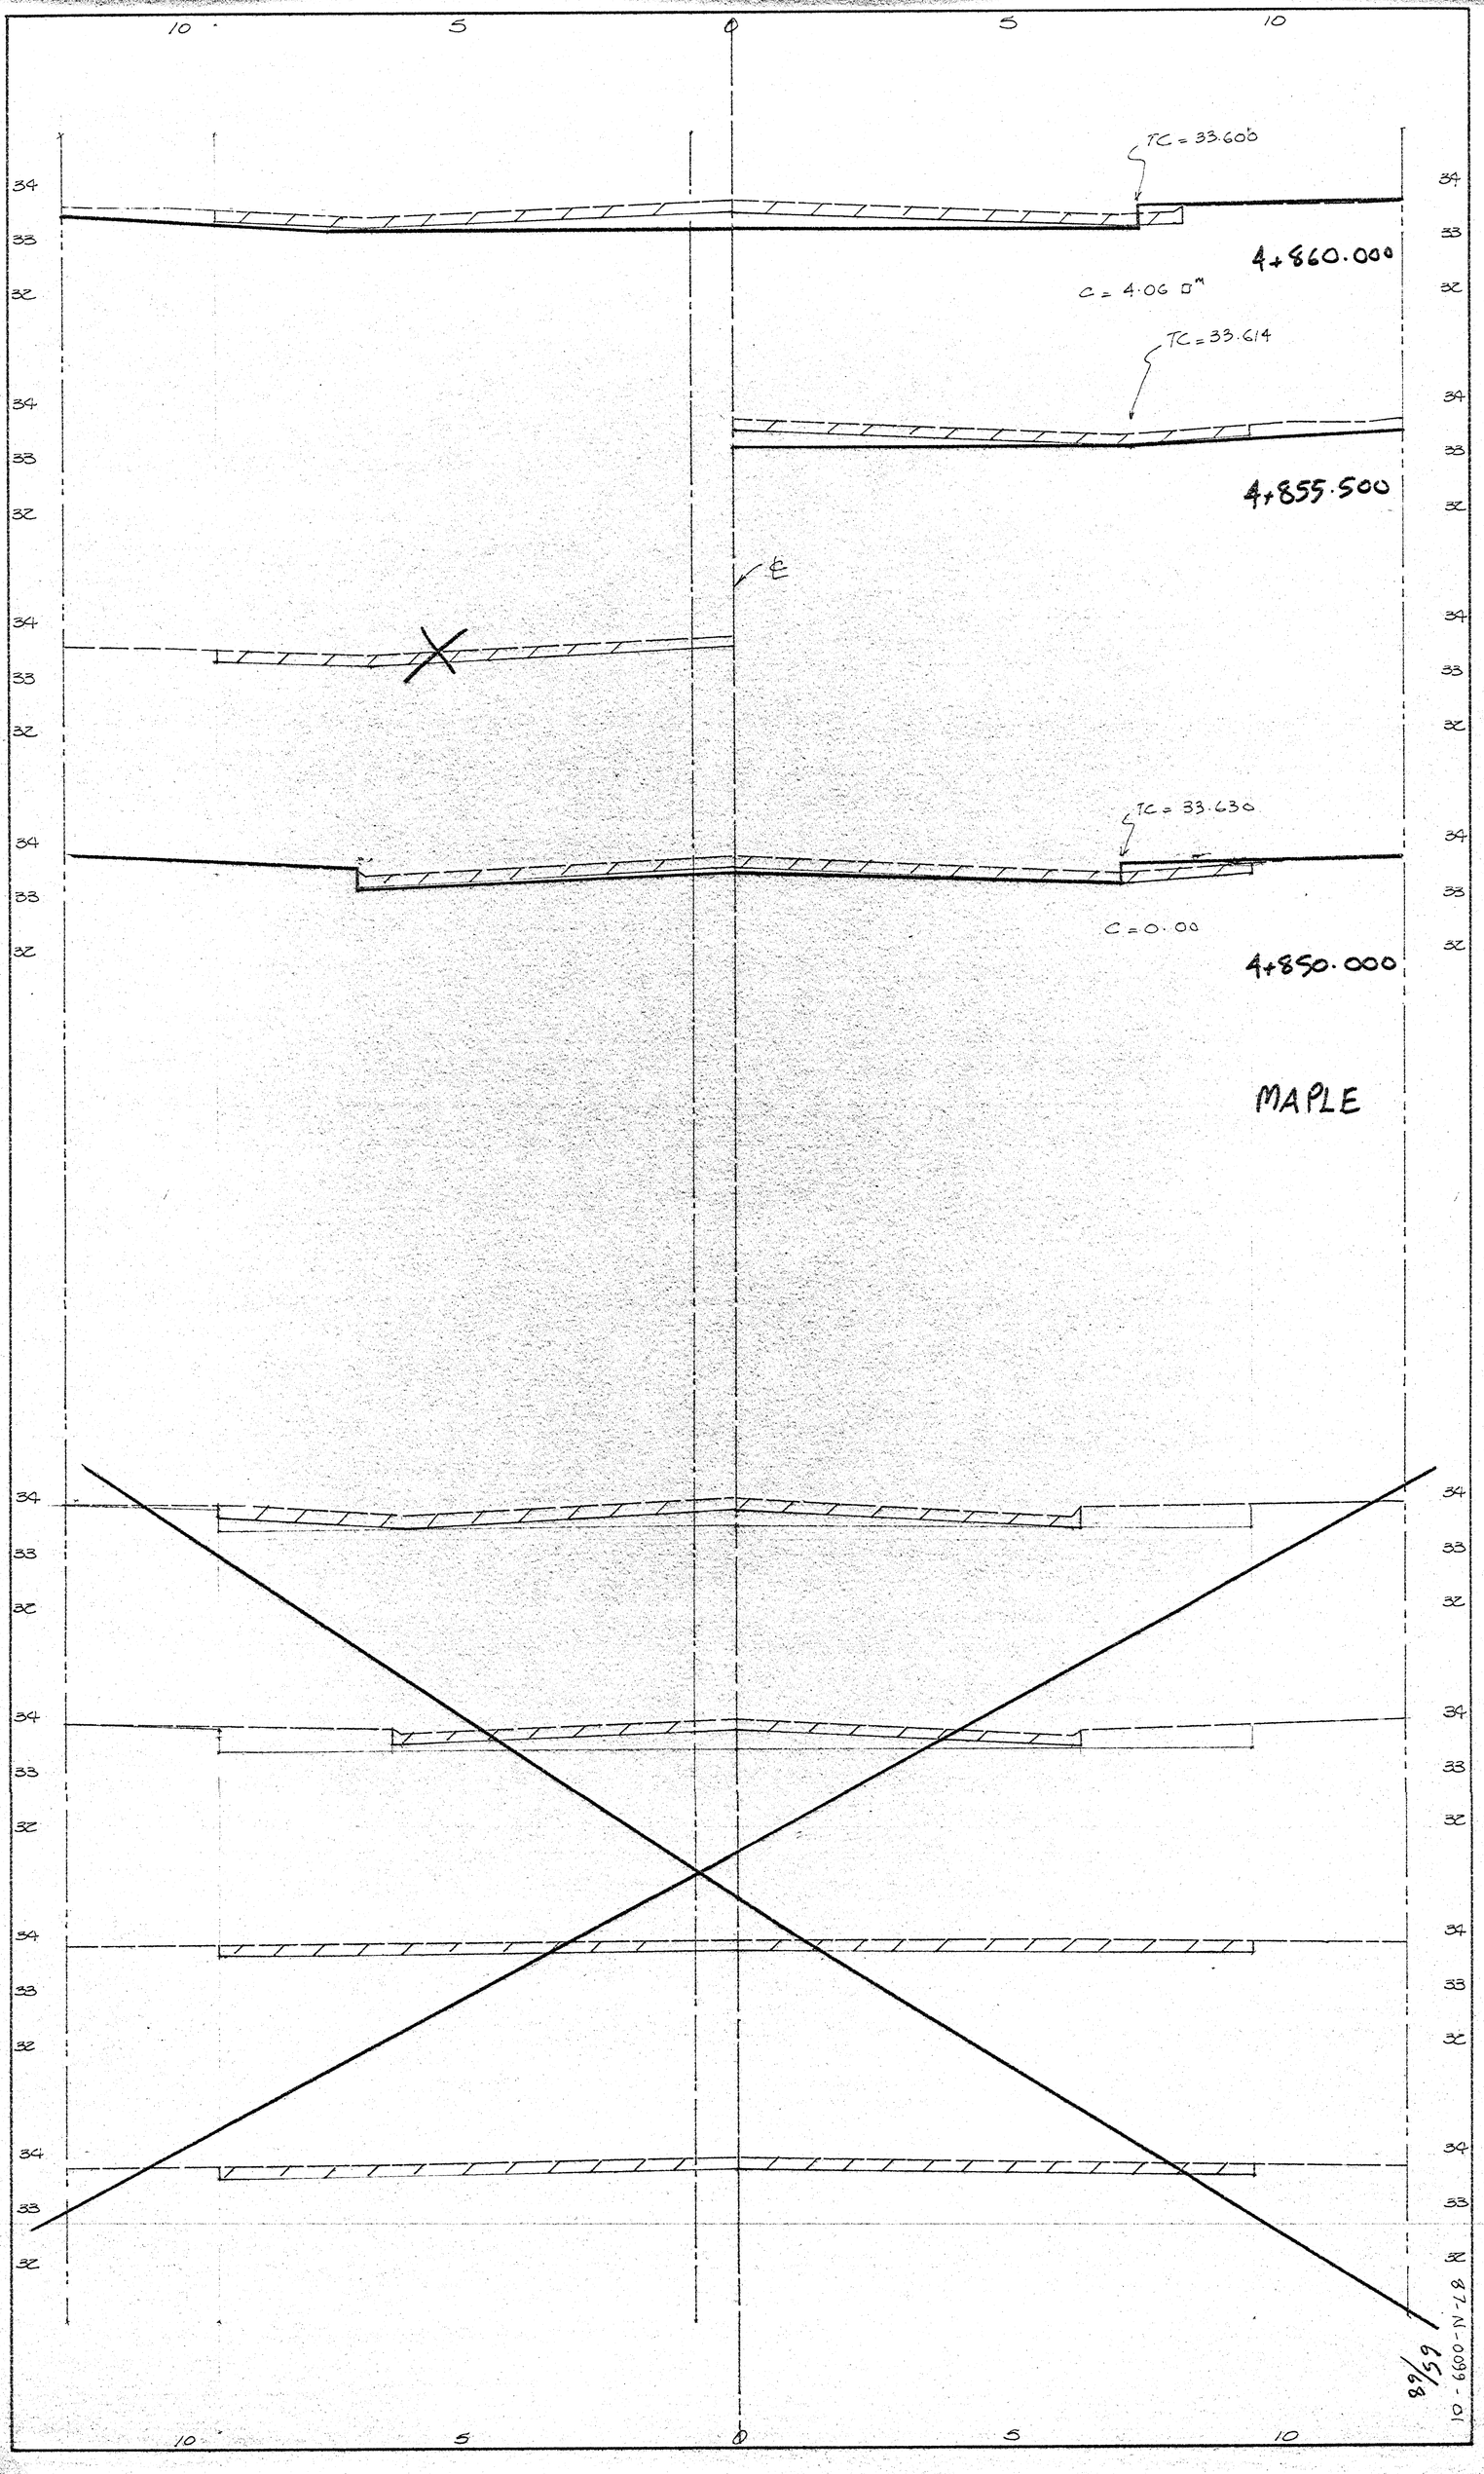

10
5
0
5
10
TC = 33.600
4+860.000
C = 4.06 DM
TC = 33.614
4+855.500
℄
TC = 33.630
C = 0.00
4+850.000
MAPLE
34
33
32
