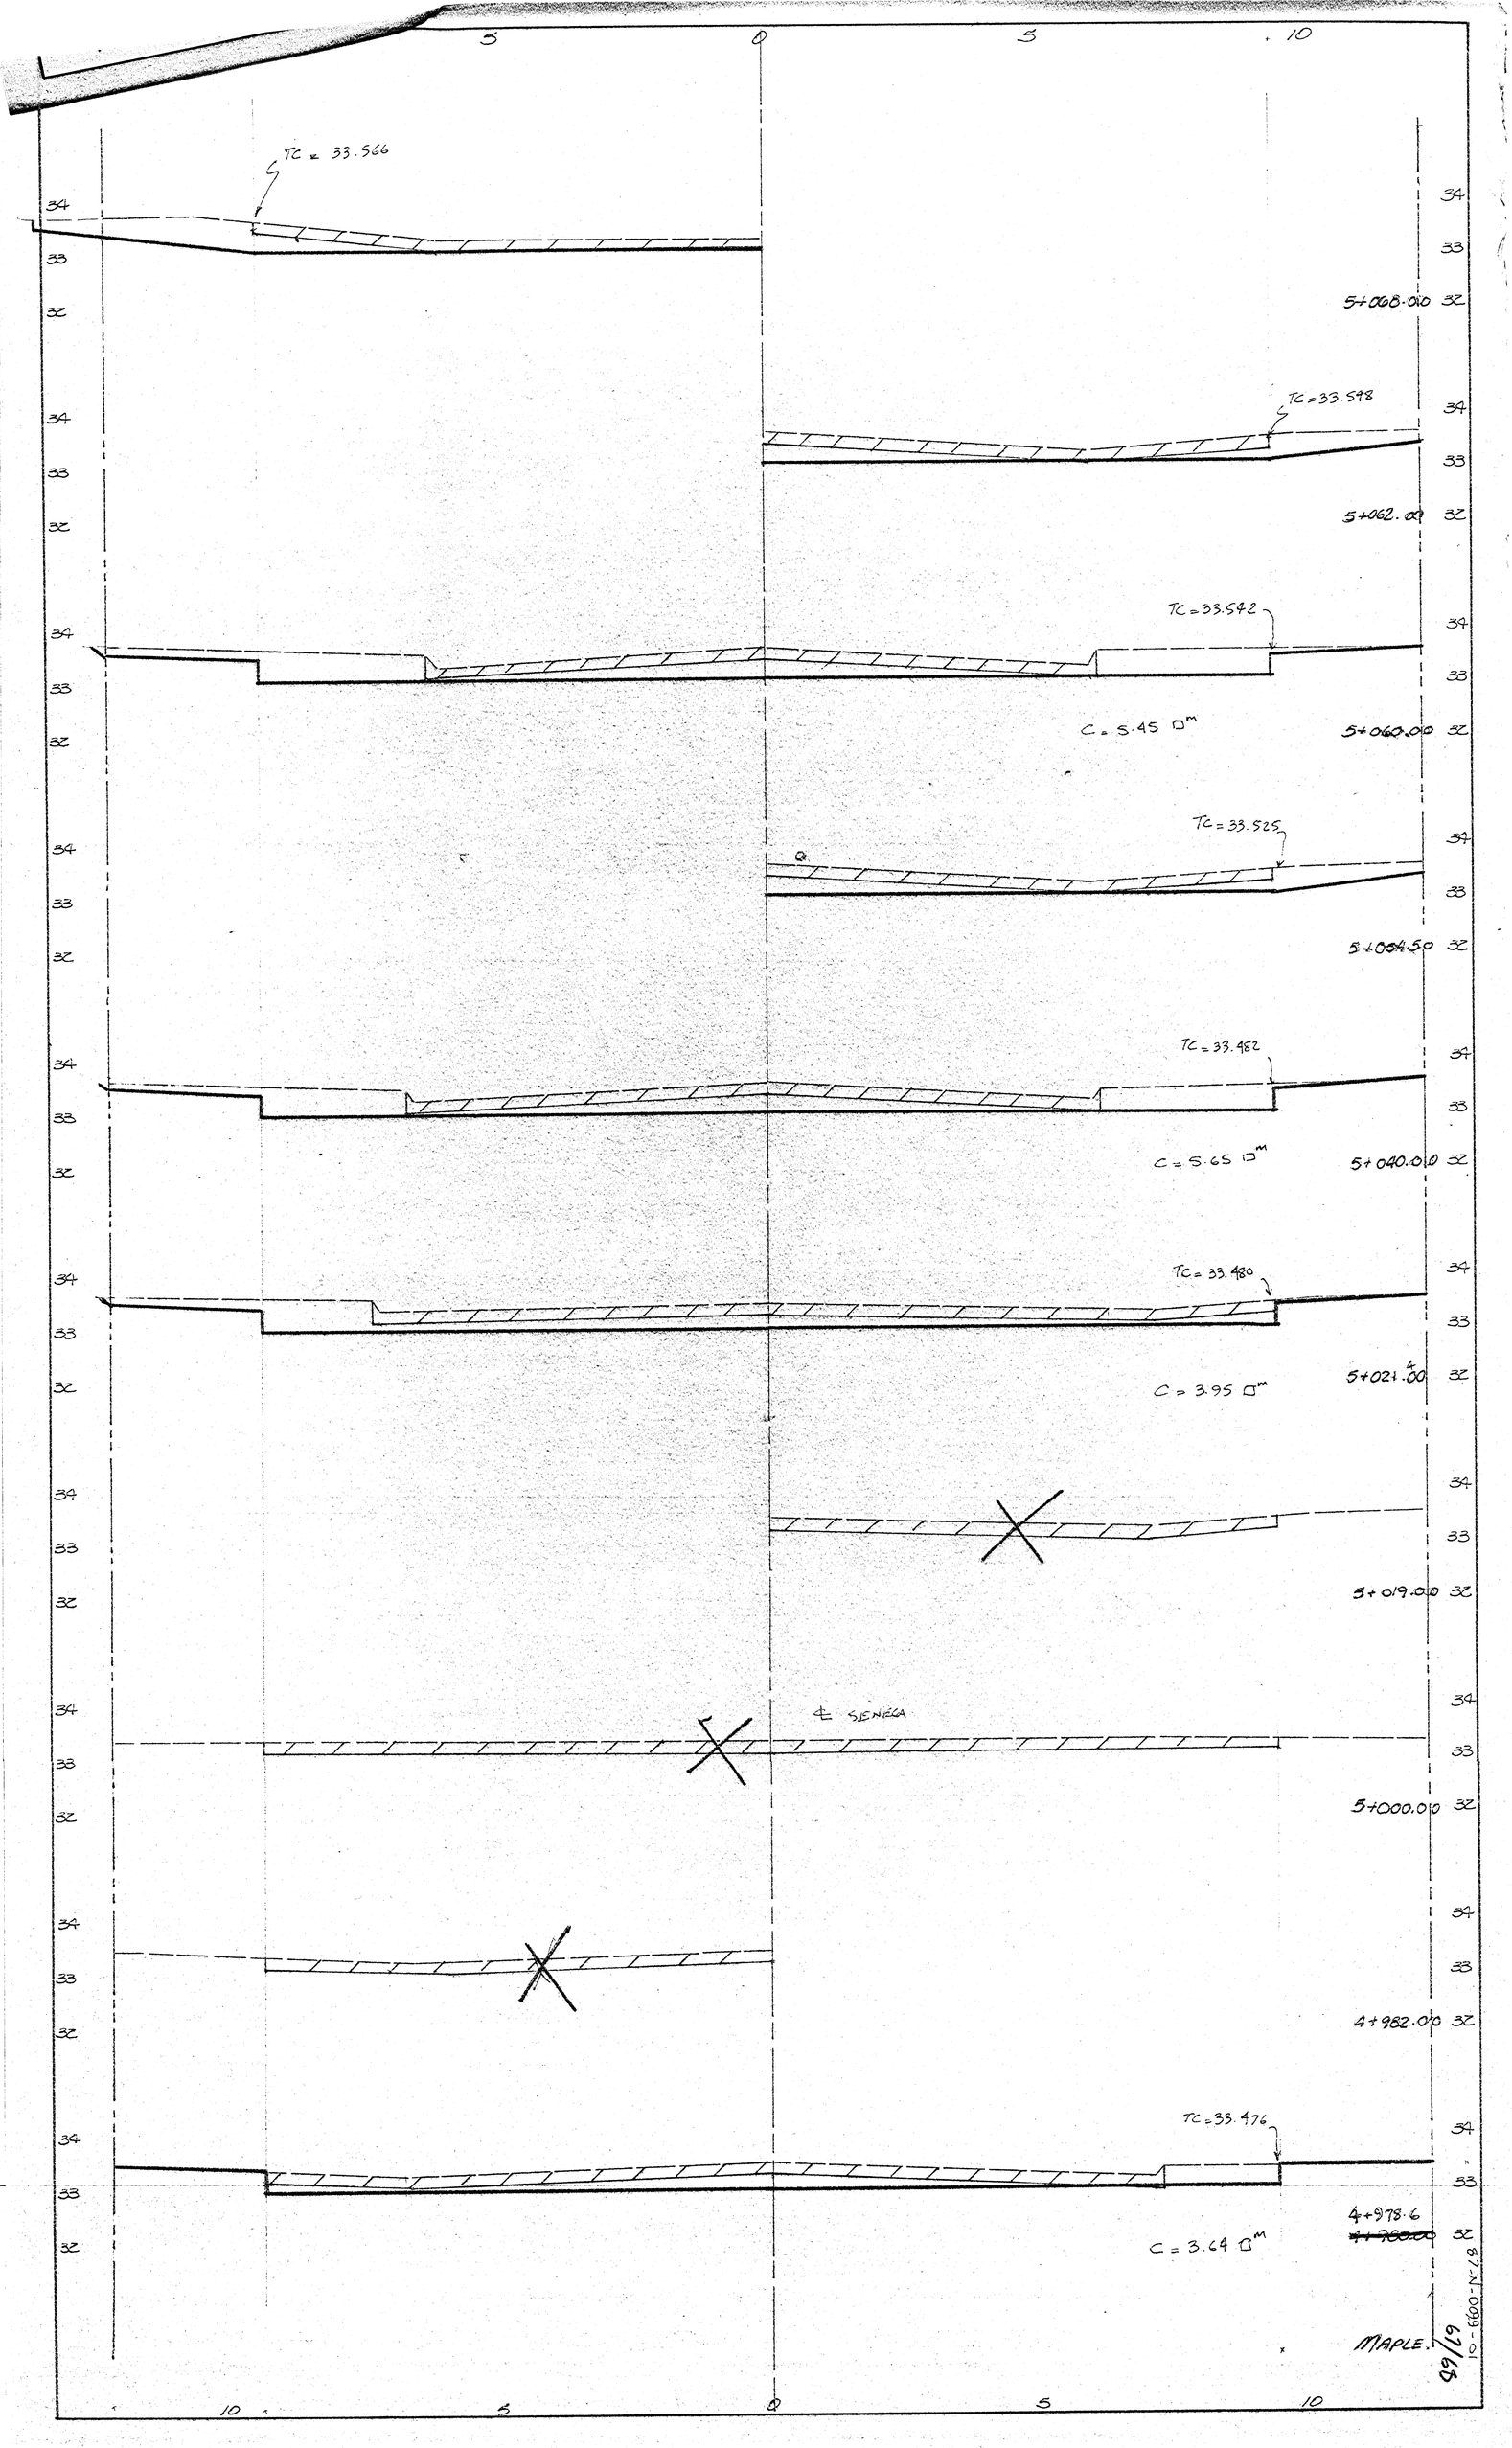


87-N-009-101

67/68