McG-6
✓ Int. Edwards & Central

H-3

(1-3)

Excavation

City
~~299.0~~
~~+10%~~
~~328.9~~ cu yds

Property
~~576.0~~
~~+10%~~
~~633.6~~ cu yds

B.M. 118.95 "G" in Globe W side Edwards. 50' S of Central

Note: Install 2-2'×5' c.b & connect with 15" pipe

Note: Install 3-2'×5' catch basins & 1 manhole
Connect with 15" pipe.

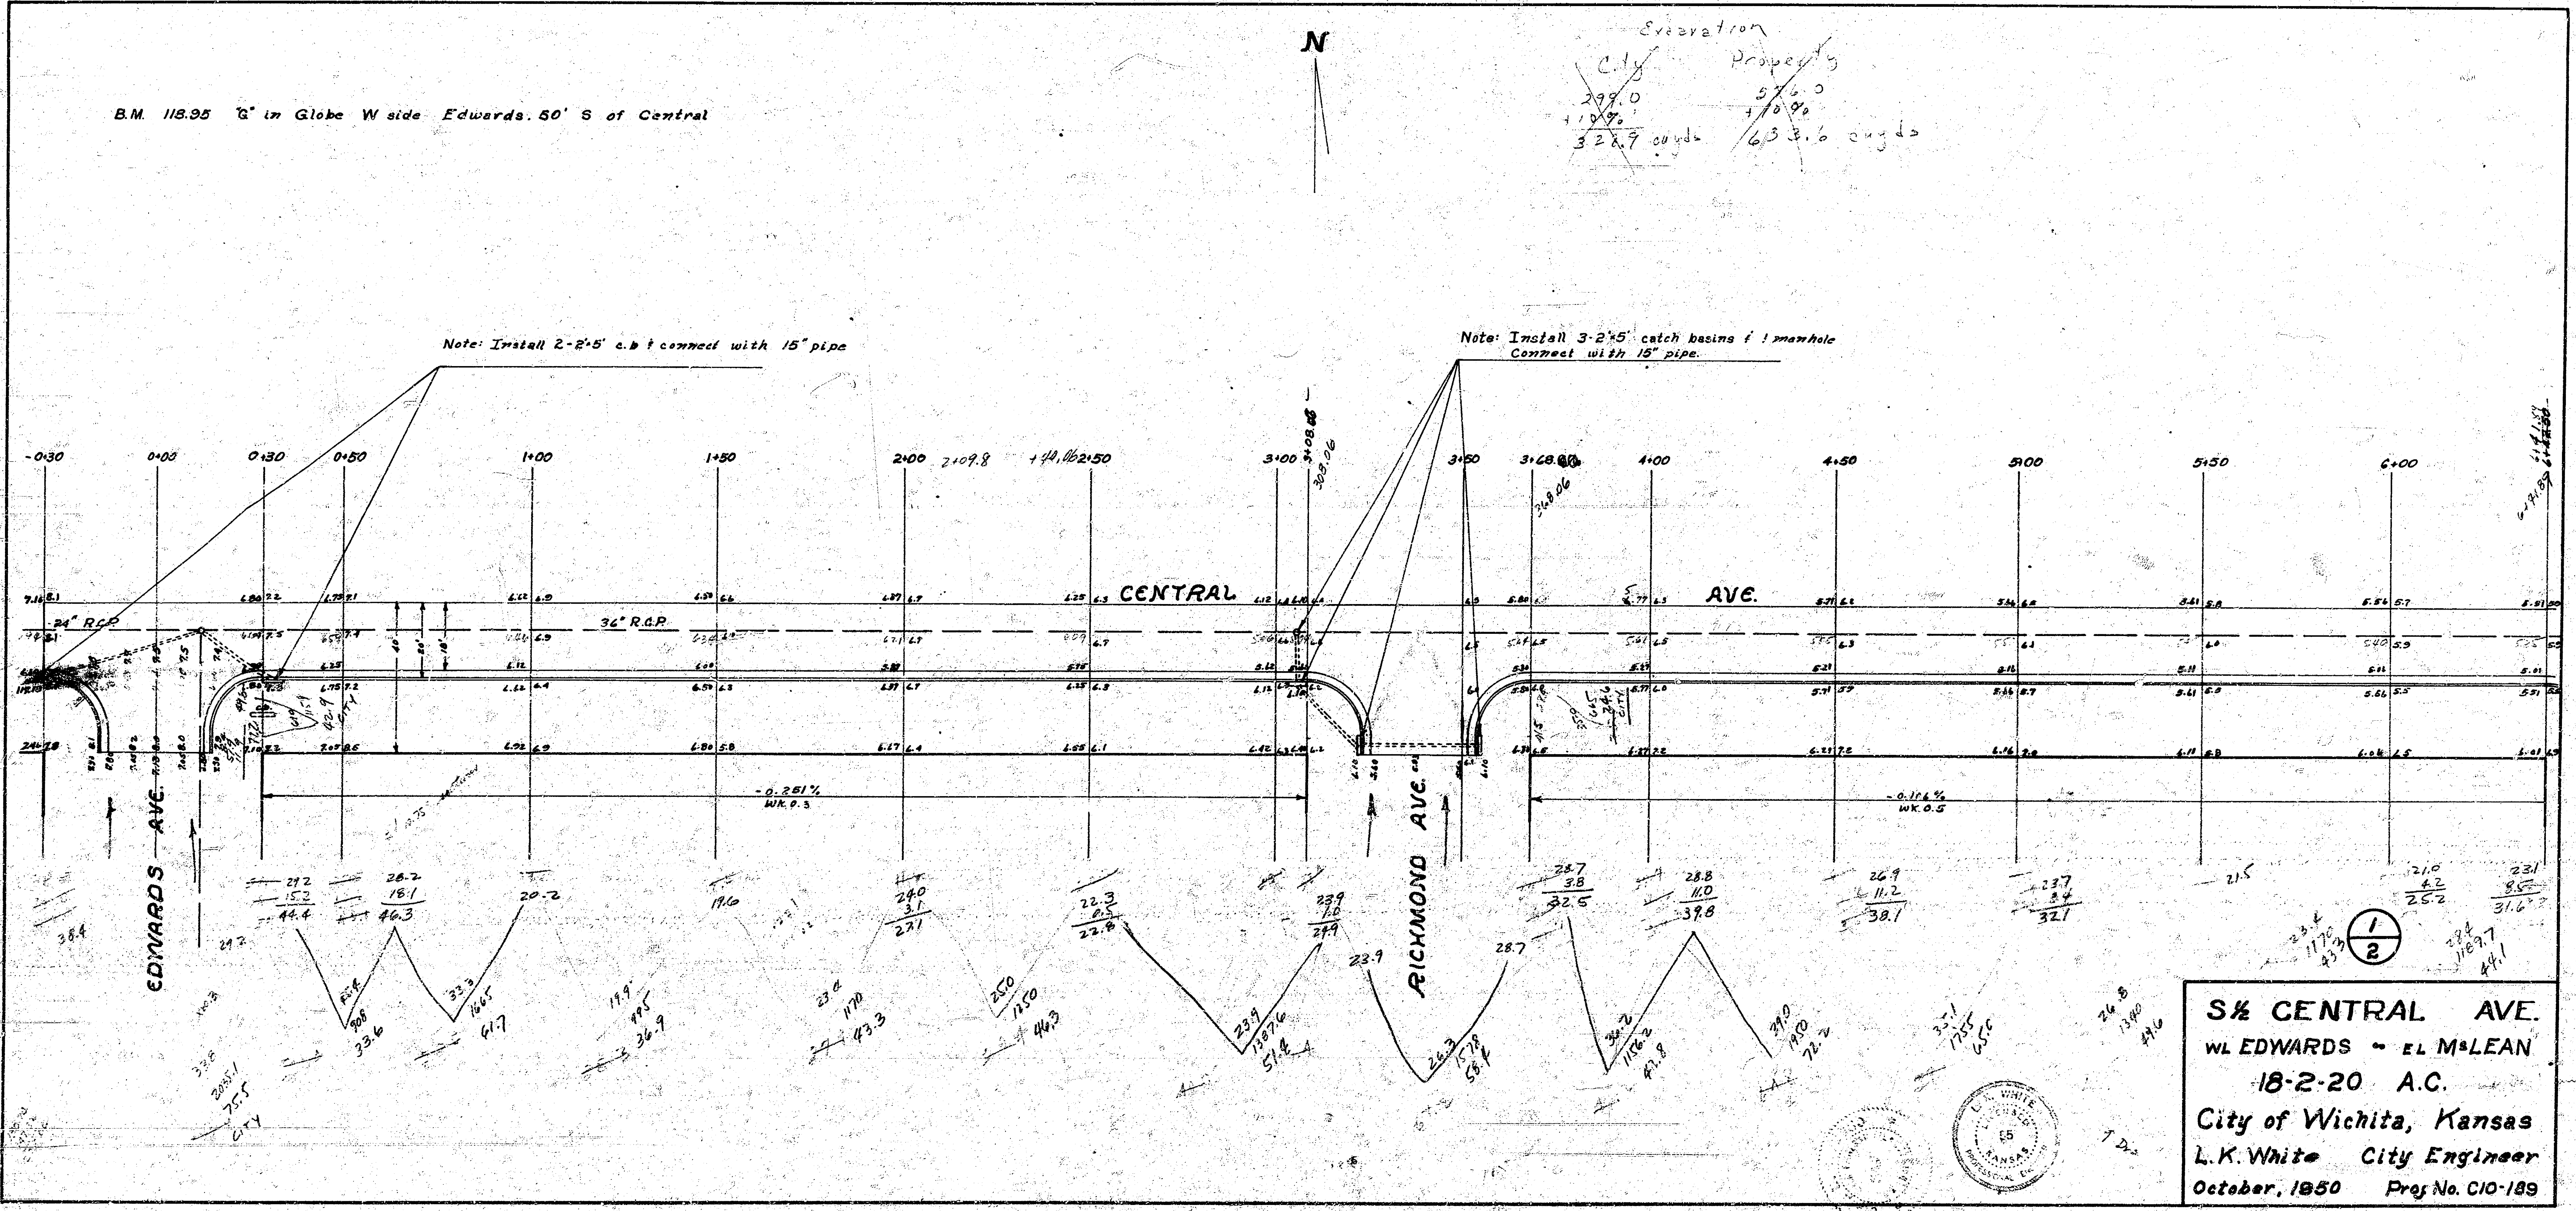

N
-0+30
0+00
0+30
0+50
1+00
1+50
2+00
2+50
3+00
3+50
3+68.86
4+00
4+50
5+00
5+50
6+00
CENTRAL AVE.
24" RCP
36" RCP
-0.281%
WK 0.3
-0.176%
WK 0.5
EDWARDS AVE.
RICHMOND AVE.
1/2

S½ CENTRAL AVE.
WL EDWARDS – EL McLEAN
18-2-20 A.C.
City of Wichita, Kansas
L.K. White City Engineer
October, 1950 Proj No. C10-189

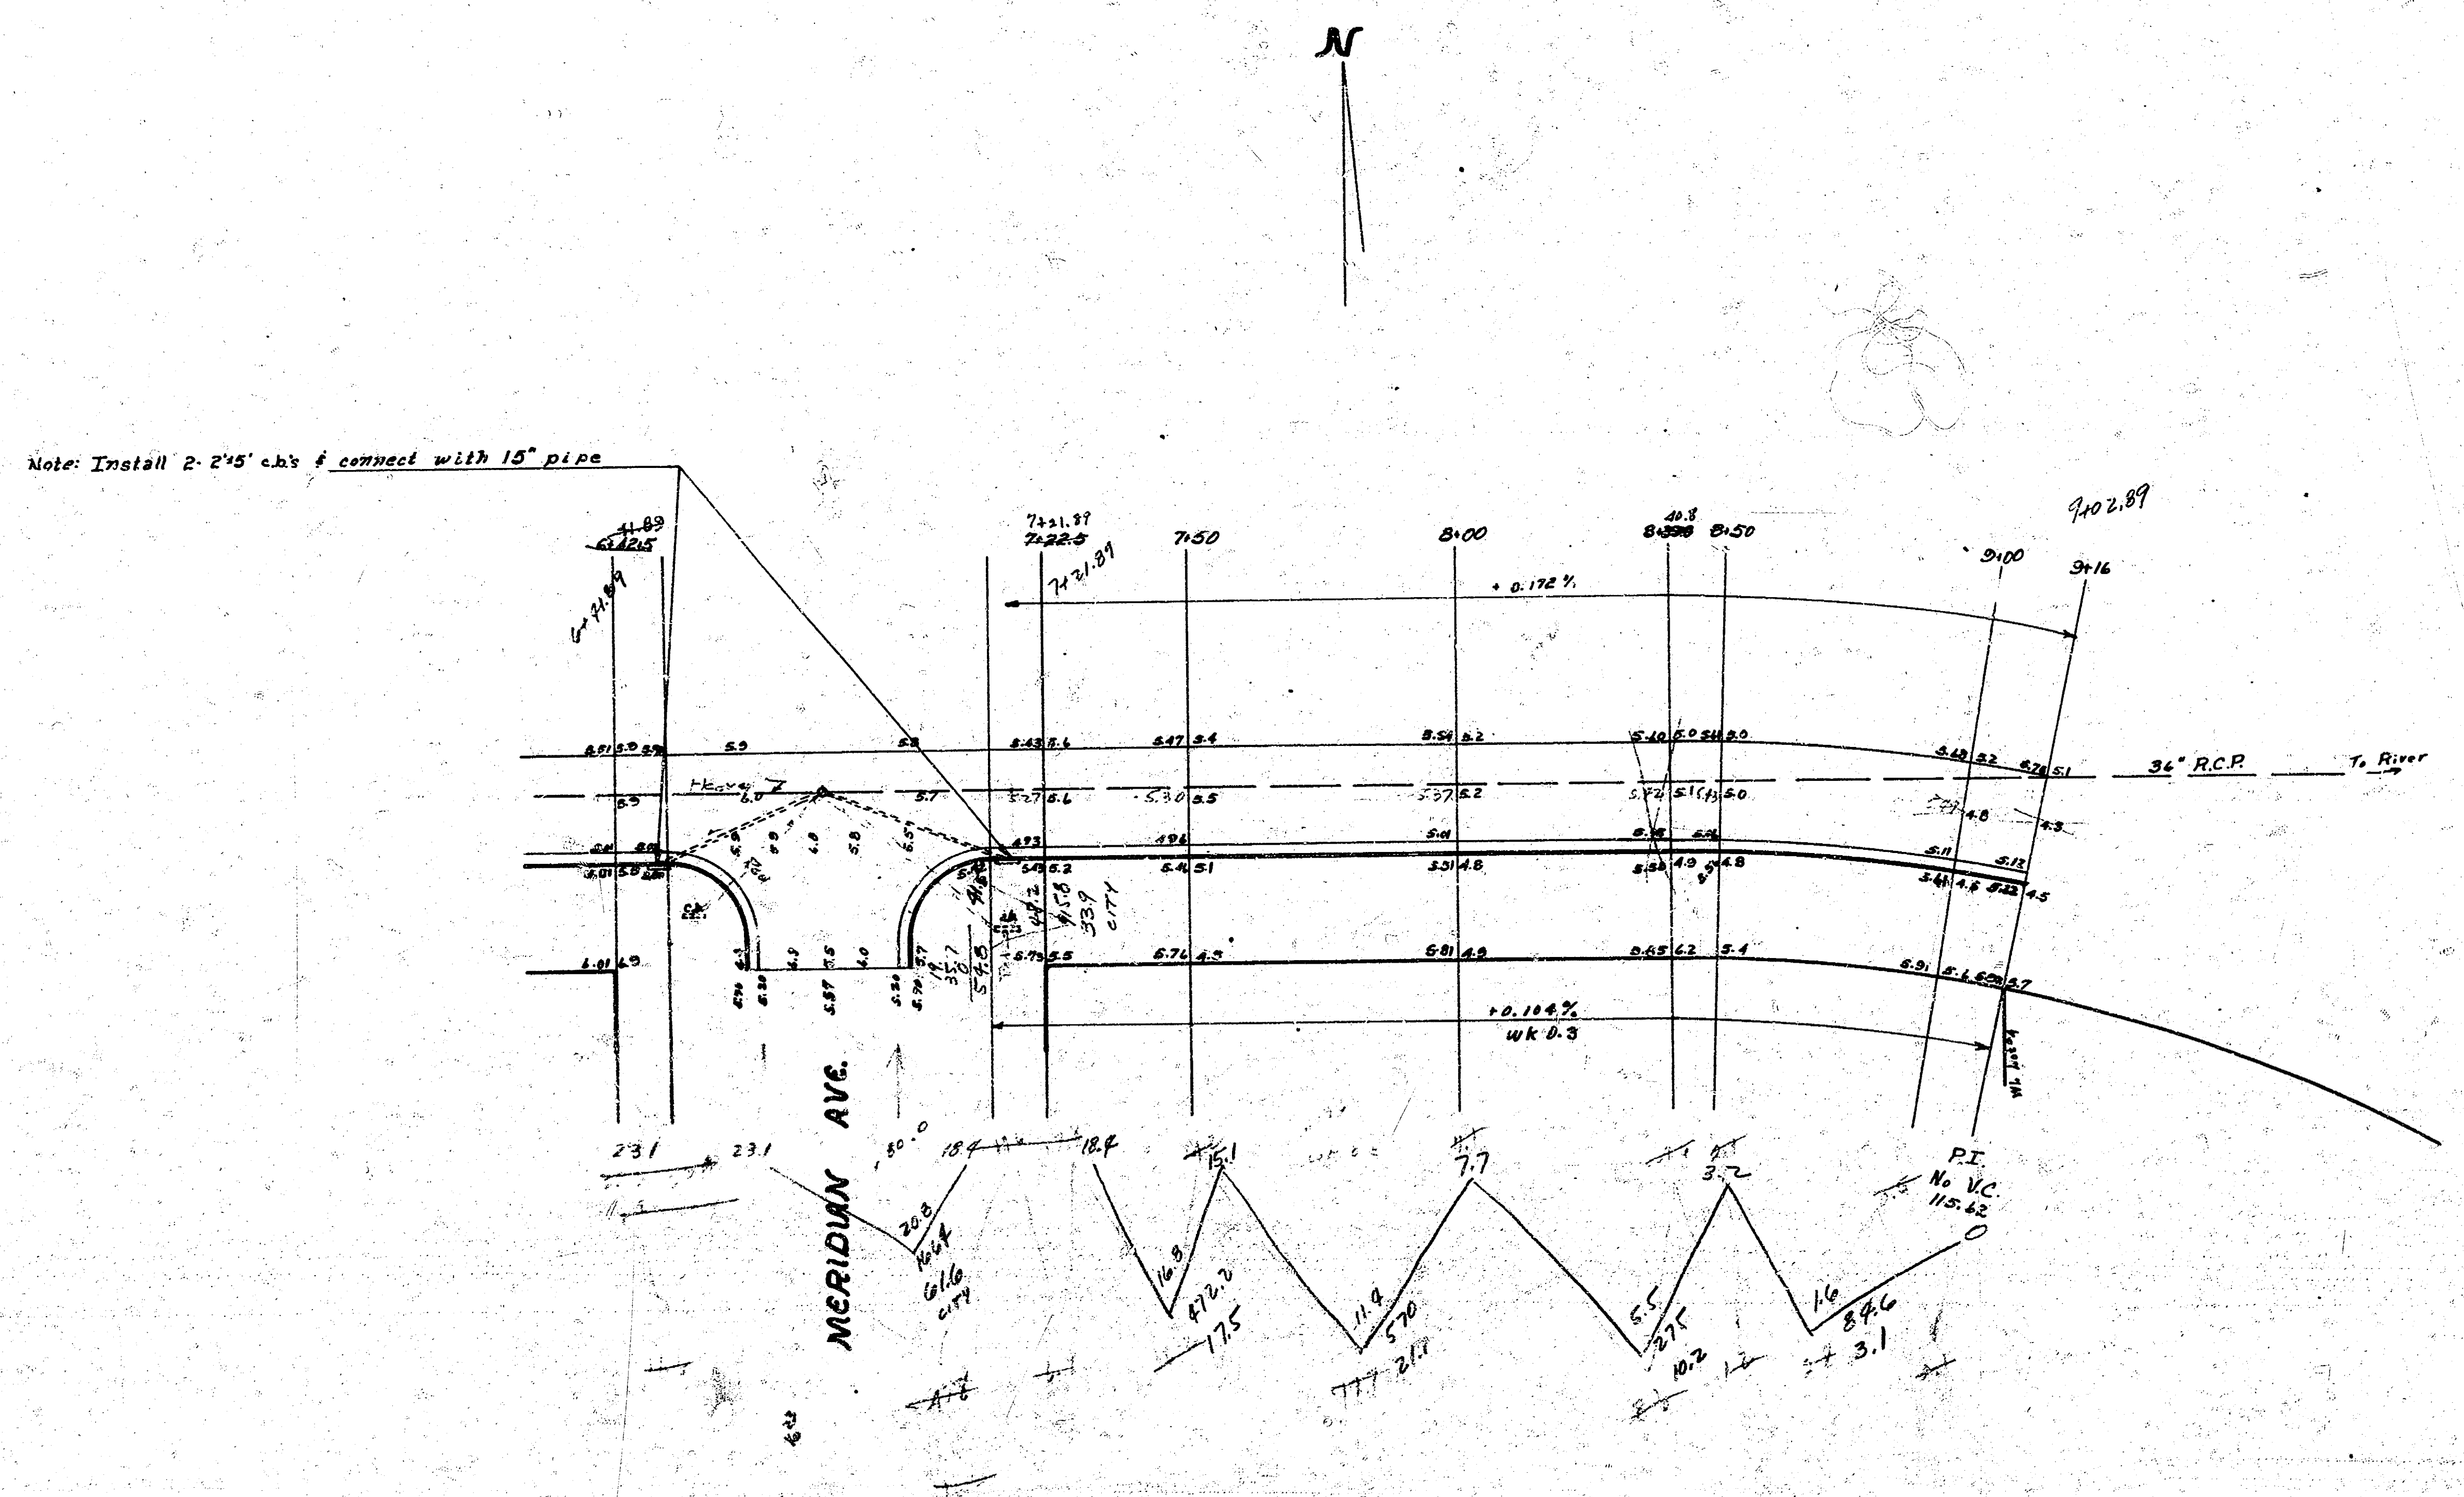

N
Note: Install 2- 2'x5' c.b.'s & connect with 15" pipe
6+71.89
7+21.89
7+50
8+00
8+50
9+00
9+16
9+02.89
+0.172%
+0.104%
wk 0.3
36" R.C.P.
To River
MERIDIAN AVE.
23.1
18.4
15.1
7.7
3.2
16.8
17.5
11.9
5.5
10.2
1.6
84.6
3.1
P.I.
No V.C.
115.62

2
2

S½ CENTRAL AVE.

L. K. WHITE
LICENSED
55
KANSAS
PROFESSIONAL ENGINEER

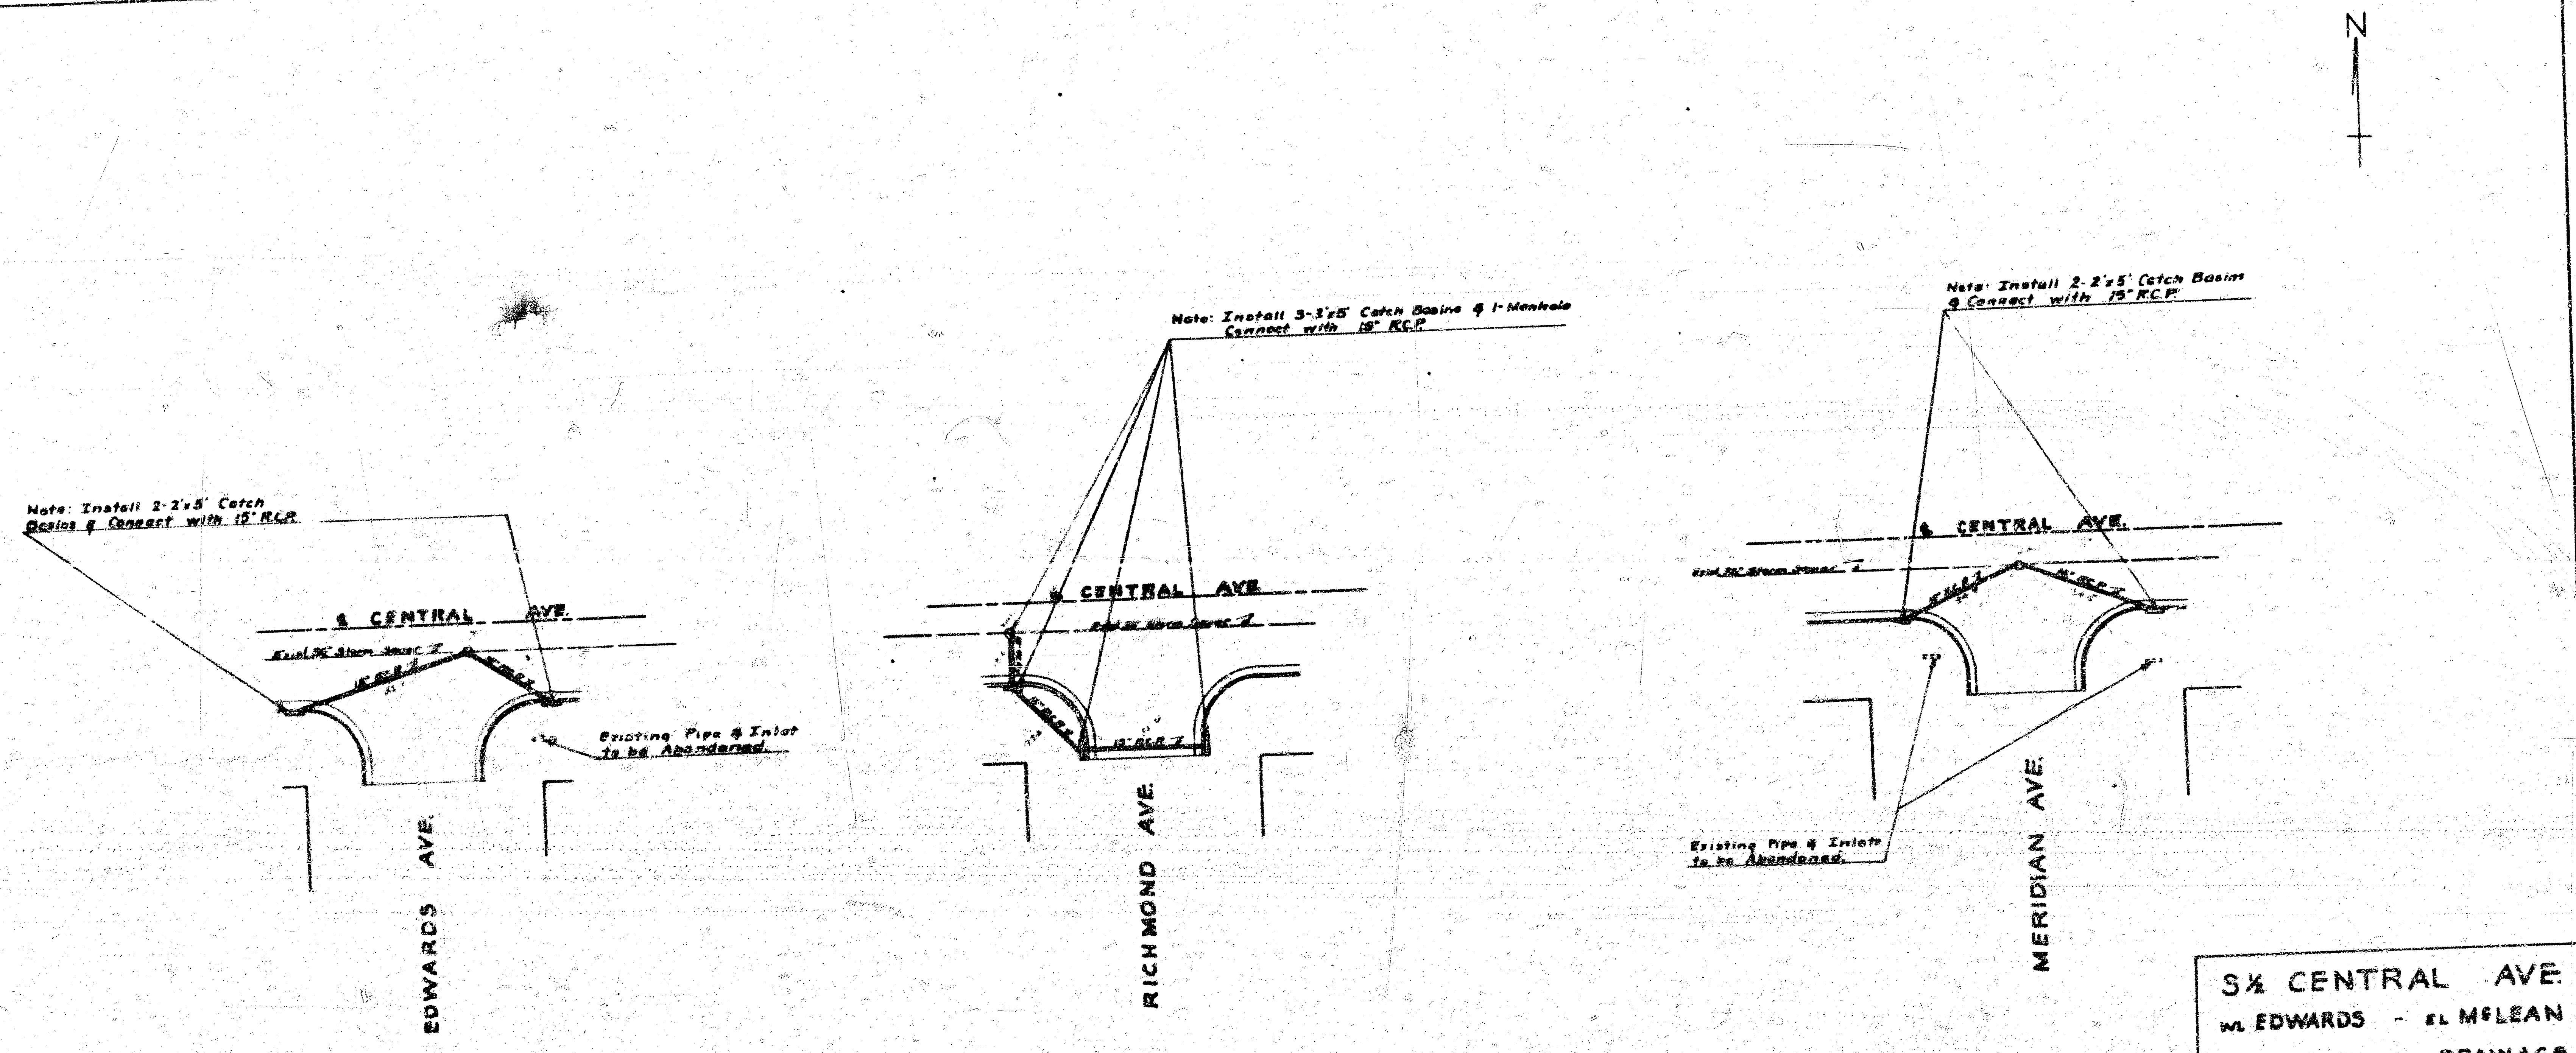
N
Note: Install 2-2'x5' Catch Basins & Connect with 15" R.C.P.
℄ CENTRAL AVE.
Exist. 36" Storm Sewer
Existing Pipe & Inlet to be Abandoned.
EDWARDS AVE.
Note: Install 3-3'x5' Catch Basins & 1-Manhole Connect with 18" R.C.P.
℄ CENTRAL AVE.
18" R.C.P.
RICHMOND AVE.
Note: Install 2-2'x5' Catch Basins & Connect with 15" R.C.P.
℄ CENTRAL AVE.
Exist. 36" Storm Sewer
Existing Pipe & Inlets to be Abandoned.
MERIDIAN AVE.

L. K. WHITE 55

S½ CENTRAL AVE.
W.L. EDWARDS - E.L. McLEAN
INCIDENTAL DRAINAGE
City of Wichita, Kansas
L.K. White City Engineer
October 1950 Proj. No. C10-169