
WHEATLAND ADDITION

SEDGWICK COUNTY, KANSAS

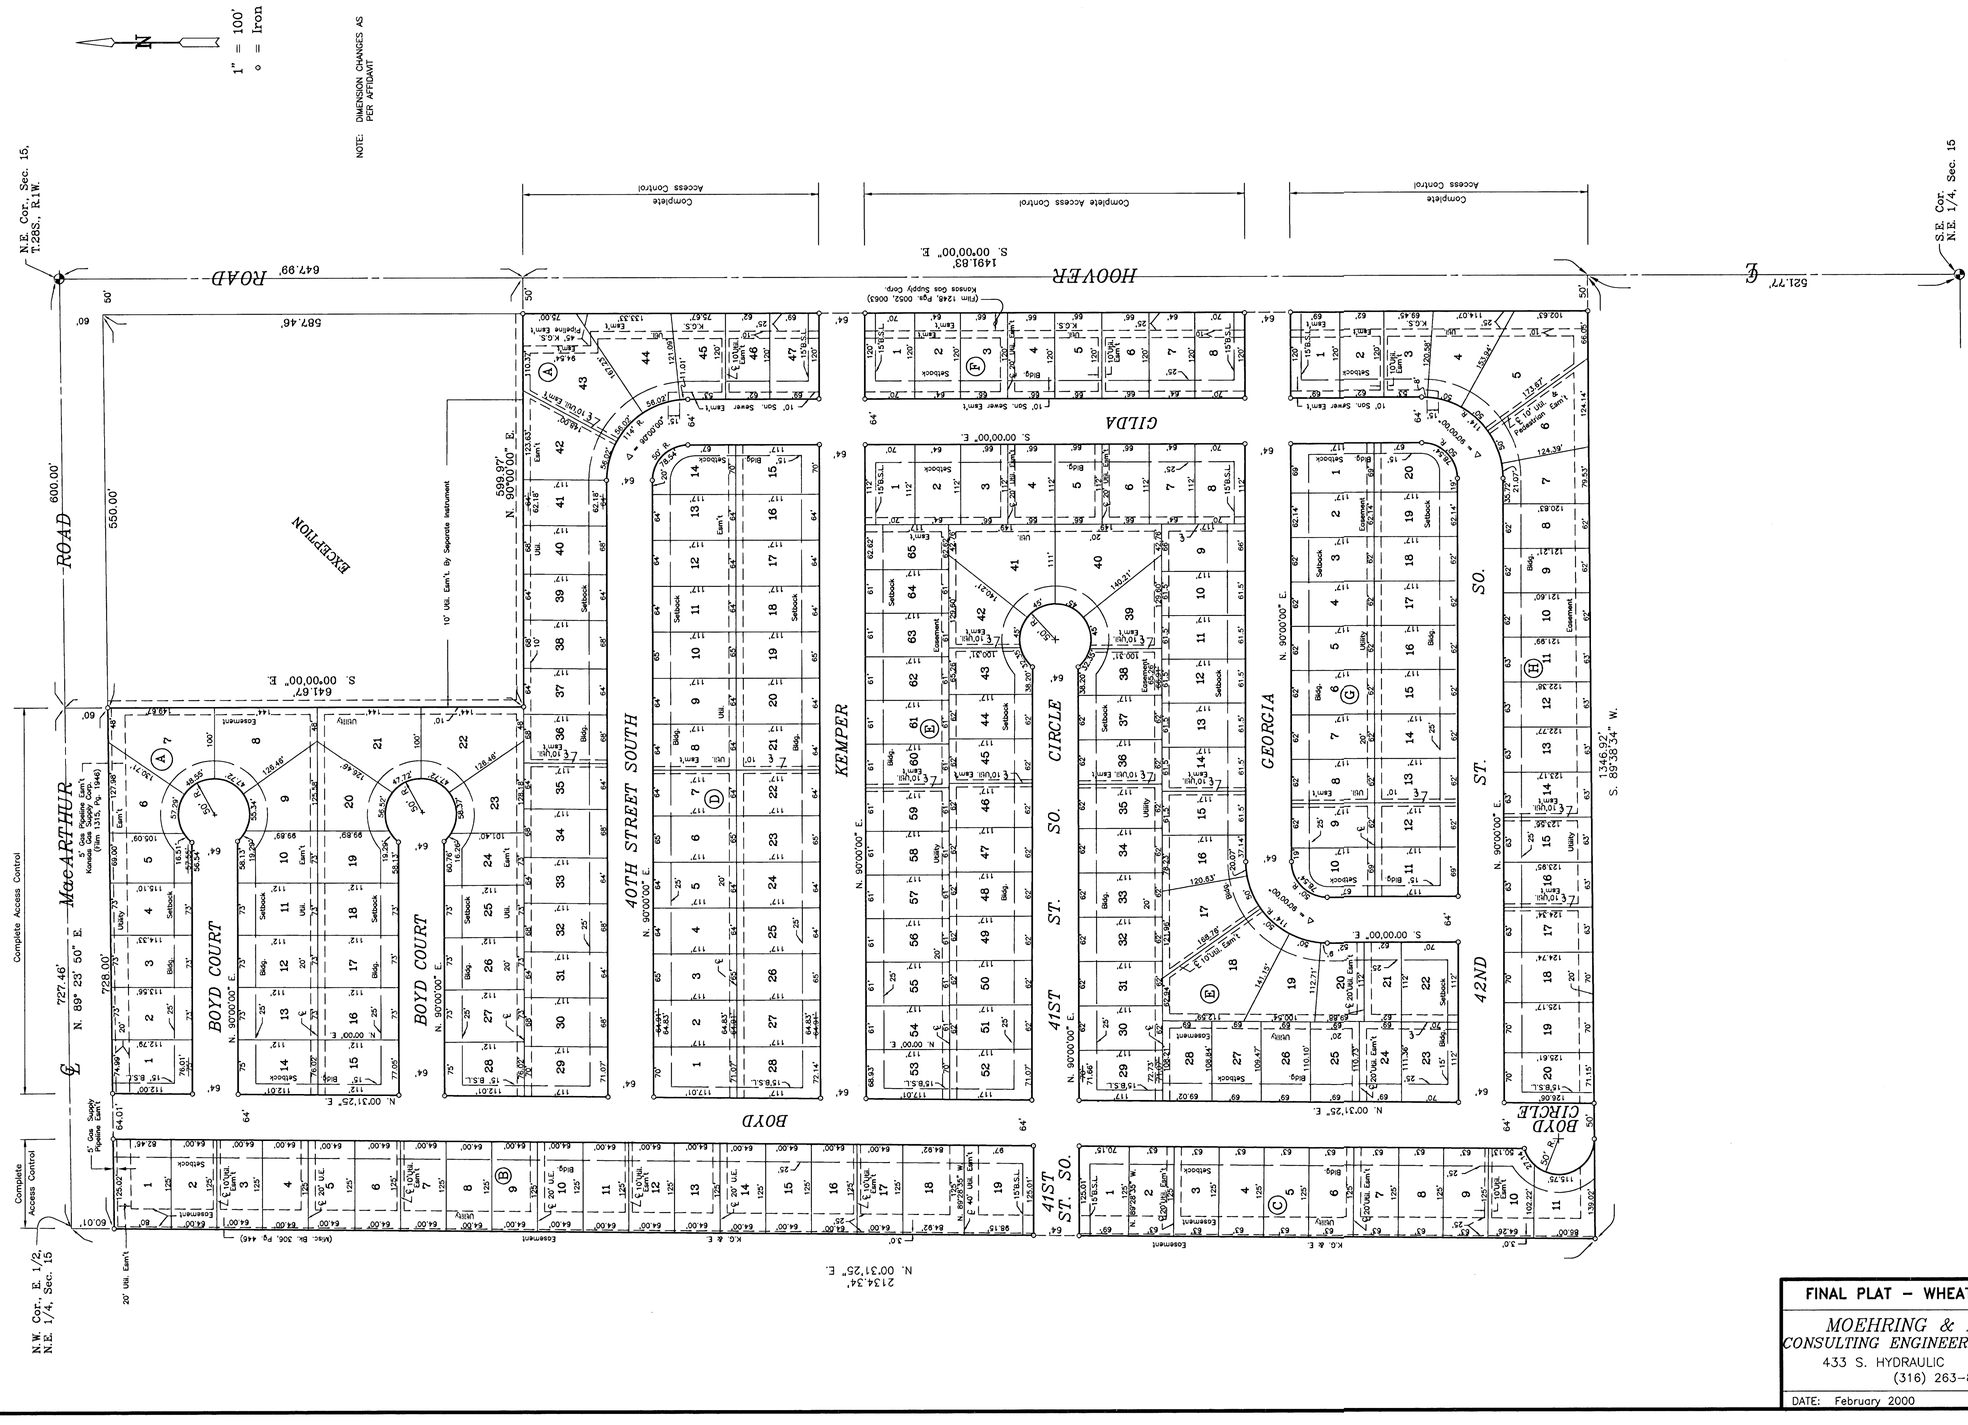

FINAL PLAT – WHEATLAND ADDITION

MOEHRING & ASSOCIATES
CONSULTING ENGINEERS – SURVEYORS
433 S. HYDRAULIC WICHITA, KS.
(316) 263-8291

DATE: February 2000 SHEET 3 of 10