
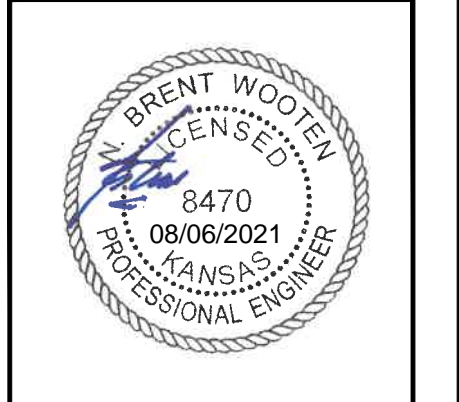


Point Table			
Point #	Northing	Eastng	Raw Description
1	1699885.47	1698647.65	iron
2	1699886.87	1698733.64	iron
3	1699994.00	1698731.89	iron
4	1700025.34	1698645.37	iron
5	1700052.69	1698724.95	iron
6	1700083.63	1698716.25	iron
7	1700089.43	1698642.67	iron
8	1700121.68	1698700.17	iron
9	1700134.14	1698632.02	iron
10	1700294.15	1698621.57	iron
11	1700282.53	1698678.39	iron
12	1700433.78	1698593.34	iron
13	1700371.20	1698578.24	iron
14	1700436.50	1698396.32	iron
15	1700496.74	1698417.94	iron
16	1700581.65	1698349.66	iron
17	1700573.99	1698286.12	iron
18	1700673.64	1698274.10	iron
19	1700681.30	1698337.64	iron
20	1700729.54	1698247.99	iron
21	1700809.34	1698173.07	iron
22	1700853.15	1698219.73	iron
23	1700897.50	1698195.19	iron
24	1700881.25	1698133.29	iron
25	1700935.25	1698179.81	iron
26	1701001.82	1698105.45	iron
27	1701014.61	1698040.79	iron
28	1700950.62	1698041.83	iron
29	1700946.65	1697797.02	iron
30	1701010.64	1697795.98	iron
31	1700877.43	1697666.12	iron
32	1700878.03	1697730.12	iron
33	1700611.57	1697668.58	iron
34	1700612.16	1697732.58	iron
35	1700533.45	1697741.44	iron
36	1700519.80	1697678.91	iron
37	1700334.26	1697677.67	iron
38	1700319.77	1697740.01	iron
39	1700280.18	1697735.65	iron
40	1700279.59	1697671.66	iron
41	1700157.39	1697672.79	iron
42	1700157.98	1697736.78	iron
43	1700110.43	1697785.57	iron
44	1700046.44	1697786.61	iron
45	1700047.64	1697860.22	iron
46	1700111.63	1697859.18	iron
47	1700092.63	1698009.03	iron
48	1700030.92	1697992.05	iron
49	1700026.14	1698093.97	iron
50	1700089.17	1698082.84	iron
51	1700091.45	1698358.67	iron
52	1700028.25	1698348.58	iron
53	1700017.96	1698493.28	iron
54	1700081.95	1698492.23	iron
55	1700082.80	1698543.83	iron
56	1700018.81	1698544.87	iron
57	1700024.72	1698639.67	iron
58	1700088.35	1698632.74	iron
59	1700091.51	1698760.00	iron
60	1700060.02	1698765.67	iron
61	1700123.76	1698849.58	iron
62	1700137.67	1698820.76	iron
63	1700203.23	1698923.33	iron
64	1700171.23	1698923.85	iron
65	1700171.45	1698937.00	iron
66	1700203.44	1698936.47	iron
67	1700232.46	1698998.62	iron
68	1700211.52	1699022.82	iron

Point Table			
Point #	Northing	Eastng	Raw Description
69	1700219.82	1699030.00	iron
70	1700240.76	1699005.80	iron
71	1700257.38	1699009.96	iron
72	1700265.83	1699008.98	iron
73	1700394.57	1699007.79	iron
74	1700395.31	1699087.79	iron
75	1700266.57	1699088.98	iron
76	1700226.32	1699045.85	iron
77	1700821.47	1698249.47	iron
78	1700773.35	1698294.65	iron
79	1700800.73	1698323.81	iron
80	1700848.85	1698278.63	iron
81	1700866.97	1698303.78	iron
82	1700824.69	1698343.48	iron
83	1700865.25	1698386.68	iron
84	1700907.53	1698346.98	iron
85	1700946.47	1698382.23	iron
86	1700911.16	1698428.24	iron
87	1701004.91	1698585.54	iron
88	1700950.55	1698565.31	iron
89	1700950.62	1698795.09	iron
90	1701004.97	1698774.81	iron
91	1700996.73	1698947.11	iron
92	1700947.91	1698914.43	iron
93	1700931.41	1698912.82	iron
94	1700931.94	1698970.82	iron
95	1700809.95	1698971.95	iron
96	1700809.41	1698913.95	iron
97	1700732.14	1698992.67	iron
98	1700790.14	1698992.13	iron
99	1700790.45	1699026.13	iron
100	1700732.45	1699026.67	iron
101	1700810.63	1699045.94	iron
102	1700811.17	1699103.94	iron
103	1700933.17	1699102.81	iron
104	1700932.63	1699044.81	iron
105	1700952.44	1699024.63	iron
106	1701010.44	1699024.09	iron
107	1701010.13	1698990.09	iron
108	1700952.13	1698990.63	iron
109	1700982.78	1697716.99	iron
110	1700960.20	1697694.31	iron
111	1700974.06	1697660.50	iron
112	1701006.06	1697660.20	iron
113	1701005.08	1697554.90	iron
114	1700973.09	1697555.20	iron
115	1700972.90	1697535.20	iron
116	1701004.90	1697534.90	iron
117	1700686.15	1697731.90	iron
118	1700654.15	1697732.19	iron
119	1700654.37	1697755.63	iron
120	1700686.37	1697755.33	iron
121	1700673.68	1697830.30	iron
122	1700643.56	1697819.49	iron
123	1700556.97	1698155.42	iron
124	1700565.22	1698178.21	iron
125	1700507.45	1698198.67	iron
126	1700082.03	1697702.88	iron
127	1700051.31	1697752.08	iron
128	1700019.31	1697743.07	iron
129	1700018.77	1697685.07	iron
130	1700005.62	1697685.19	iron
131	1700006.16	1697743.19	iron
132	1699867.49	1697545.42	iron
133	1701136.40	1697533.68	iron
134	1701164.26	1699250.68	iron
135	1699895.49	1699262.42	iron

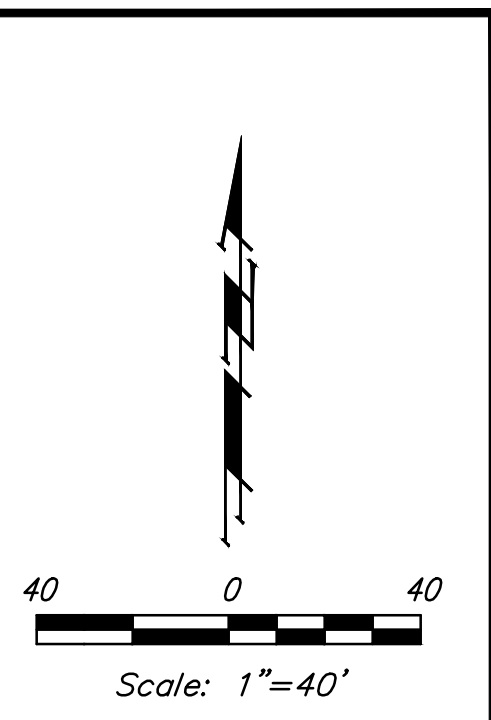

BAUGHMAN COMPANY

315 Ellis St.
Wichita, KS 67211
316-262-7271
BaughmanCo.com

NRD ADDITION

COORDINATE SHEET

STORM WATER DRAIN IMPROVEMENTS

PROJECT NUMBER:
21-03-E867

DESIGN: NBW DRAWN: TMS
DATE: August 5, 2021

SHEET OF
44 46

File: E:\Projects\NRD Addition_19-04-P448\Engineering\Phase 1\SRWD 21-03-E867\SRWD.dwg