HORIZONTAL CONTROL:

HC#1197 5/8" REBAR WITH RED MKEC CAP. WEST SIDE OF RIVER 35' NORTH OF CENTERLINE 15TH STREET NORTH. 27' EAST OF FERRELL DRIVE. 11.77' EAST OF BACK OF CURB
C.O.W. ELEVATION 122.15
LOCAL COORDINATE
N 3413.63
E 2182.05

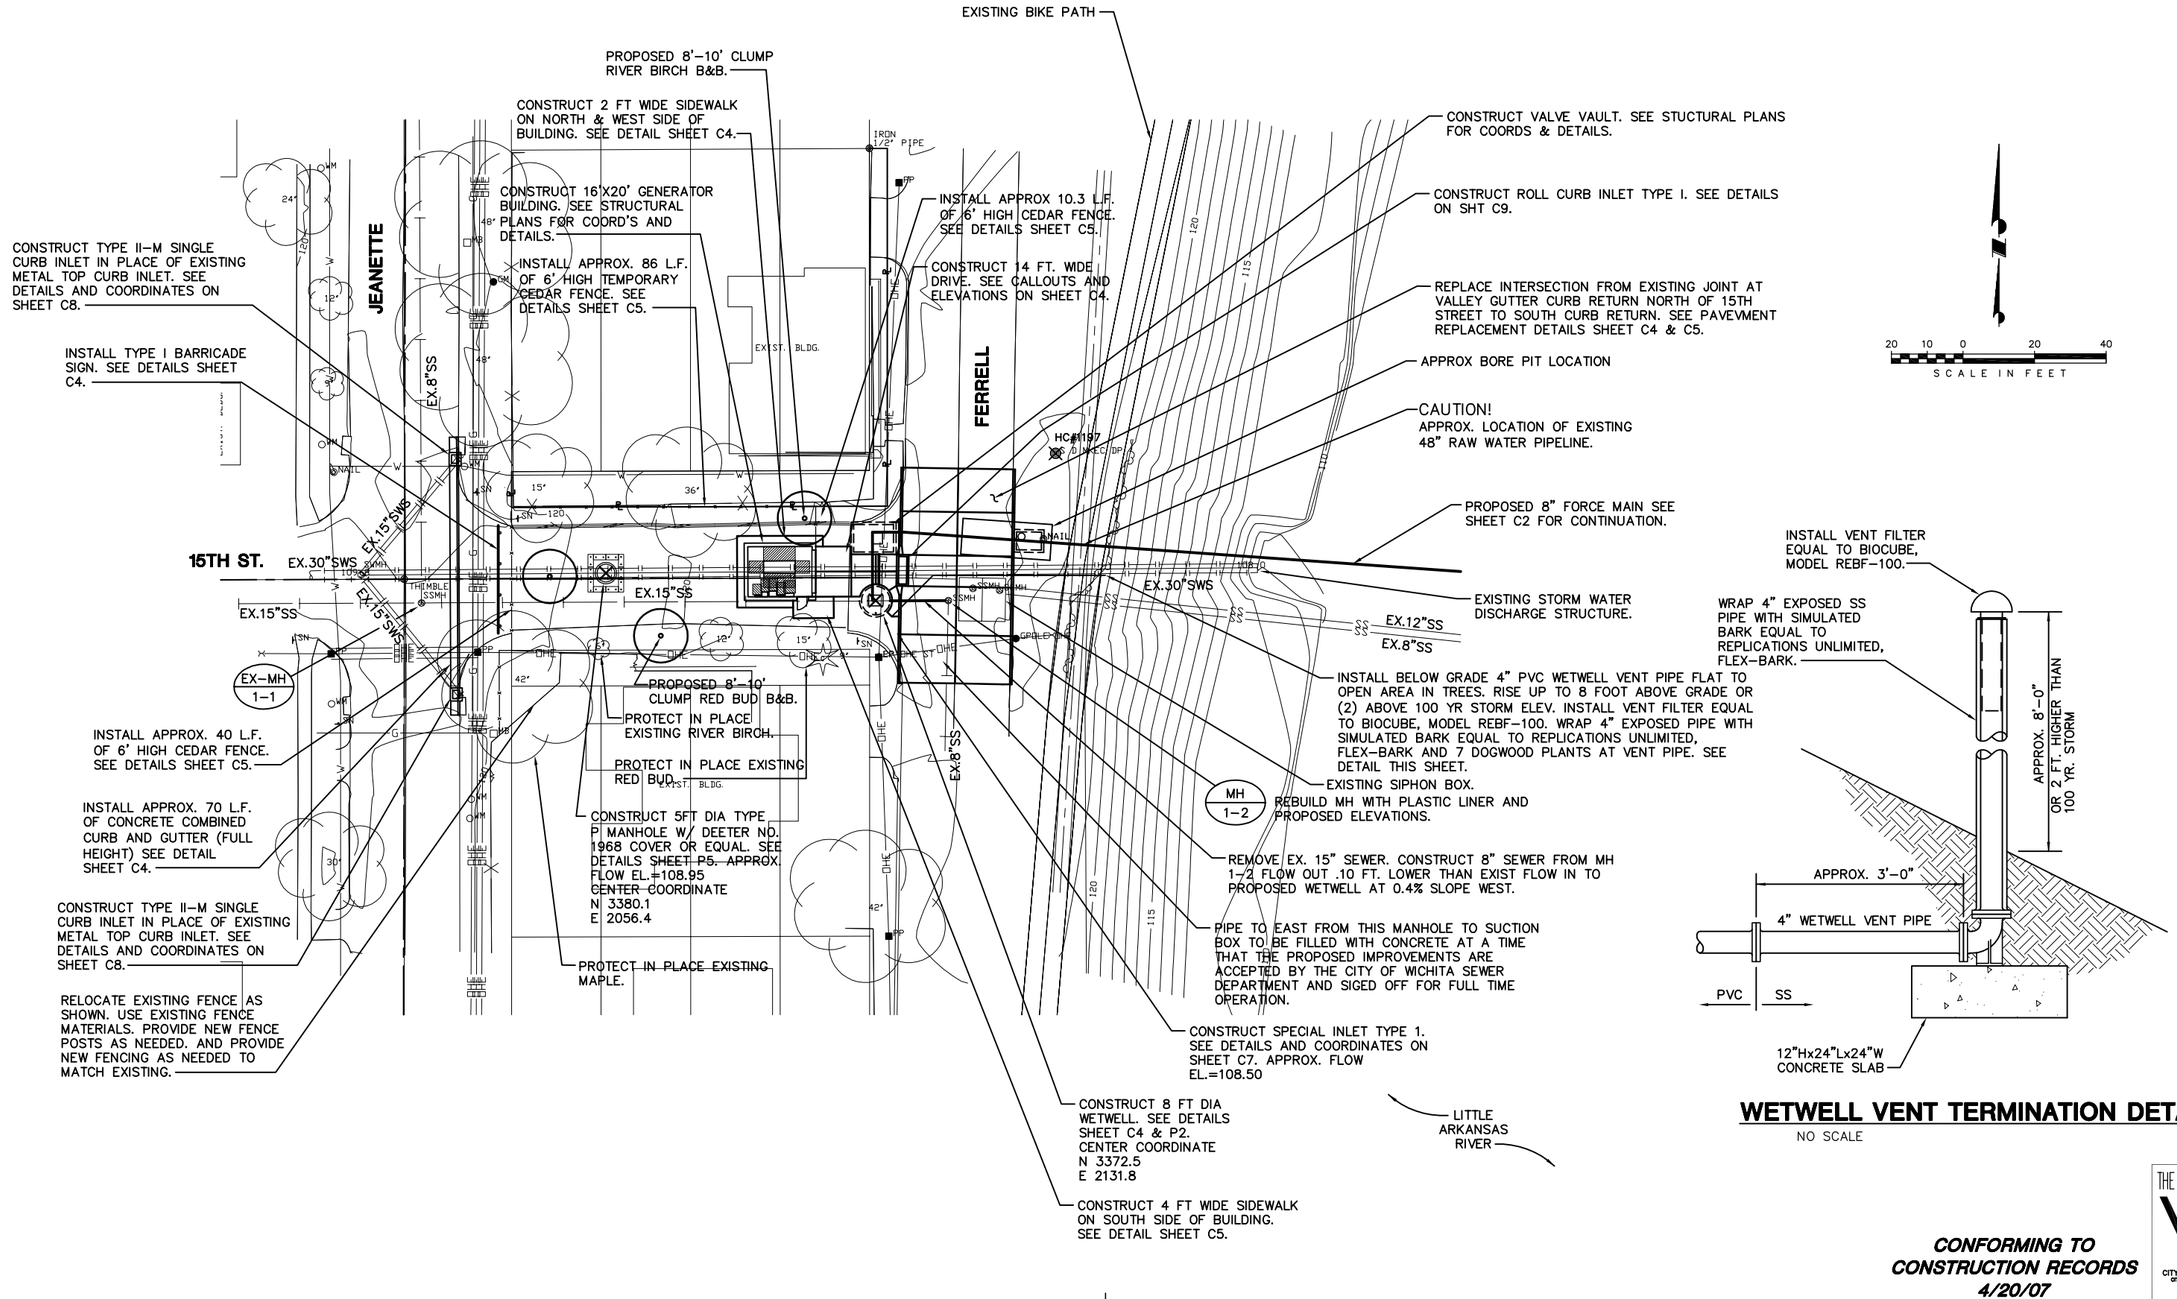

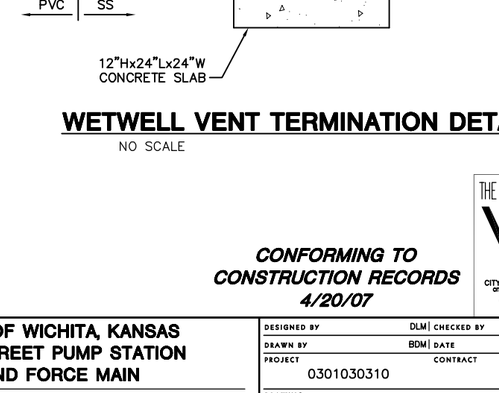

WETWELL VENT TERMINATION DETAIL

NO SCALE

CONFORMING TO CONSTRUCTION RECORDS 4/20/07

THE CITY OF WICHITA
CITY ENGINEER'S OFFICE
CITY HALL - SEVENTH FLOOR
455 NORTH MAIN STREET
WICHITA, KANSAS 67202
(316) 268-4518
(316) 268-4519 FAX

NO.	BY	DATE	DESCRIPTION
0	DLM	10/17/05	ISSUE FOR CONSTRUCTION
	MJV	4/26/07	CONFORMING TO CONSTRUCTION RECORDS CHANGED NORTH FENCE TO CEDAR. DELETED PORTION OF SOUTH & EAST FENCE. CHANGED LOCATION OF WET WELL VENT.

MKEC ENGINEERING CONSULTANTS

CITY OF WICHITA

CITY OF WICHITA, KANSAS
15th STREET PUMP STATION AND FORCE MAIN

SITE PLAN I

DESIGNED BY	DLM	CHECKED BY	DLM
DRAWN BY	BDM	DATE	JUNE, 2005
PROJECT		CONTRACT	
0301030310		–	
DRAWING			REVISION
C1		-	0

FILE I:\ENVR\03310\DWG\Civil\03310_C1-SITE_PLAN-1.dwg 01/09/2006 03:36:53 PM CST