

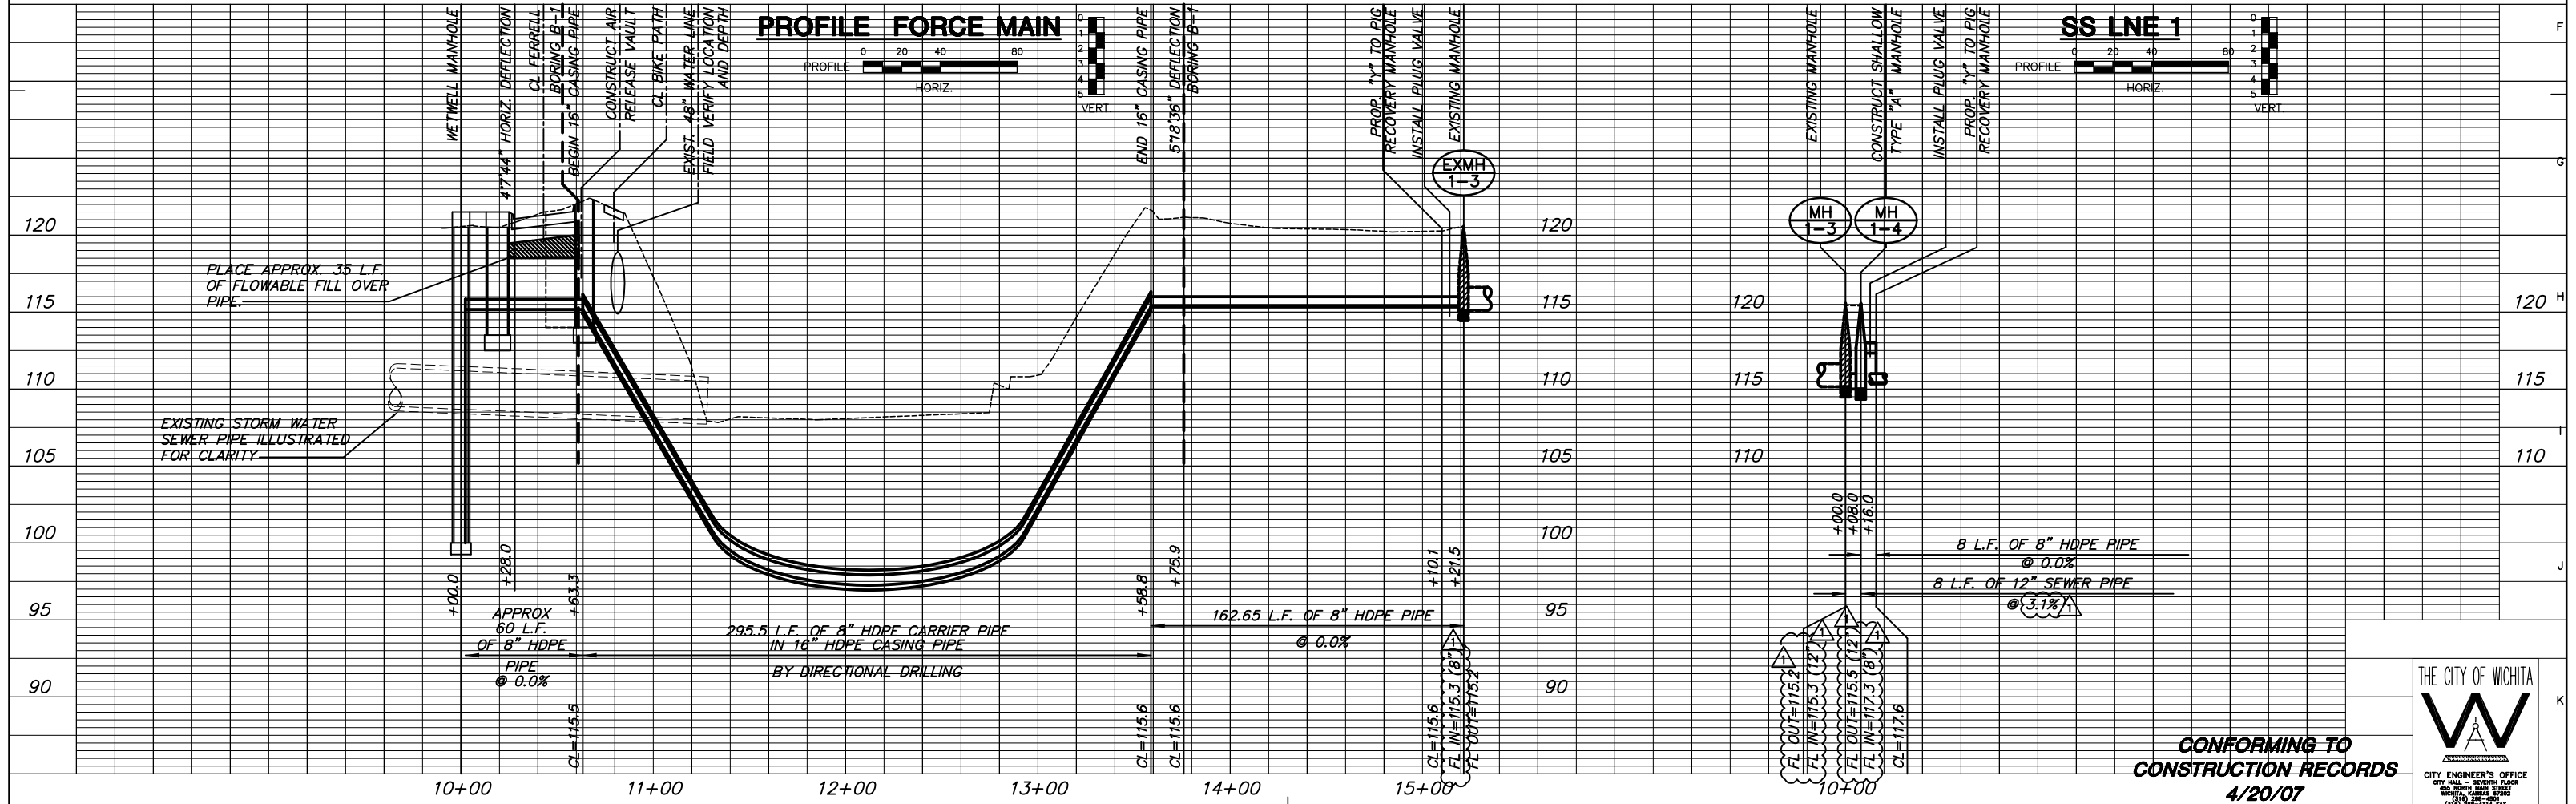


**CAUTION:**  
CONTRACTOR IS RESPONSIBLE TO  
FIELD LOCATE EXISTING 48\"/>

**PLAN FORCE MAIN & SS LINE 1**

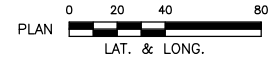

**CONFORMING TO  
CONSTRUCTION RECORDS  
4/20/07**

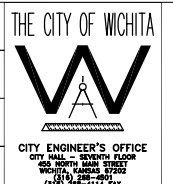

NO.	BY	DATE	DESCRIPTION
0	DLM	10/17/05	ISSUE FOR CONSTRUCTION
1	DLM	2/27/06	REVISION #1 - CHANGED ELEVATIONS ON MH 1-3 & MH 1-4. FLIPPED CALLOUTS FOR CLARITY. ISSUED



**CITY OF WICHITA, KANSAS  
15th STREET PUMP STATION  
AND FORCE MAIN  
FORCE MAIN PLAN & PROFILE**

DESIGNED BY	DLM	CHECKED BY	DLM
DRAWN BY	BDM	DATE	JUNE, 2005
PROJECT	0301030310	CONTRACT	-
DRAWING	P4	REVISION	1