SHEET NO.	TOTAL SHEETS
1	10

CITY OF WICHITA, KANSAS

NEIL D. CABLE, P.E., CITY ENGINEER

ZOO BOULEVARD BIKE PATH

PHASE 2, LANDSCAPING

FROM

CENTRAL TO WESTDALE DRIVE

CITY OF WICHITA PROJECT NO. 472-83442

OCA NO. 706832

FEDERAL AID PROJECT NO. 87 TE-0159-01

INDEX OF SHEETS

1. TITLE SHEET
2. TYPICAL SECTIONS
3.-10. PLAN SHEETS - BIKE PATH
~~11. TRAFFIC SIGNAL PLAN - WEST STREET~~
~~12. TRAFFIC SIGNAL PLAN - 9TH STREET~~
~~13. TRAFFIC SIGNAL WIRING AND QUANTITIES~~
~~14. TRAFFIC SIGNAL PEDESTAL & CONCRETE BASE DETAIL SHEET~~
~~15. POWER POLE AND SPAN POLE ASSEMBLY DETAILS~~
~~16. SERVICE/JUNCTION BOX, CONTROLLER PAD CONSTRUCTION/INSTALLATION DETAILS~~
~~17. SUMMARY OF QUANTITIES~~
~~18. ORNAMENTAL STEEL FENCE DETAILS, TYPICAL MISC. PAVEMENT MARKING AND SIGNING DETAILS~~
~~19. TRAFFIC CONTROL PLAN~~
~~20. TRAFFIC CONTROL DETAILS~~
~~21.-24. SOIL EROSION BMP DETAILS~~

PROJECT BENCHMARKS:

BM #200 – CHISELED "d" N. END MEDIAN 150'± N. OF CENTRAL 43' WSW OF AT&T MARKER #706.

ELEV.= 121.75

BM #201 – CHISELED "d" NE. CURB ZOO BLVD. NEAR AT&T MARKER #705 ACROSS FROM N. DRIVE ZOO BLVD. APTS.

ELEV.= 120.45

BM #202 – CHISELED "d" NE. CURB ZOO BLVD 250'± SE. OF ℄ JOANN EXTENDED NEAR AT&T MARKER #704.

ELEV.= 119.61

BM #203 – CHISELED "d" NE. CURB ZOO BLVD. 275'± SE. OF ℄ WESTRIDGE EXT. NEAR AT&T MARKER #703.

ELEV.= 120.57

BM #204 – CHISELED "d" NE. CURB ZOO BLVD. 175'± SE. OF ℄ KESSLER EXT. 50'± N. OF CITY OF WICHITA VAULT.


ELEV.= 122.12

BM #205 – RAILROAD SPIKE N. FACE POWER POLE WITH METER NE OF POWER AND LIGHT POLE AT NE CORNER OF ZOO BLVD. AND WEST STREET.

ELEV.= 126.22

BM #206 – RAILROAD SPIKE IN E. FACE OF LIGHT POLE AT S.E. CORNER OF 13TH ST. AND ZOO BLVD.

ELEV.= 134.54

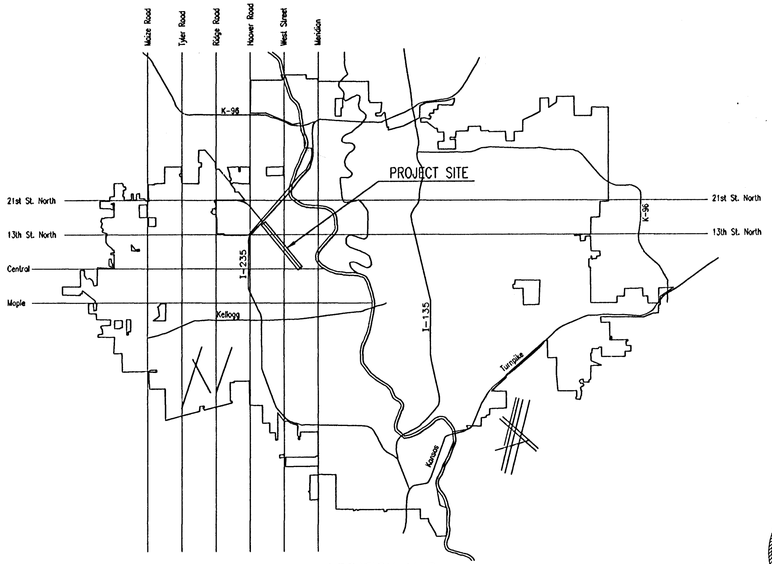

LOCATION MAP





SEPTEMBER 2001

PLANS PREPARED BY

PROFESSIONAL ENGINEERING CONSULTANTS, P.A.
ENGINEERS
WICHITA, KANSAS

DSNR: SAD OPER: SAD SCALE: 1=150.00
C:\1996\96450\002\TITLE 10-11-2002 04:06:56 pm