

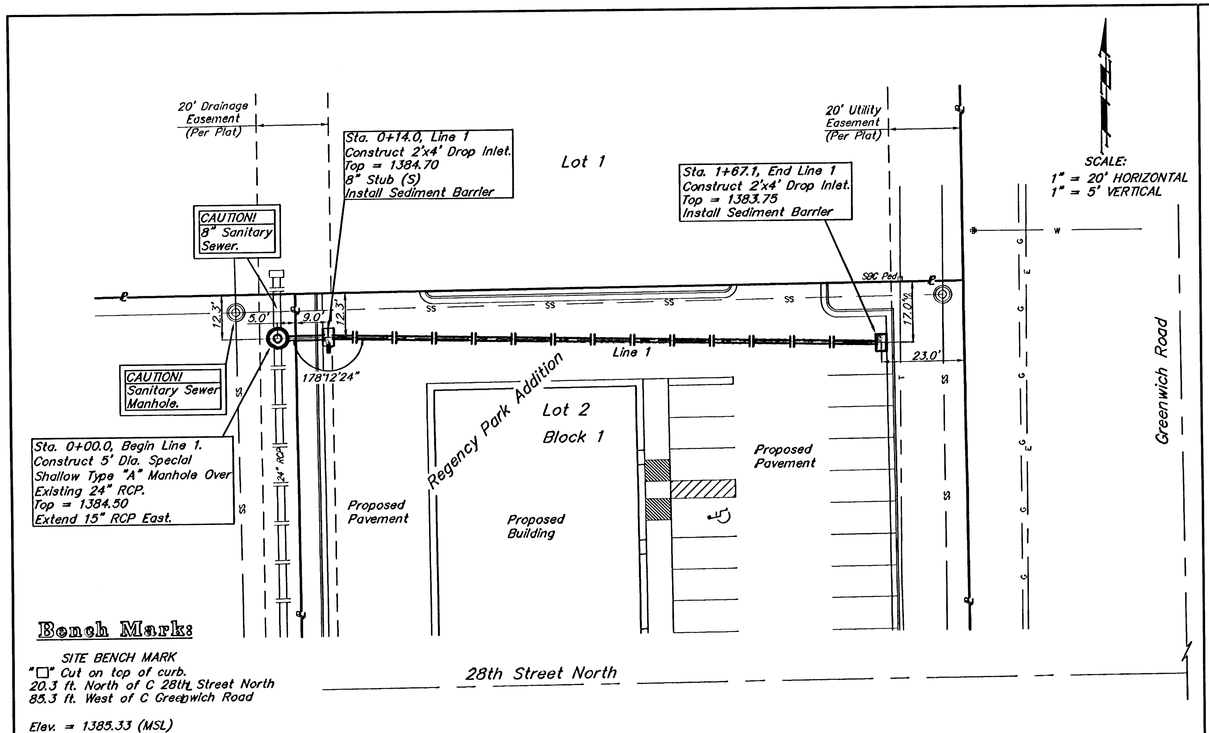


Bench Mark:

SITE BENCH MARK
"□" Cut on top of curb.
20.3 ft. North of C 28th Street North
85.3 ft. West of C Greenwich Road

Elev. = 1385.33 (MSL)

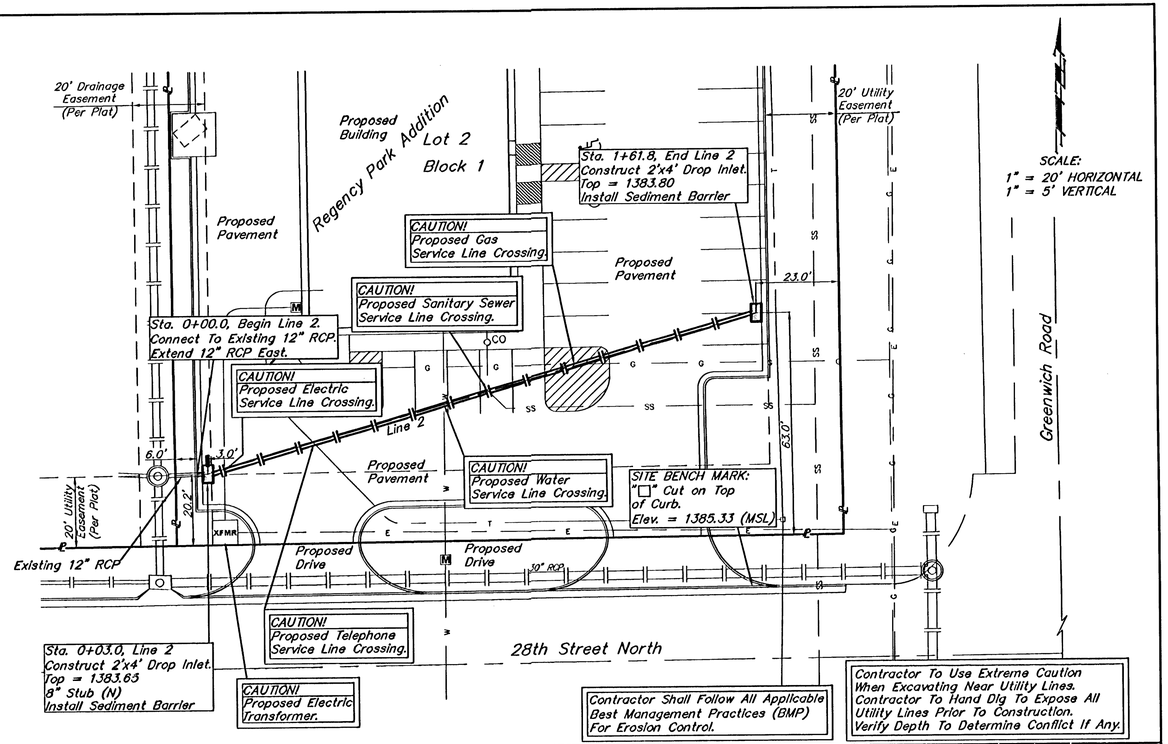

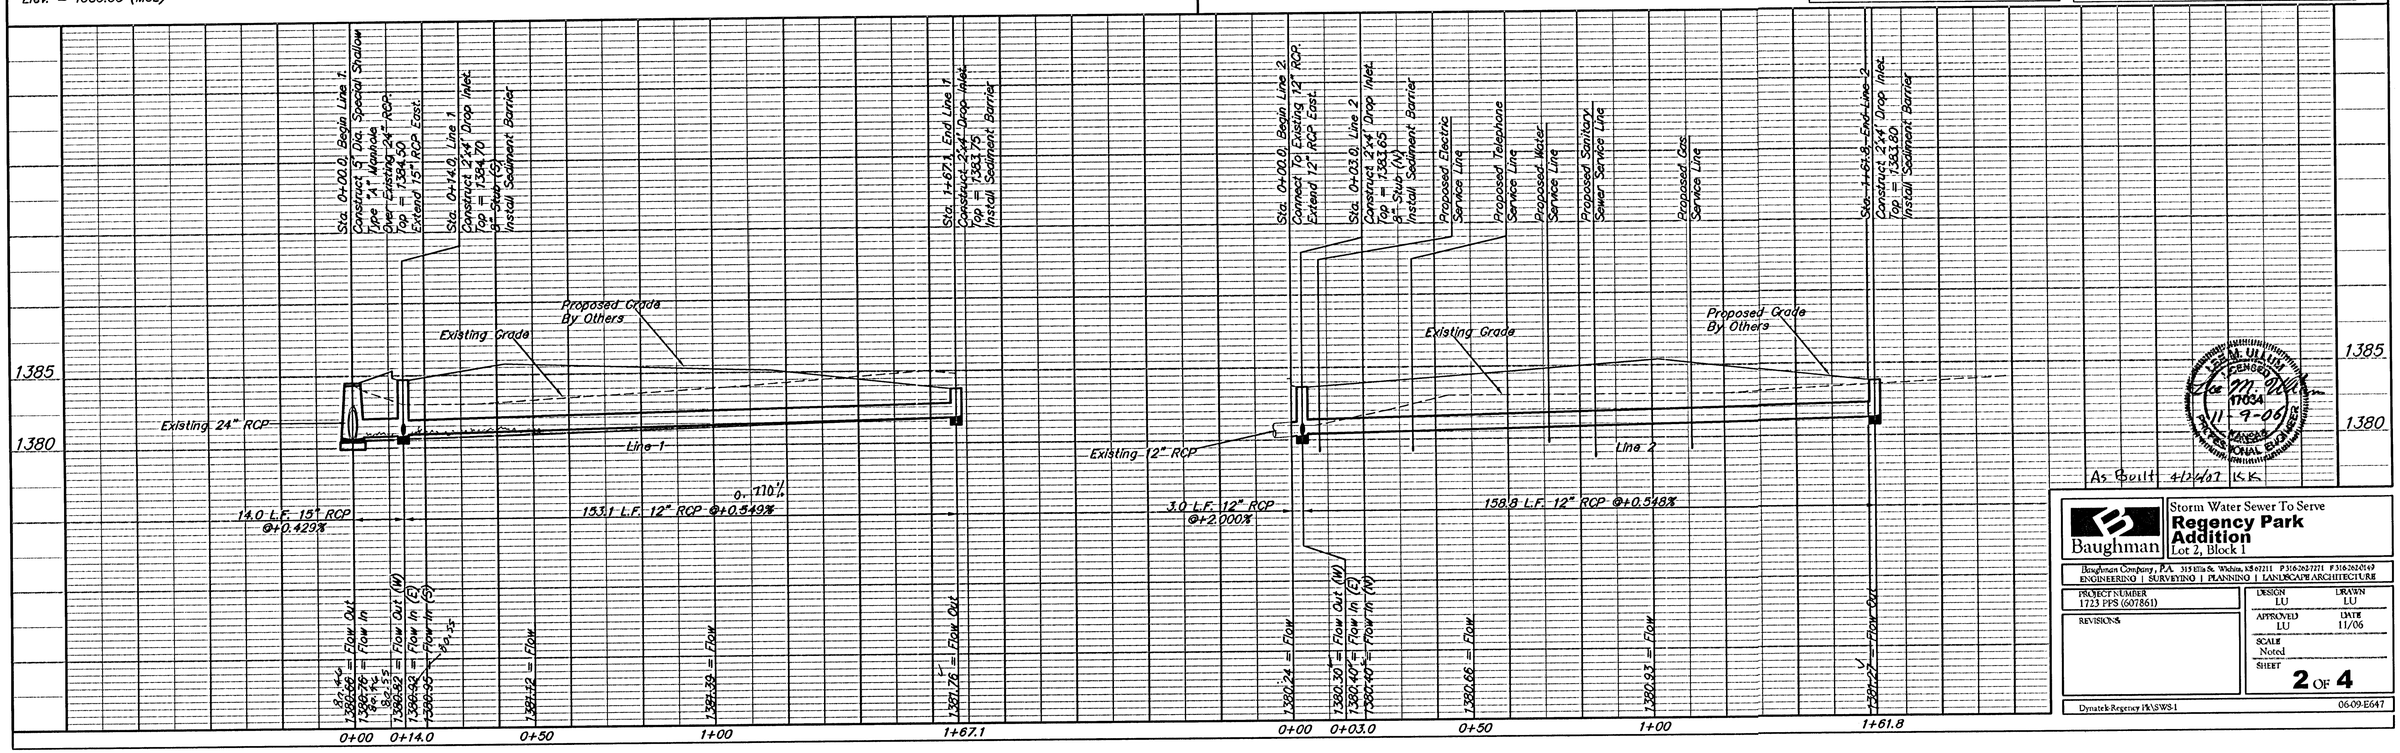

As Built 4-12-07 LSK

Storm Water Sewer To Serve
Regency Park Addition
Lot 2, Block 1

Baughman

Baughman Company, P.A. 315 Ellis St. Wichita, KS 67211 P 316.263.7271 F 316.263.6949
ENGINEERING | SURVEYING | PLANNING | LANDSCAPE ARCHITECTURE

PROJECT NUMBER
1723 PPS (607861)

DESIGN LU | DRAWN LU
APPROVED LU | DATE 11/06
SCALE Noted
SHEET 2 OF 4

REVISIONS

Dynatek-Regency P:\SWS-1

0609-E647