
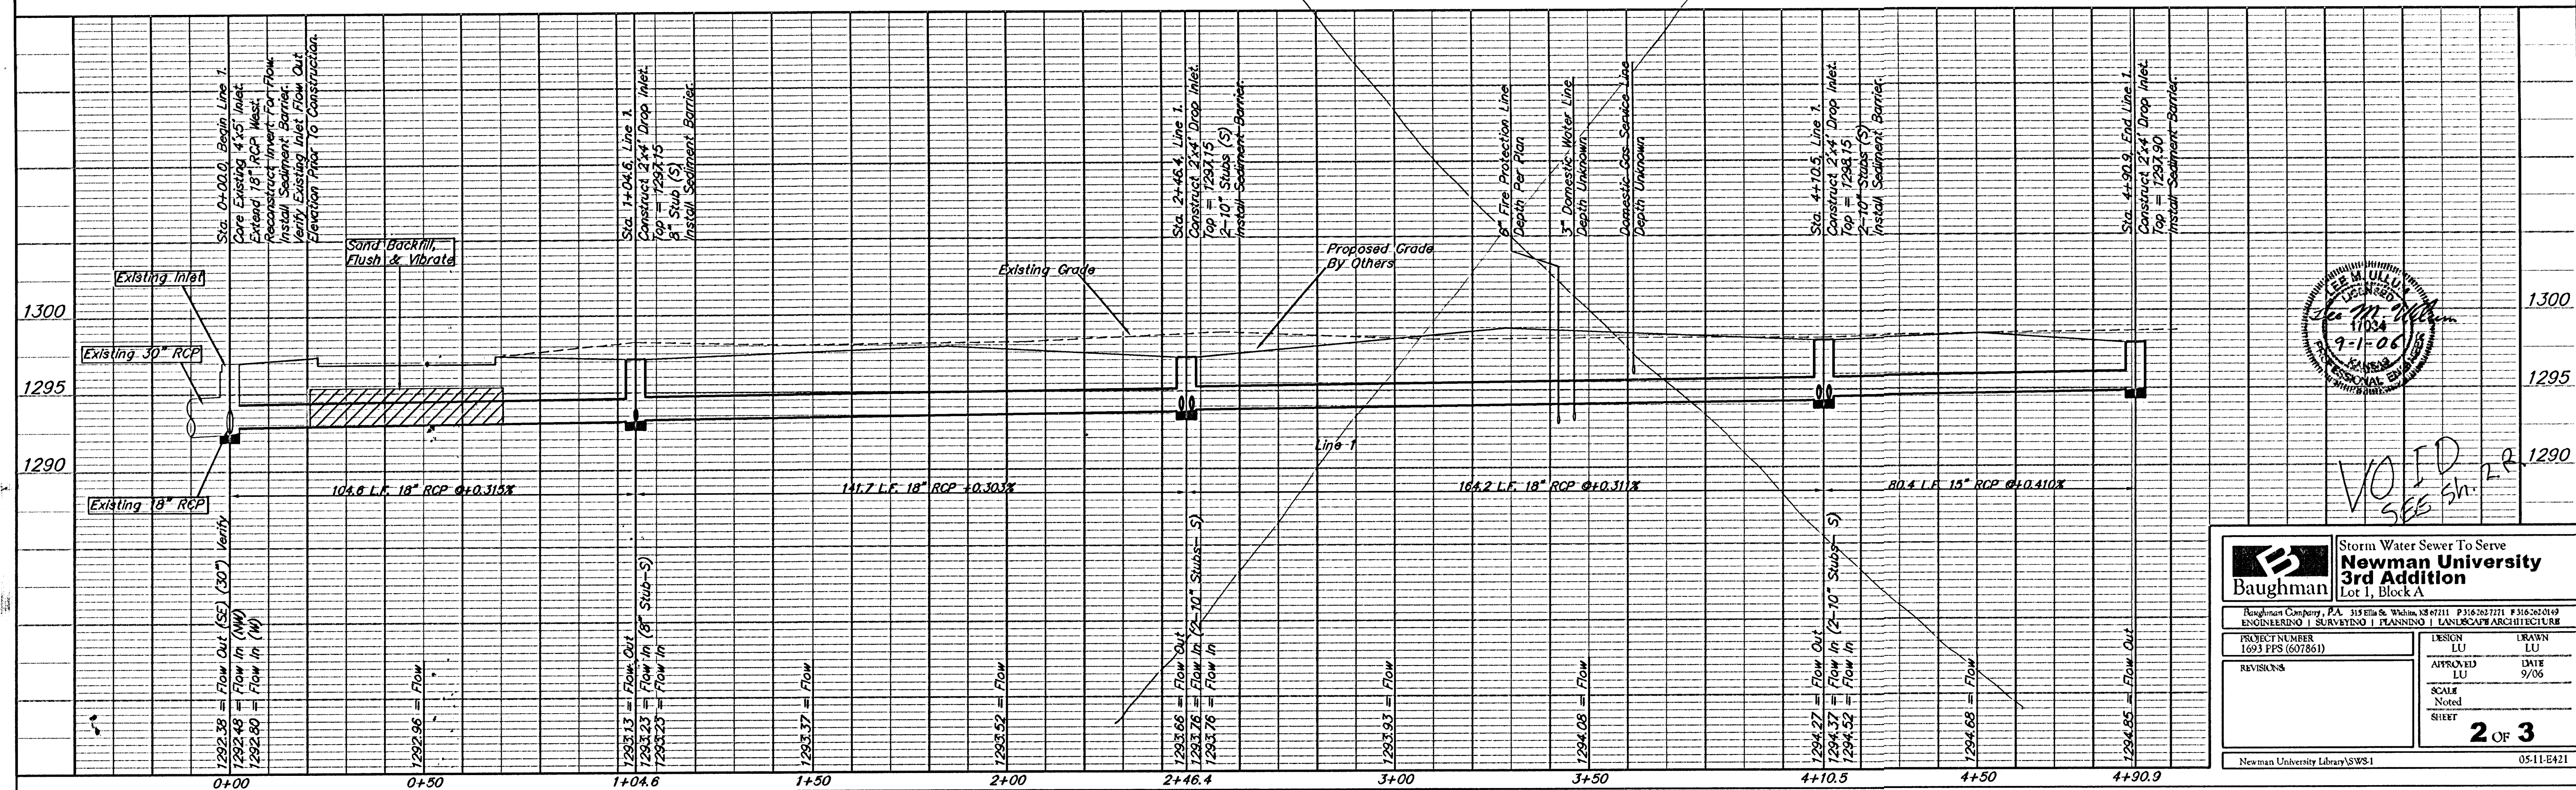


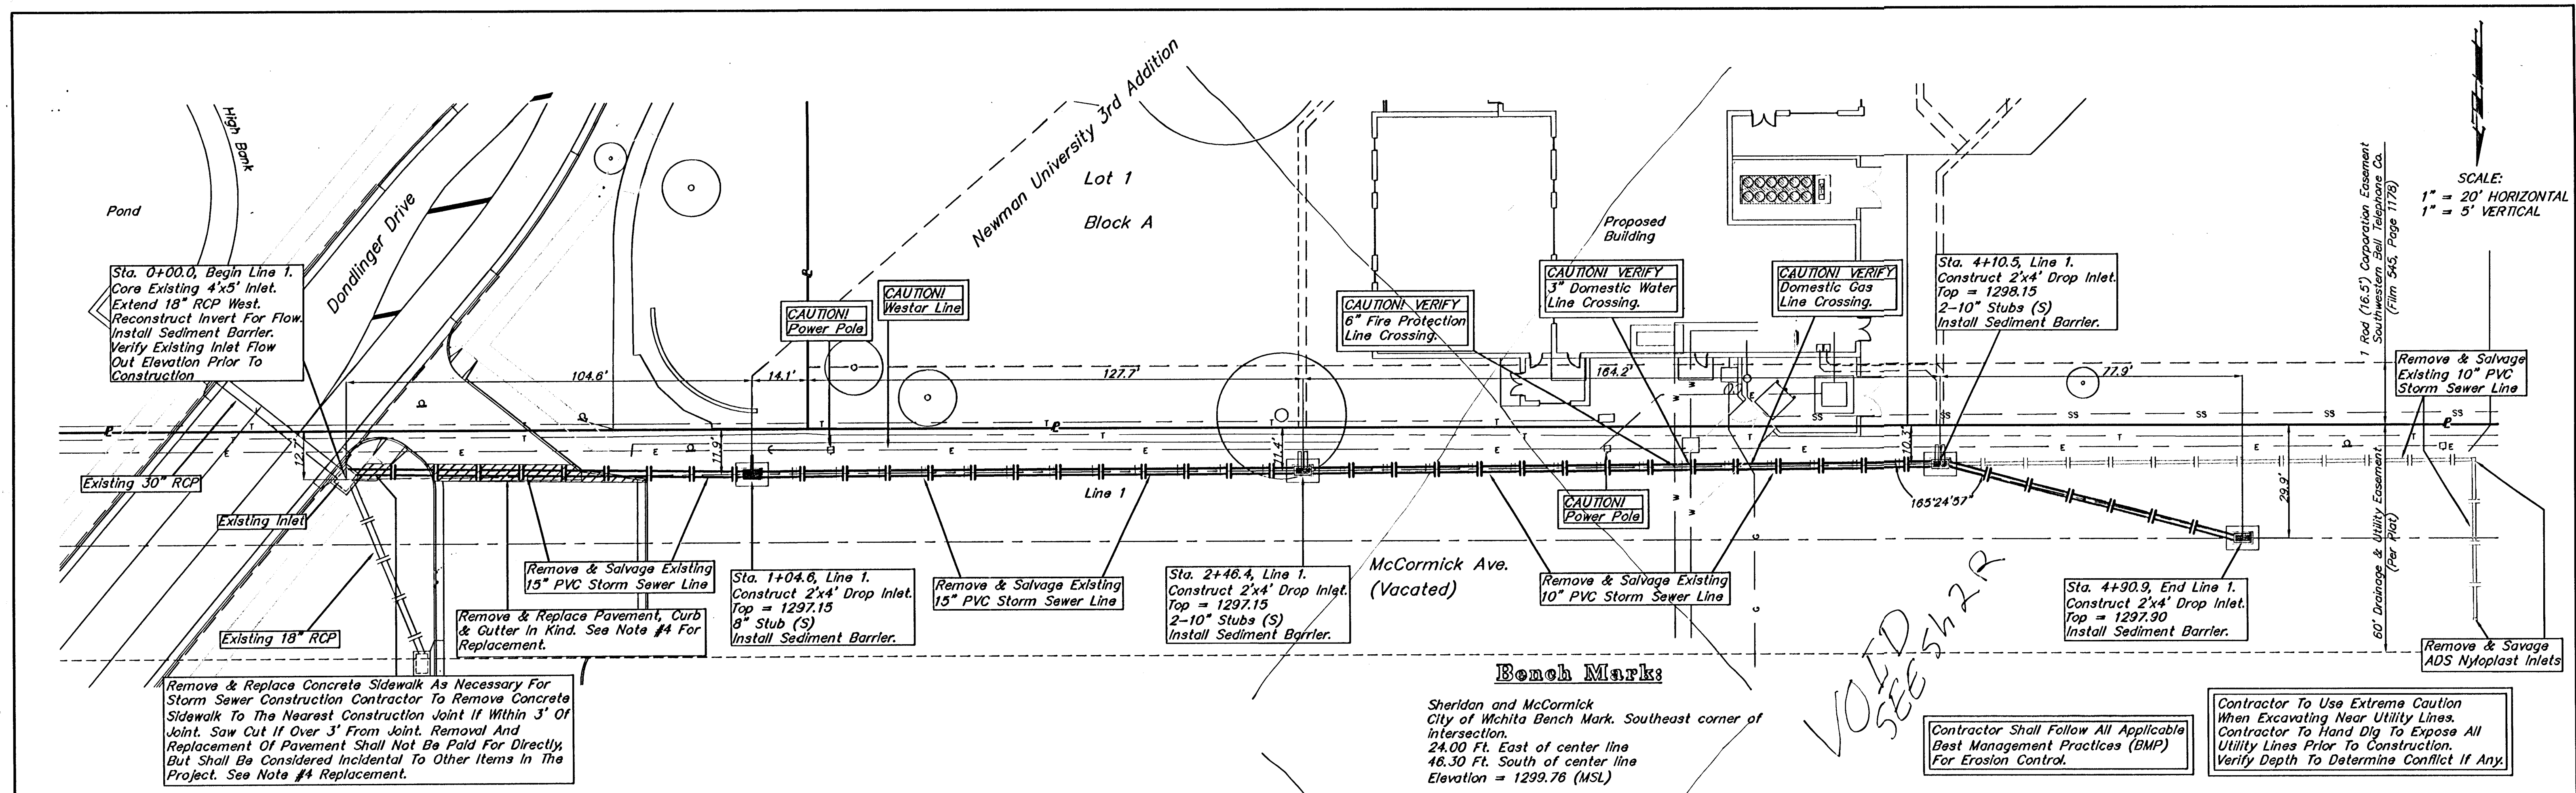

Baughman Storm Water Sewer To Serve Newman University 3rd Addition Lot 1, Block A

Baughman Company, P.A. 315 Ellis & White, KS 67111 P 316-2627721 F 316-2620149
ENGINEERING | SURVEYING | PLANNING | LANDSCAPE ARCHITECTURE

PROJECT NUMBER 1693 FPS (607861)	DESIGN LU	DRAWN LU
REVISIONS	APPROVED LU	DATE 9/06
	SCALE Noted	
	SHEET	

2 OF 3

Newman University Library/SWS1 05-11-E421