


See Revised Sheet 2R

⊘ DENOTES SUBGRADE BE COMPACTED TO 95% DRY DENSITY

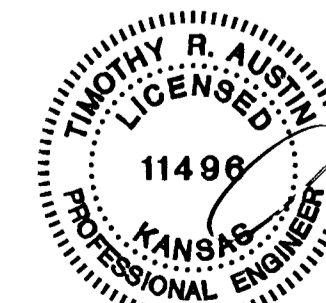


Original Signed

**FINAL**

Designed By: D. Trout  
Drawn By: D. Trout, V. A. Moss  
Pee Job No.: 1894-02  
Date: 10/18/2006

POE & ASSOCIATES, INC.  
CONSULTING ENGINEERS  
590 E. Central, Suite 300, Wichita, KS 67208-9429  
Phone: 316.685-4114 FAX: 316.685-4444

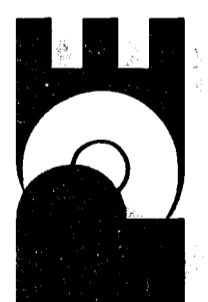

QUICKTRIP #315  
SANITARY & STORM SEWER IMPROVEMENTS  
SANITARY SEWER PLAN & PROFILE  
CITY OF WICHITA, KANSAS  
JAMES ARMOUR, P.E. - CITY ENGINEER  
1711 PPS (607861)

No.	Date	Revision
1		
2		
3		