


LINE NO. 1

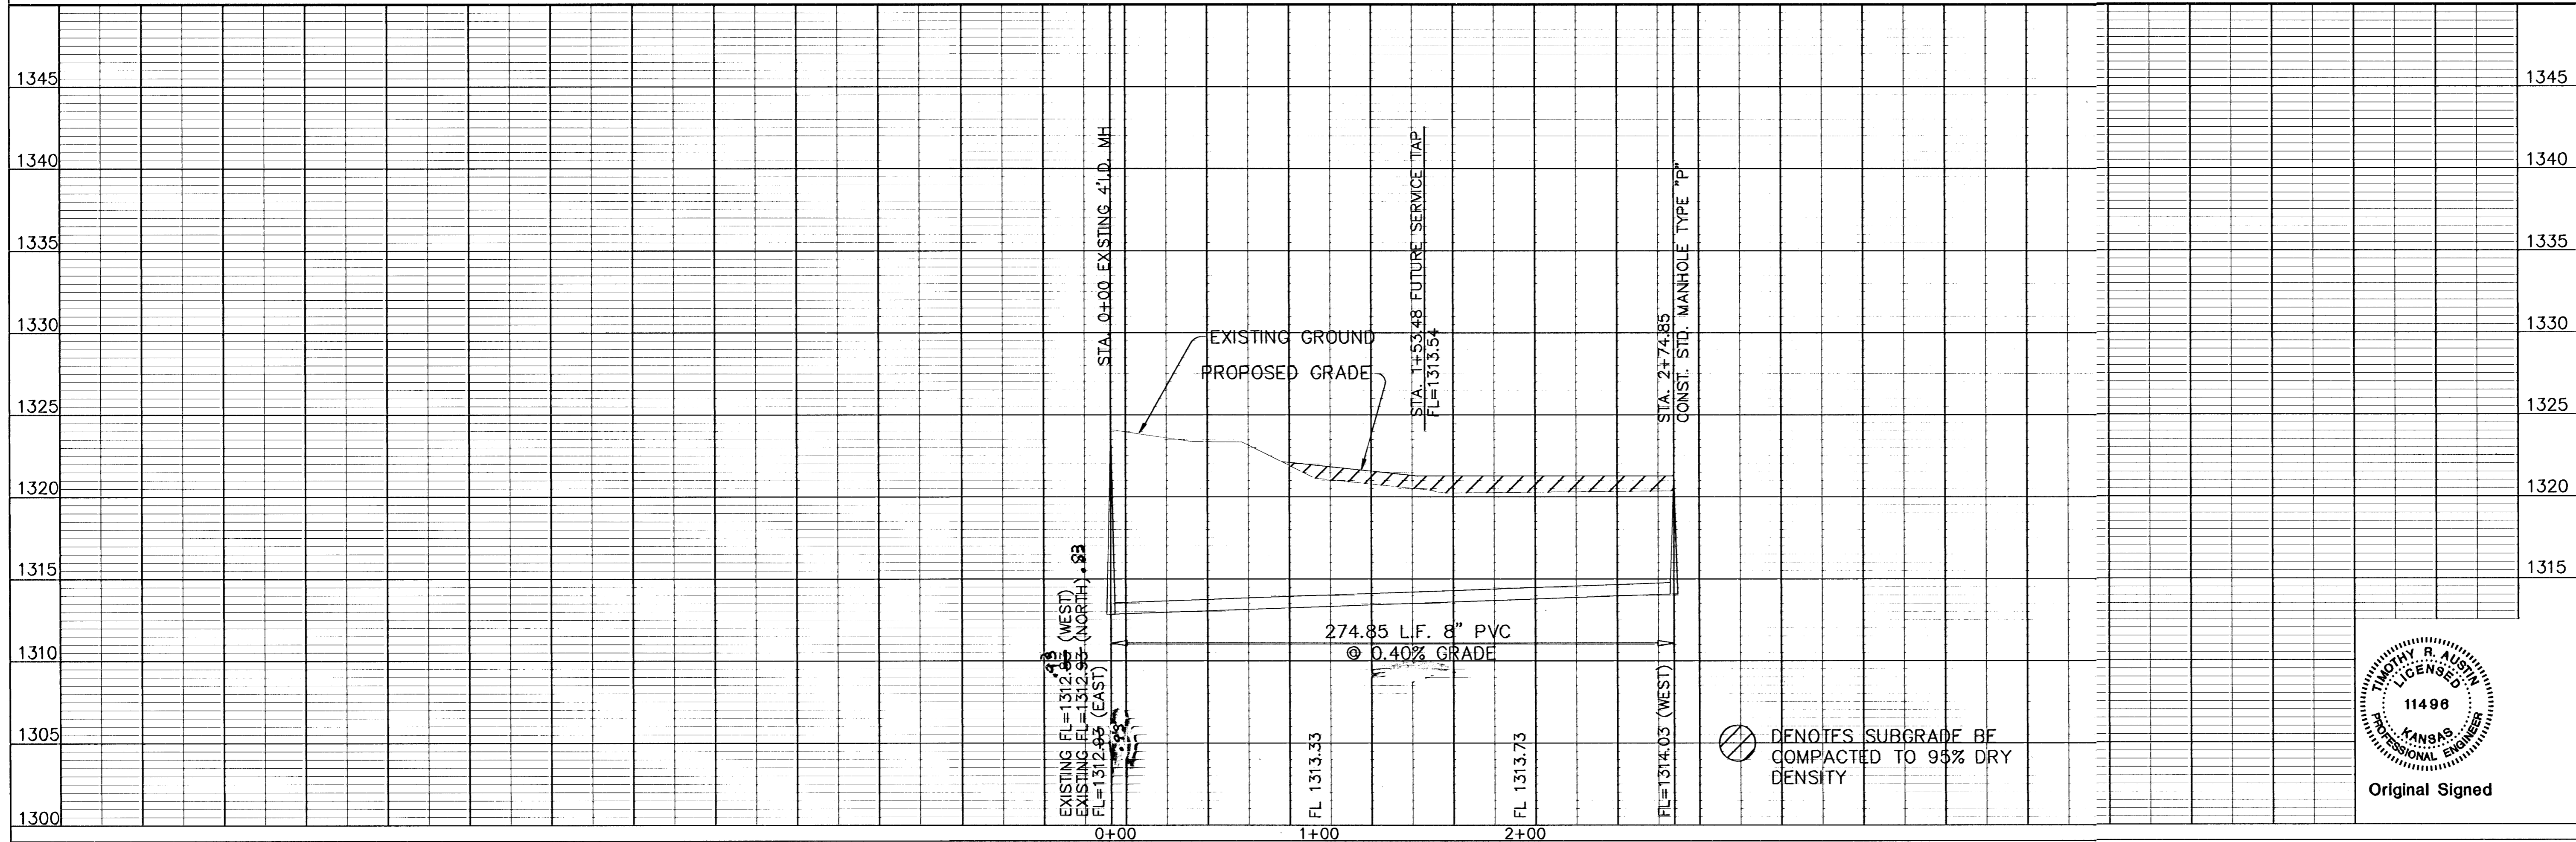


Original Signed

Revision
 Extended Pipe 100' East & Relocated MH
 Date: 10/26/06
 No. 1, 2, 3, 4

QUICKTRIP #315
SANITARY & STORM SEWER IMPROVEMENTS
SANITARY SEWER PLAN & PROFILE
CITY OF WICHITA, KANSAS
 JAMES ARMOUR, P.E. - CITY ENGINEER
 1711 PPS (607861)

POE & ASSOCIATES, INC.
CONSULTING ENGINEERS
 5940 E. Central, Suite 200 Wichita, KS 67208-6422
 Phone: 316/685-4114 FAX: 316/685-4444

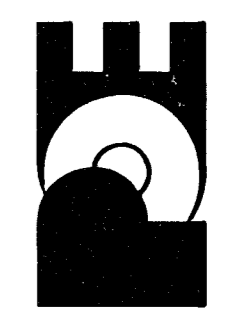

FINAL

Designed By: D. Trout
 Drawn By: D. Trout / A. Moss
 P.O. Job No.: 1894-02
 Date: 10/27/2006