

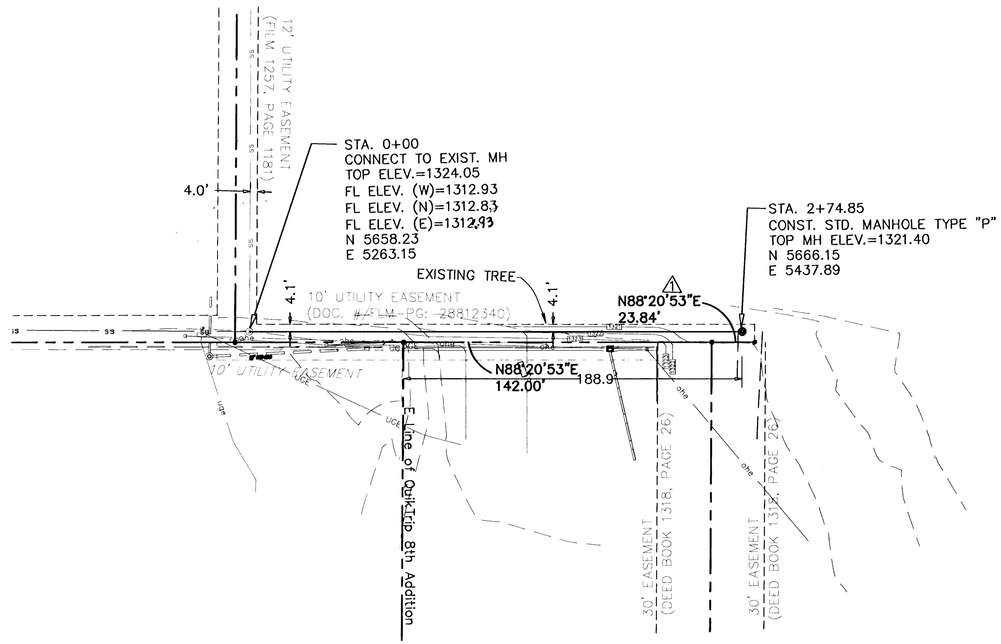


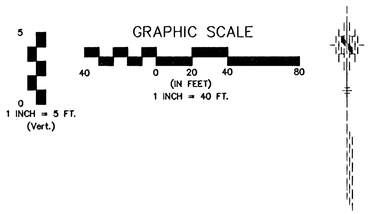

LINE NO. 1

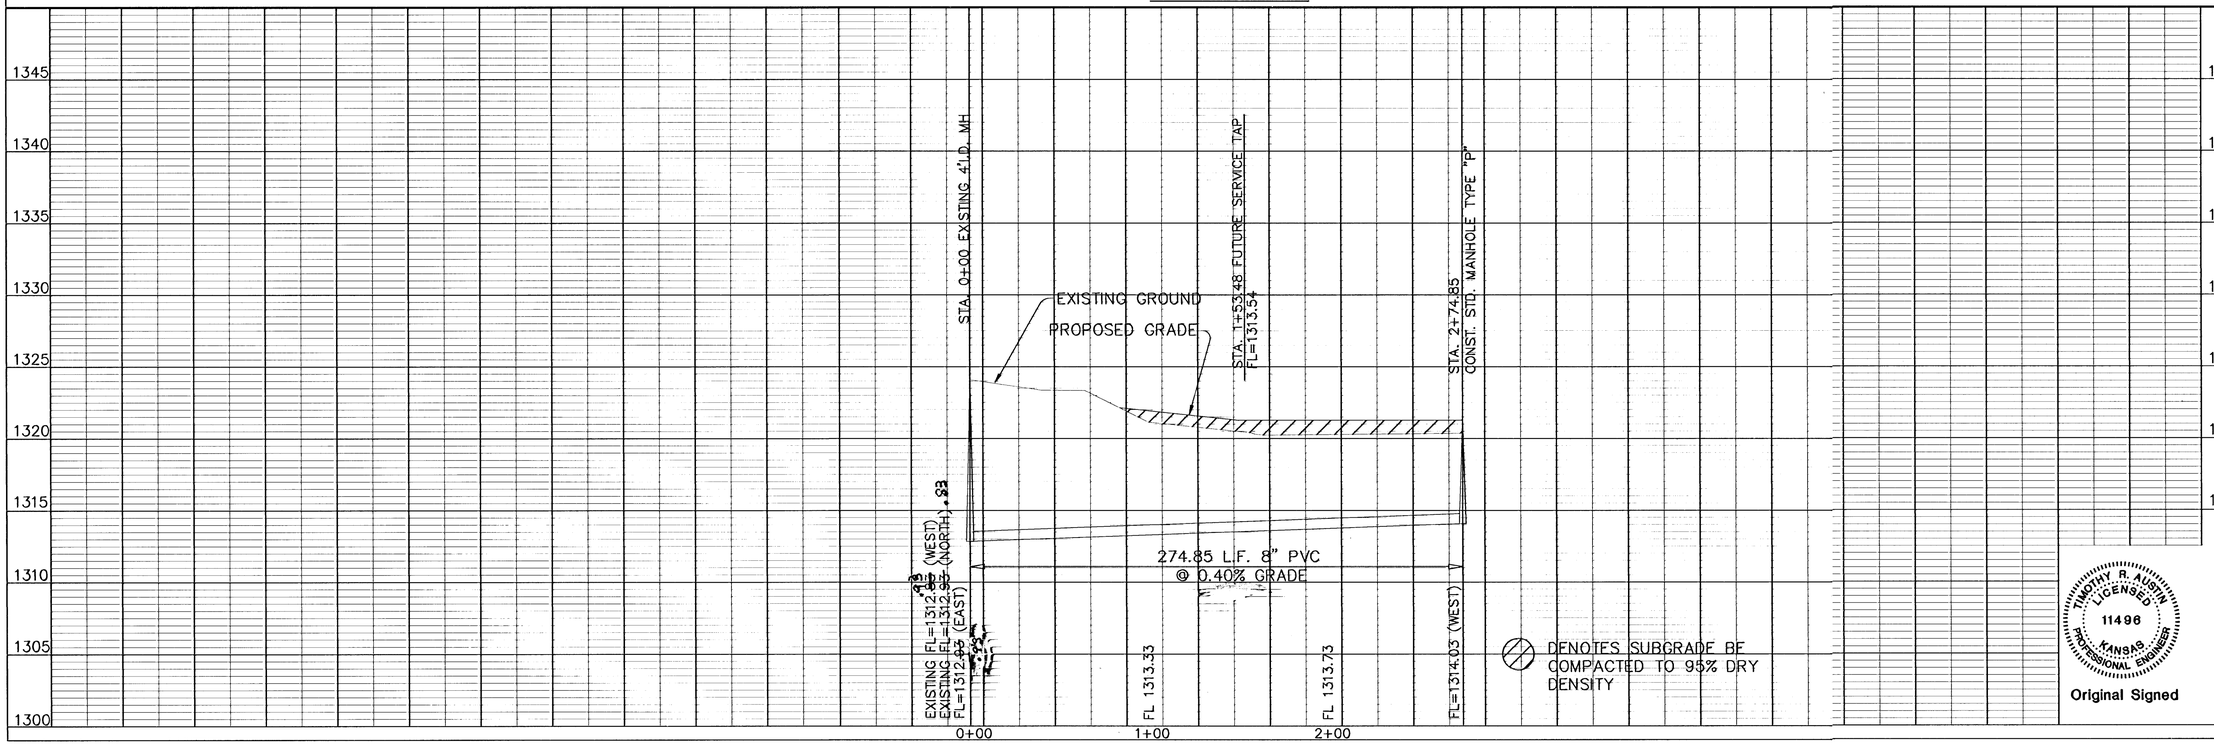

TIMOTHY R. AUSTIN
LICENSED
11496
KANSAS
PROFESSIONAL ENGINEER
Original Signed

FINAL

Designed By: D. Trout
Drawn By: D. Trout \ A. Moss
Poe Job No.: 1894-02
Date: 10/27/2006

Sheet 2 of 6

No.	Date	Revision
1	10/26/06	Extended Pipe 100' East & Relocated MH

QUIKTRIP #315
SANITARY & STORM SEWER IMPROVEMENTS
SANITARY SEWER PLAN & PROFILE
CITY OF WICHITA, KANSAS
JAMES ARMOUR, P.E. – CITY ENGINEER
1711 PPS (607661)

POE & ASSOCIATES, INC.
CONSULTING ENGINEERS
9940 E Central, Suite 200 Wichita, KS 67208-4242
Phone 316/685-4114 ■ FAX 316/685-4444