

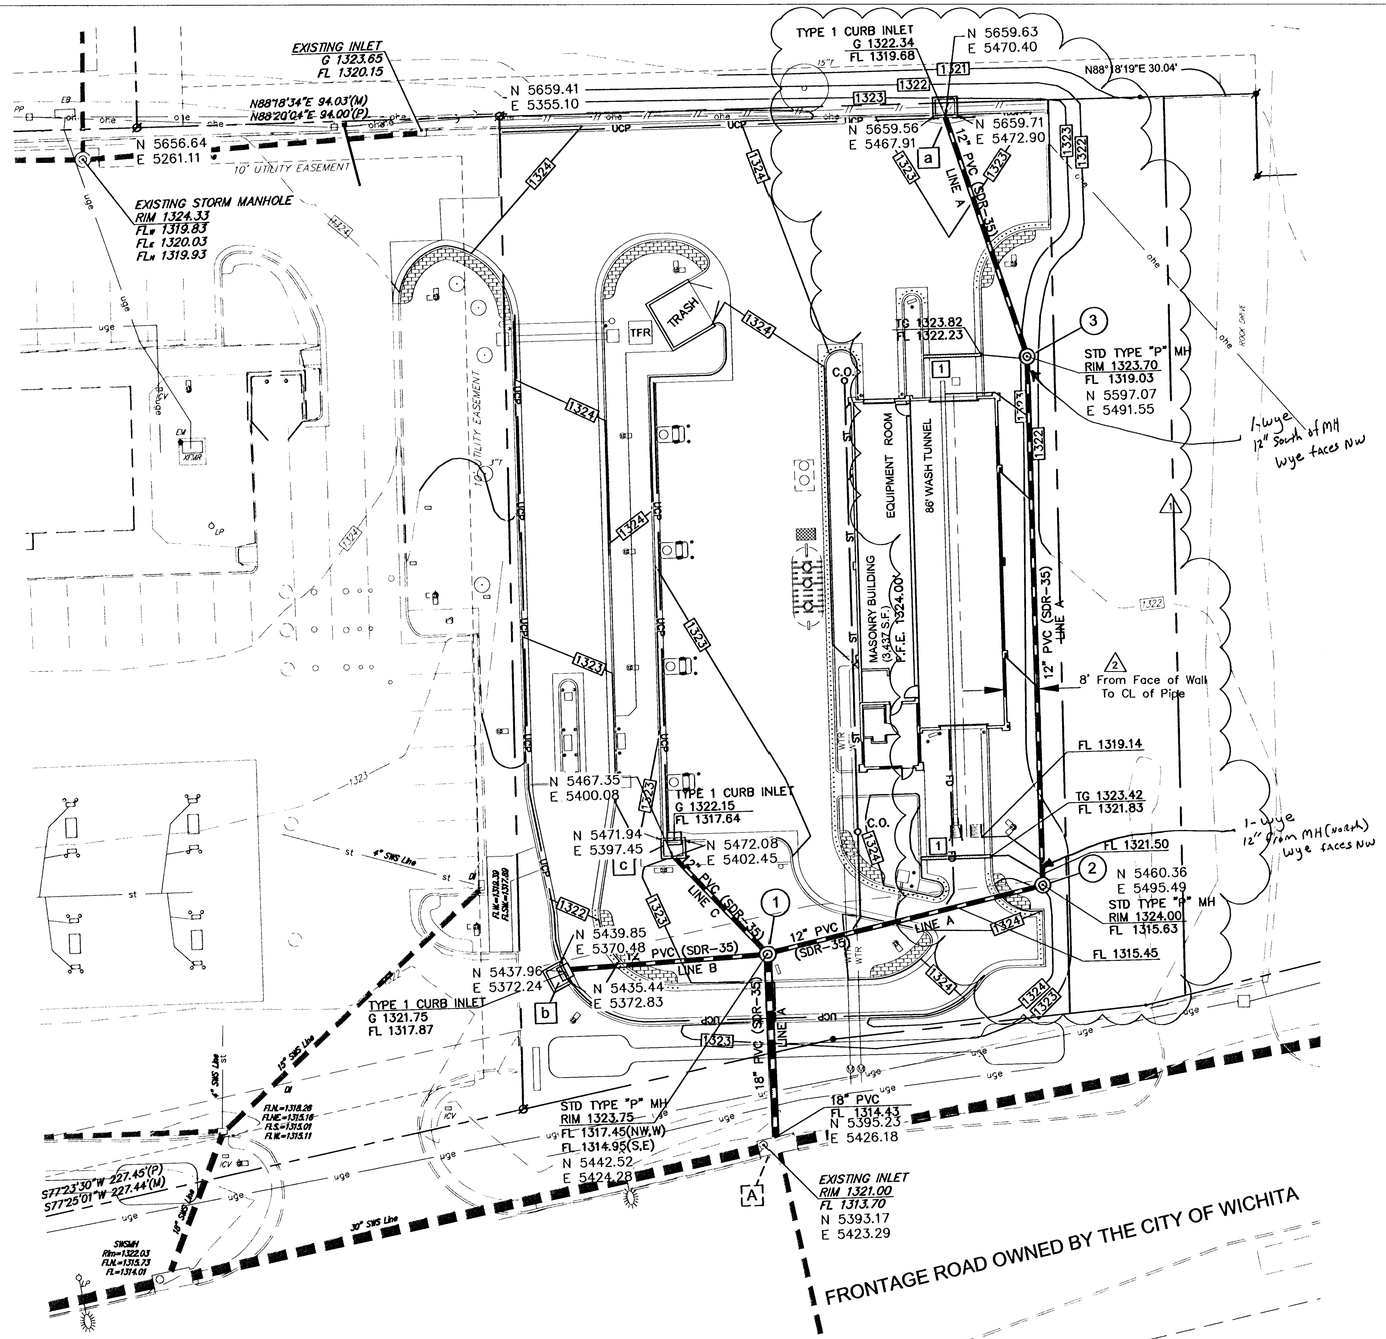


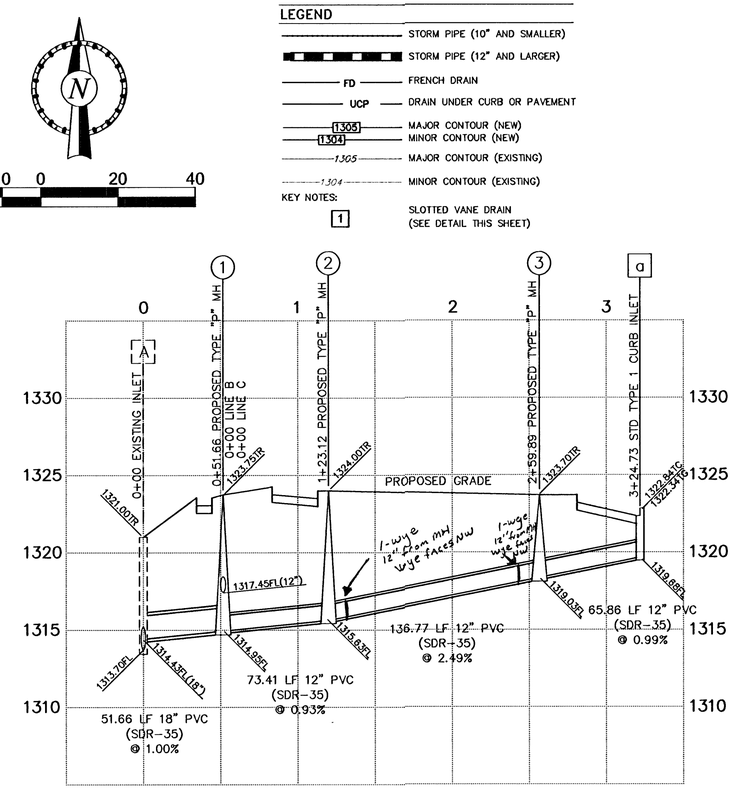


STORM SEWER PROFILE A

HORIZ. SCALE 1"=50'
VERT. SCALE 1"=5'

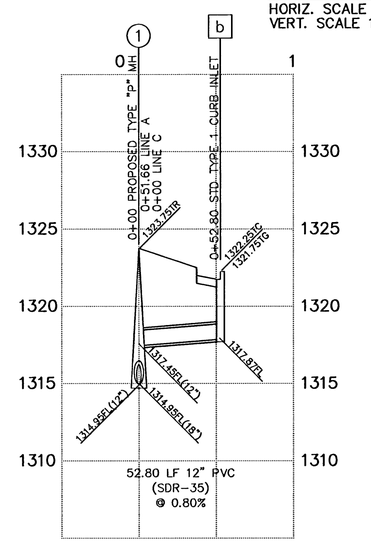


STORM SEWER PROFILE B

HORIZ. SCALE 1"=50'
VERT. SCALE 1"=5'

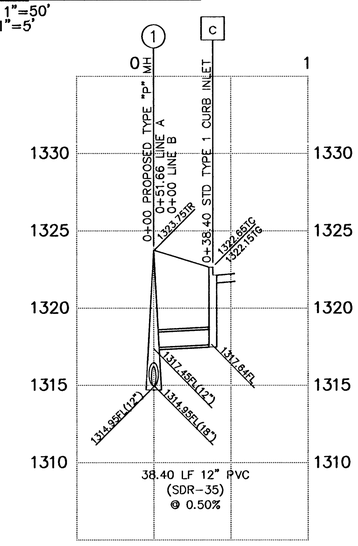

STORM SEWER PROFILE C

HORIZ. SCALE 1"=50'
VERT. SCALE 1"=5'

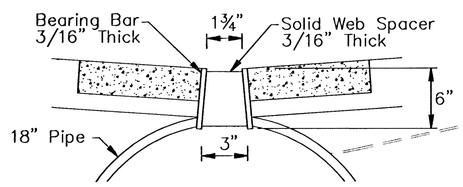

SLOTTED VANE DRAIN

No.	Date	By	Approved	Revision
1	01/19/07	SS	TA	Relocated East Line & Manholes to 6' East of Proposed Building Face and added coordinates
2	01/25/07	SS	TA	Relocated East Line & Manholes to 8' East of Proposed Building Face and Revised Coordinates

QUIKTRIP #315
SANITARY & STORM SEWER IMROVEMENTS
STORM SEWER PLAN AND PROFILES
CITY OF WICHITA, KANSAS
JAMES ARMOUR, P.E. - CITY ENGINEER
1711 PPS (607861)

POE & ASSOCIATES, INC.
CONSULTING ENGINEERS
5940 E. Central, Suite 200 ■ Wichita, KS 67208-4242
Phone 316/685-4111 ■ FAX 316/685-4444

FINAL

Designed By: HRA
Drawn By: JRB/A. Moss/S. Schmidt
Poe Job No.: 1894/02-315/strom-rev.dwg
Date: 01/19/2007

REVISED 01/25/2007