

BENCHMARK:
Railroad Spike in East Face of
Power Pole, East of the NE Corner
of Lot 3, Northridge Plaza Addition
on East Side of Ridge Road
Elev. = 1335.05 M.S.L.

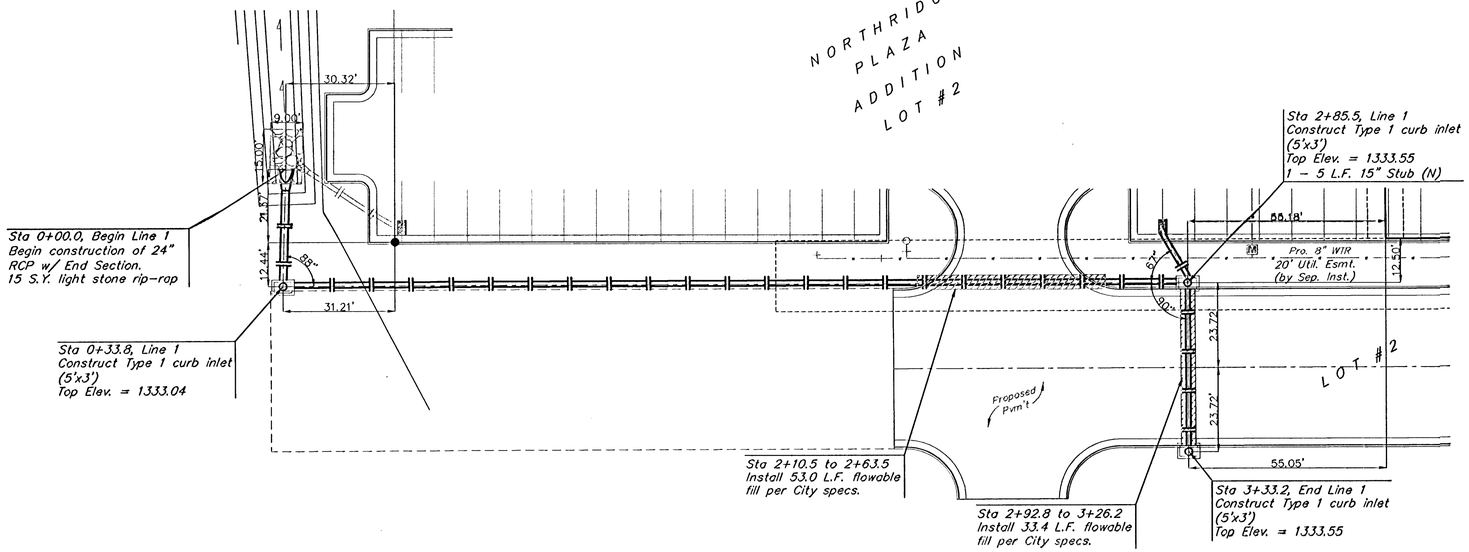


Scale: 1" = 20' Horizontal
1" = 5' Vertical
● = Iron

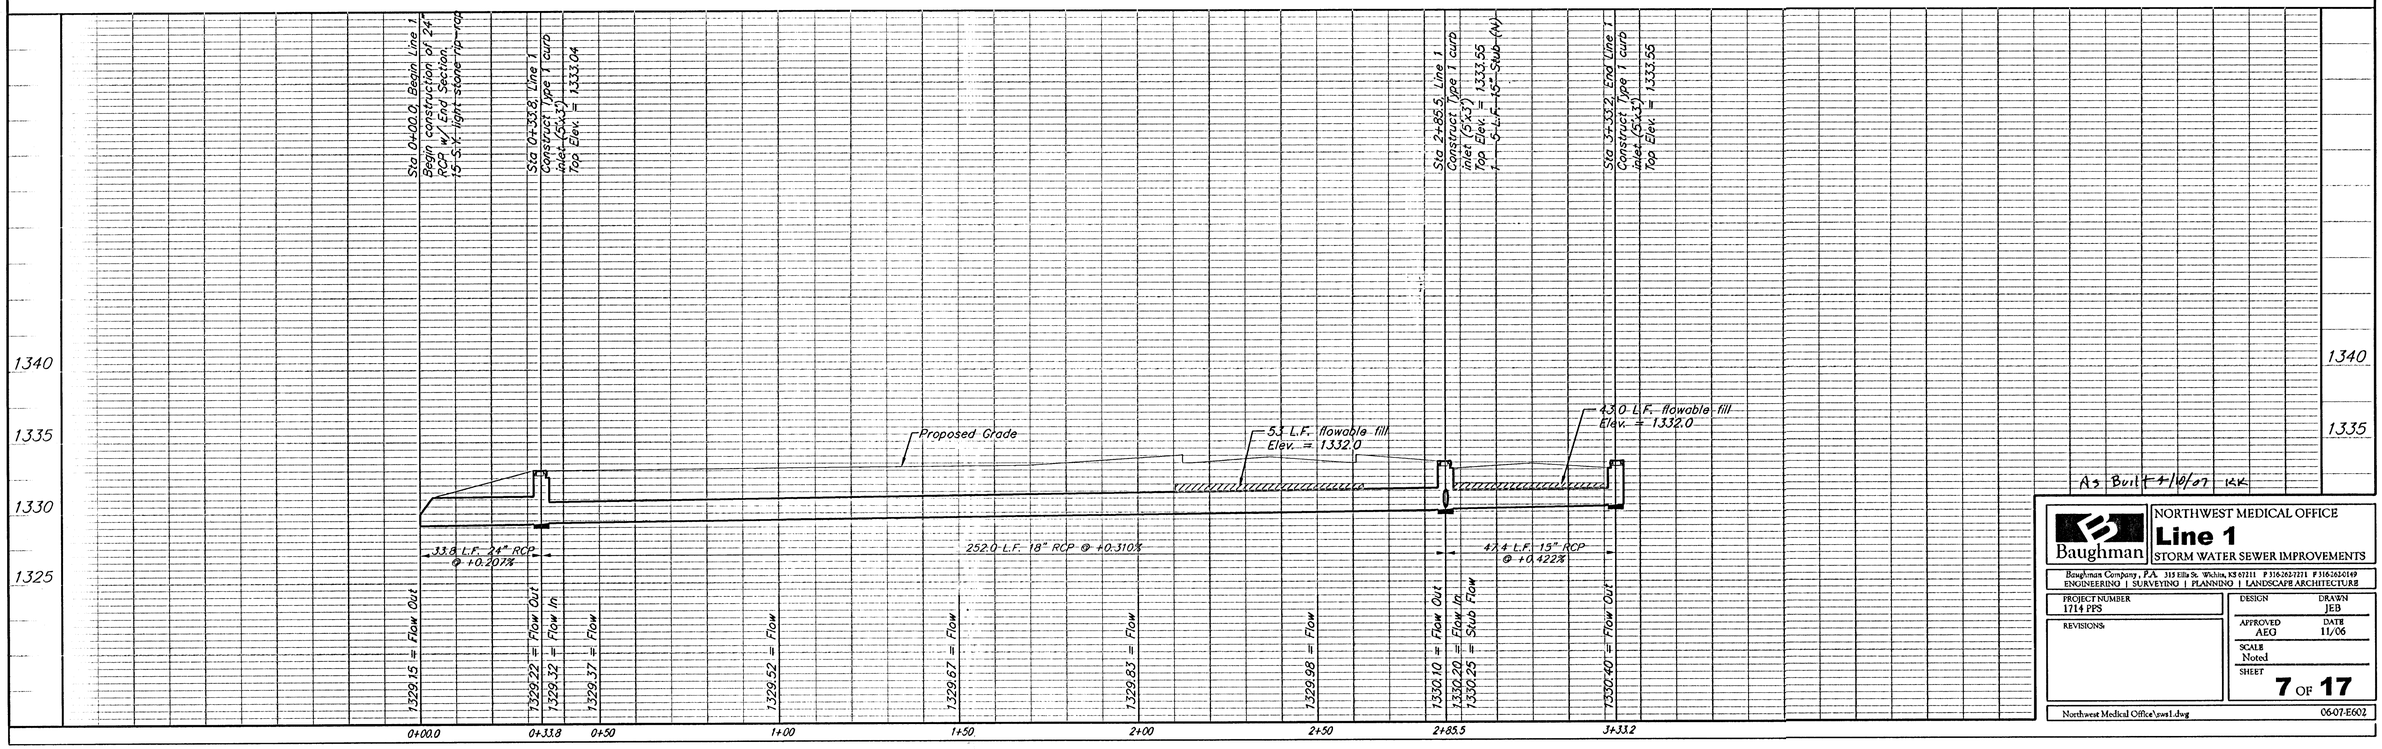


As Built 4/10/07 KK

Baughman

NORTHWEST MEDICAL OFFICE
**Line 1**
STORM WATER SEWER IMPROVEMENTS


Baughman Company, P.A. 315 Ella St. Wichita, KS 67211 P 316.262.7271 F 316.262.6149
ENGINEERING | SURVEYING | PLANNING | LANDSCAPE ARCHITECTURE


| | |
|---|---|
| PROJECT NUMBER 1714 PPS | DESIGN — DRAWN JEB |
| REVISIONS: | APPROVED AEG — DATE 11/06 |
| | SCALE Noted |
| | SHEET **7** OF **17** |

Northwest Medical Office\sw1.dwg — 0607-E602