SHEET NO.	TOTAL SHEETS
CS1.4	

SCALE:

PLAN: LAT. & LONG. 0 40 80

PROFILE: HORIZ. SAME AS ABOVE

VERT. 0 5

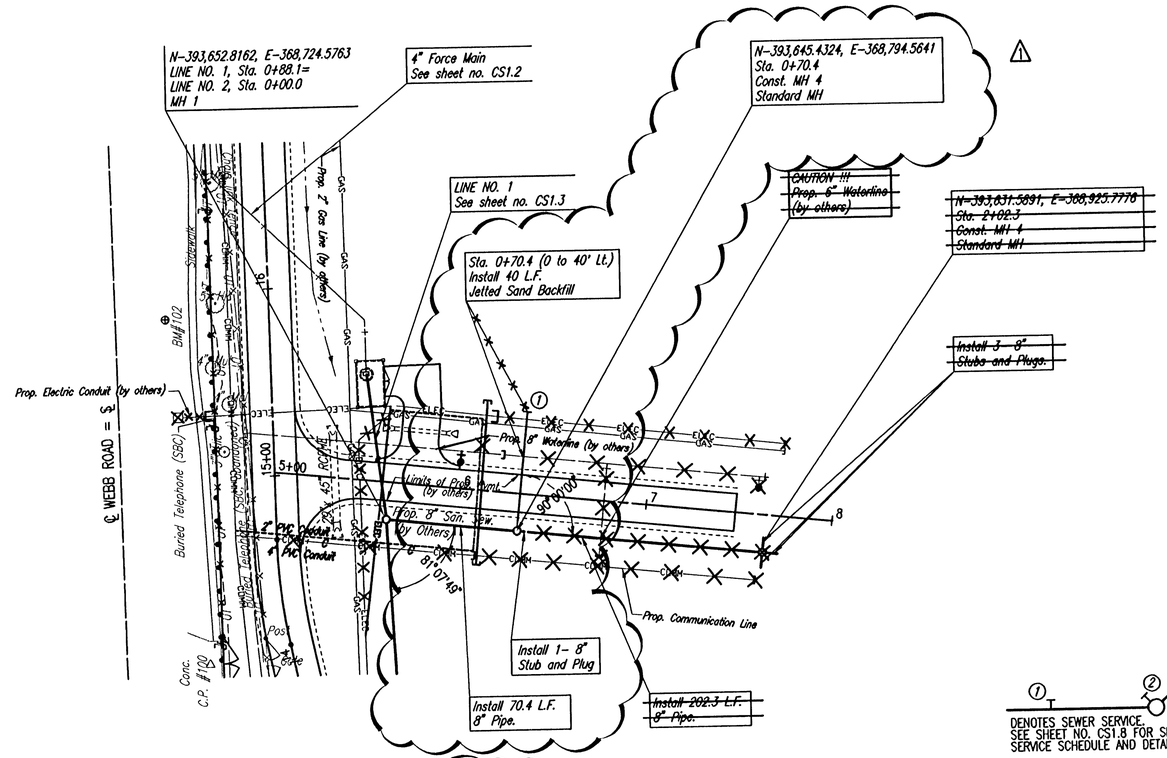

DENOTES SEWER SERVICE.
SEE SHEET NO. CS1.8 FOR SEWER
SERVICE SCHEDULE AND DETAILS

RECORD DRAWING

26 JAN 07

No.	Revision	By	Date
1	CHANGE ORDER #1 - SANITARY SEWER ALIGNMENT ADJUSTMENT	AJA	10/12/06

SANITARY SEWER LINE NO. 2

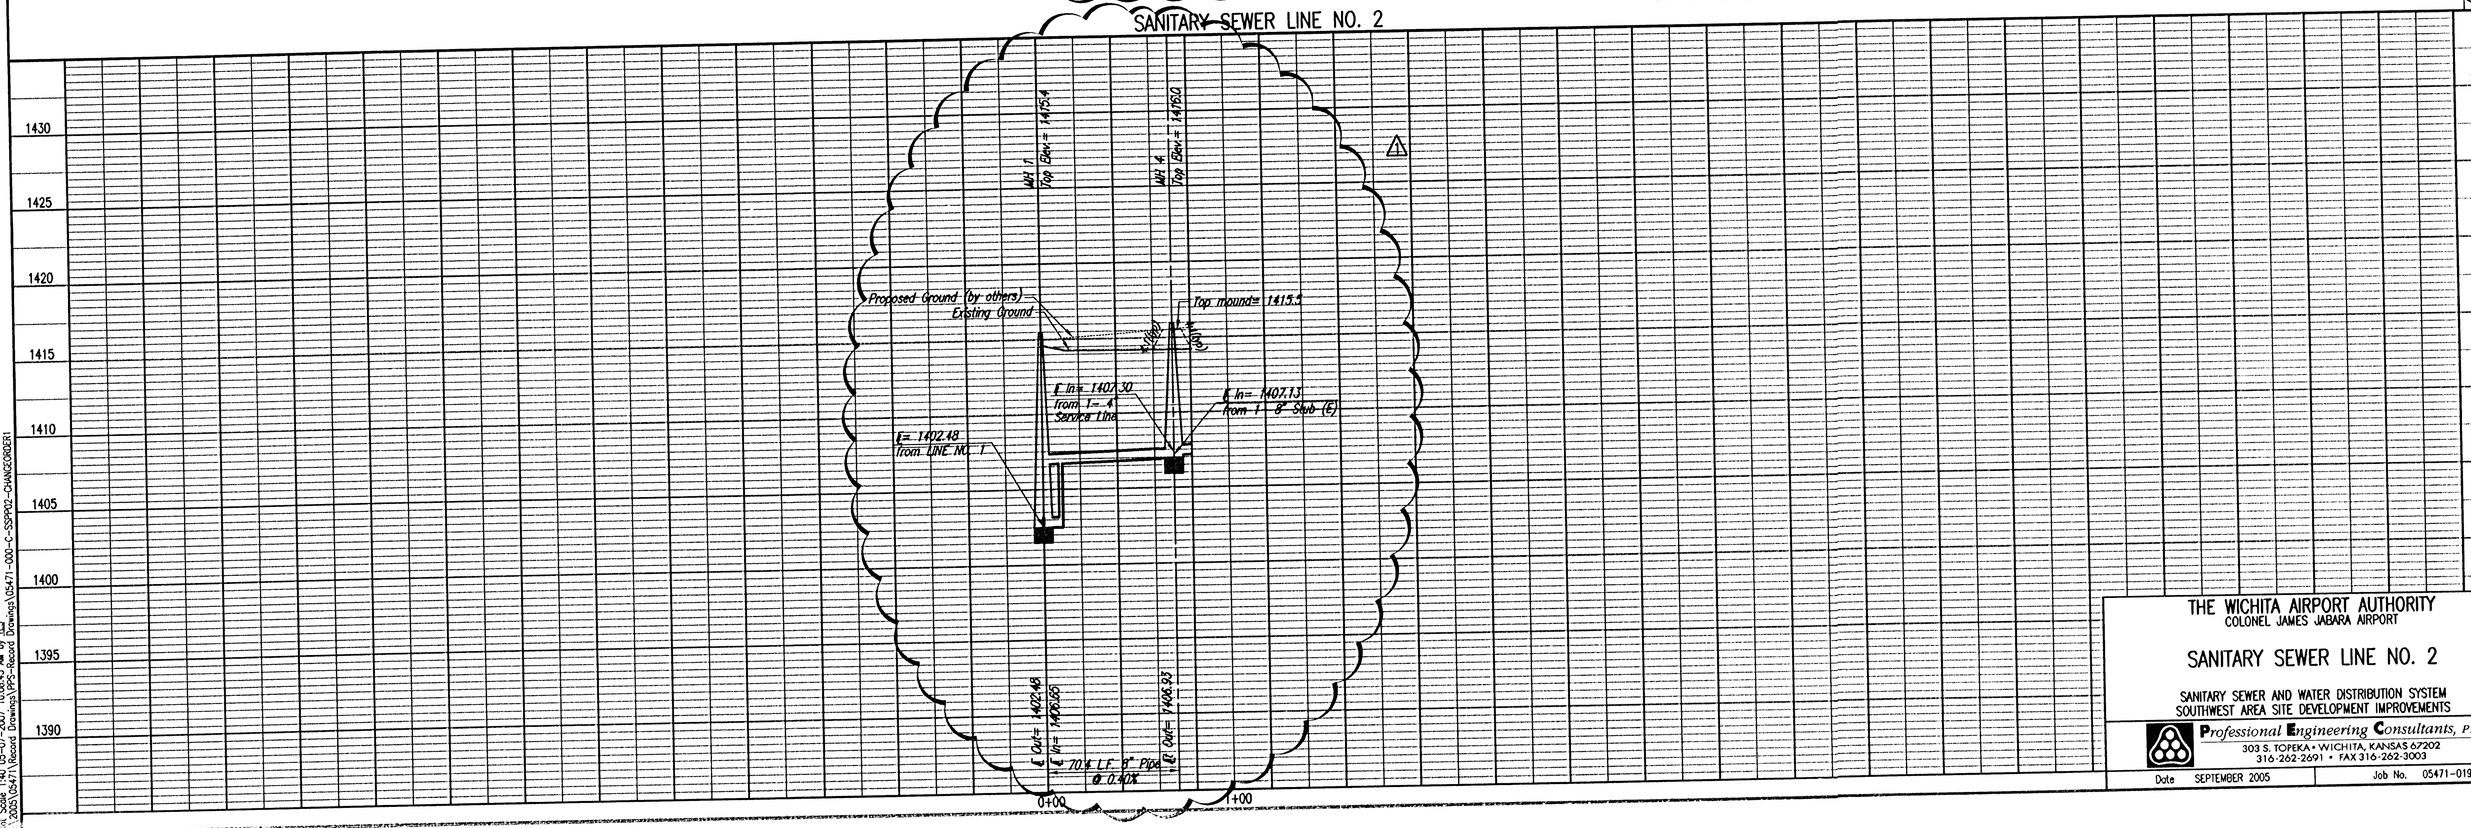

THE WICHITA AIRPORT AUTHORITY
COLONEL JAMES JABARA AIRPORT

SANITARY SEWER LINE NO. 2

SANITARY SEWER AND WATER DISTRIBUTION SYSTEM
SOUTHWEST AREA SITE DEVELOPMENT IMPROVEMENTS

Professional Engineering Consultants, P.A.
303 S. TOPEKA • WICHITA, KANSAS 67202
316-262-2691 • FAX 316-262-3003

Date SEPTEMBER 2005 Job No. 05471-019

Saved 04-11-2007 8:47:46 AM by TLS
PLOT: Scale:1:40 05-07-2007 10:08:43 AM by TLS
G:\2005\05471\Record Drawings\RFS-Record Drawings\05471-000-C-SSPR02-CHANGEORDER1