



BENCHMARK:
Railroad Spike in East Face of Power Pole, East of the NE Corner of Lot 3, Northridge Plaza Addition on East Side of Ridge Road
Elev. = 1335.05 M.S.L.

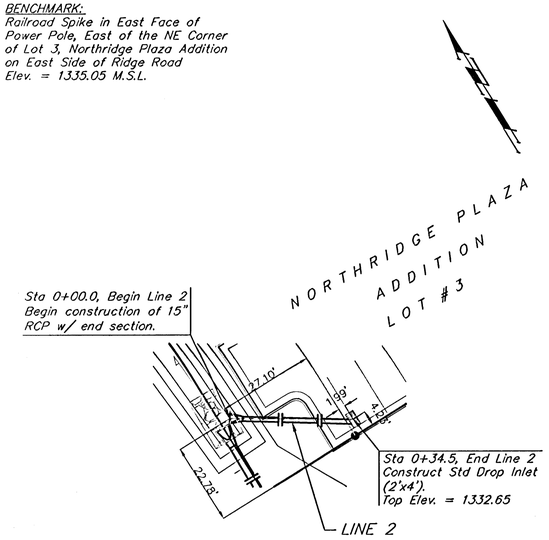


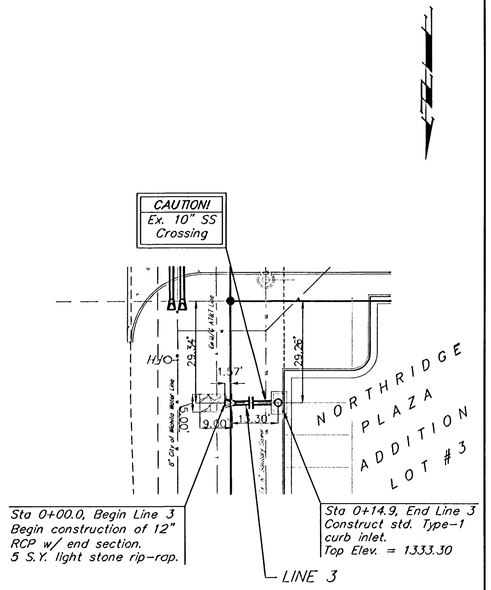

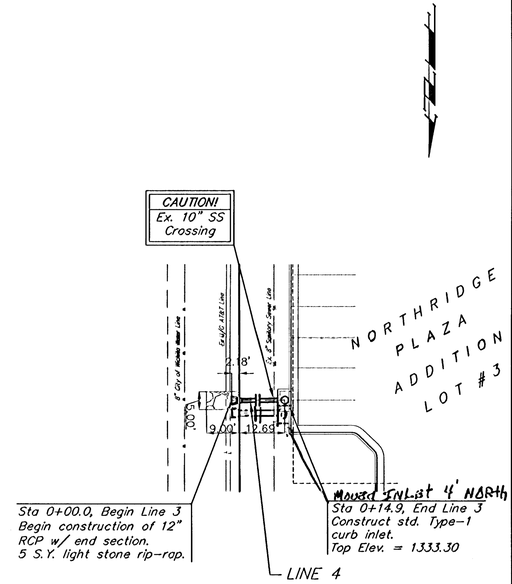

Scale: 1" = 20' Horizontal
1" = 5' Vertical
● = Iron

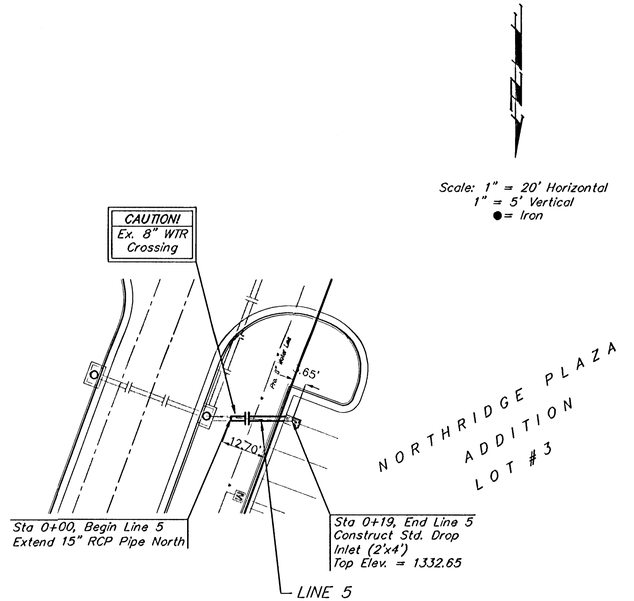

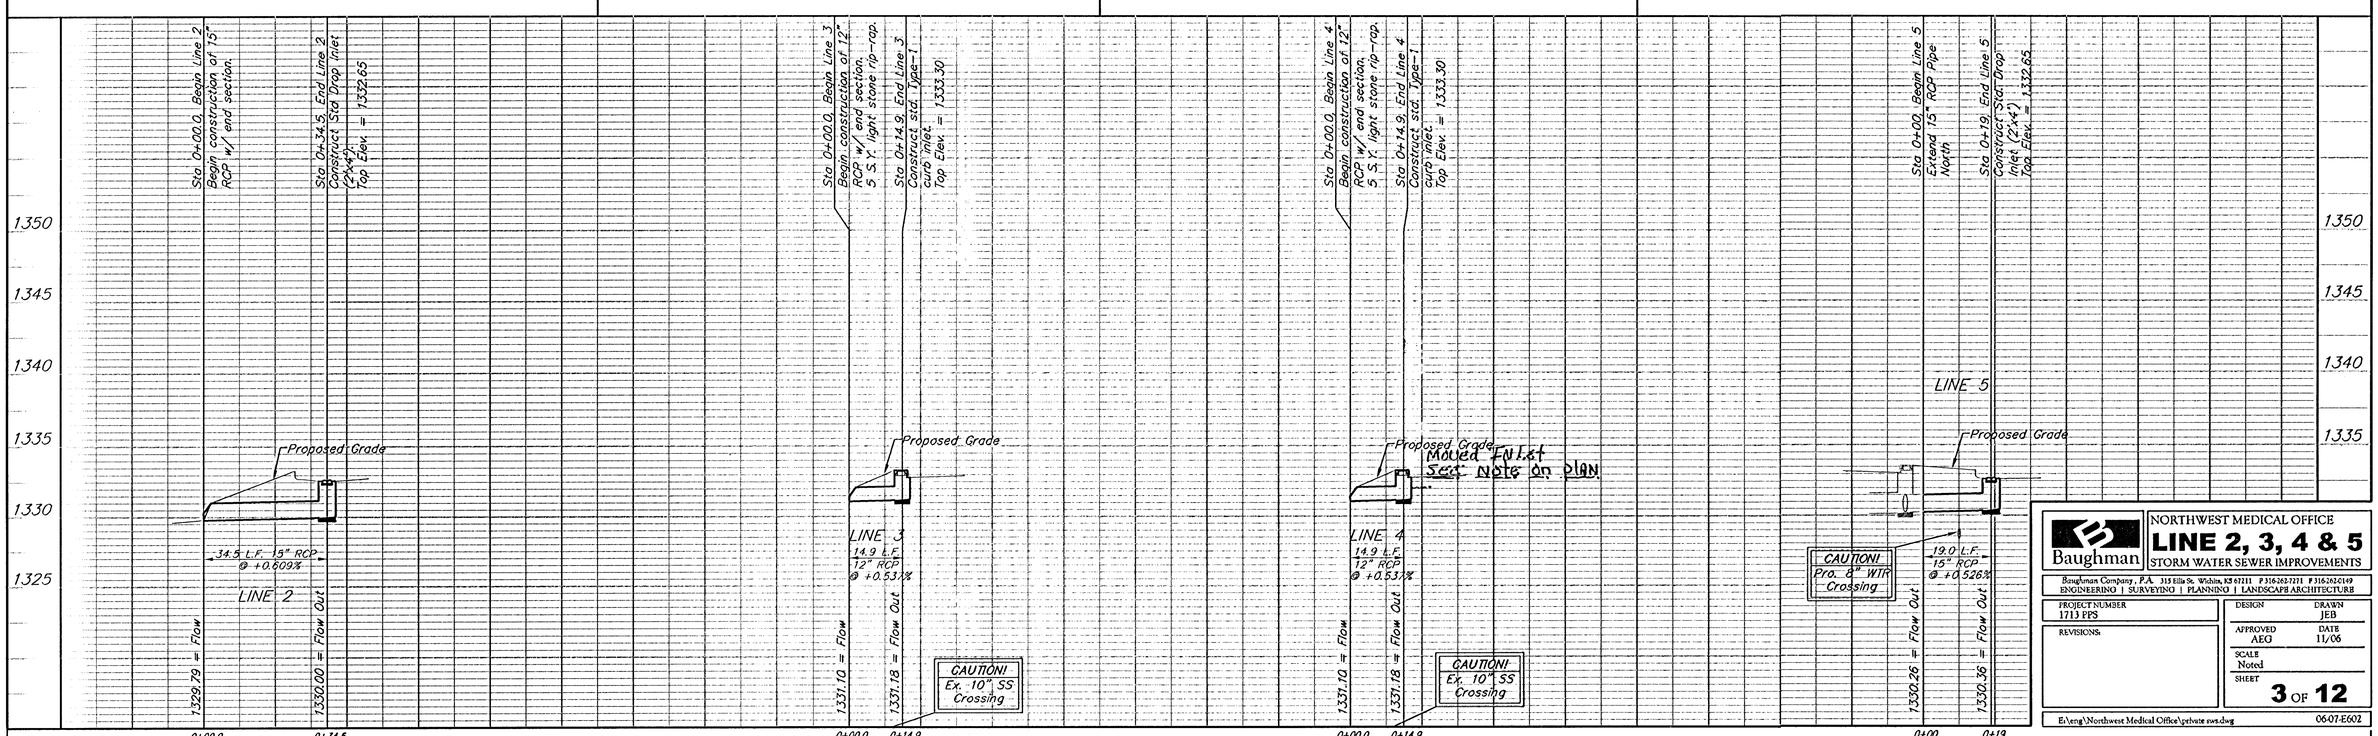

Baughman

NORTHWEST MEDICAL OFFICE
LINE 2, 3, 4 & 5
STORM WATER SEWER IMPROVEMENTS

Baughman Company, P.A. 315 Ellis St. Wichita, KS 67211 P 3162622771 F 3162622149
ENGINEERING | SURVEYING | PLANNING | LANDSCAPE ARCHITECTURE

PROJECT NUMBER	DESIGN	DRAWN
1713 PPS		JEB
REVISIONS:	APPROVED AEG	DATE 11/06
	SCALE Noted	
	SHEET 3 OF 12	

E:\eng\Northwest Medical Office\private swrs.dwg 06-07-E602

NORTHWEST MEDICAL OFFICE AS-BUILTS 5-7-07
T.H / CED