



DEETER #2433 GRATE


NOTE: Grates shall be imprinted on the top surface with "CITY OF WICHITA" using letters at least 1" in height. Other marking methods may be approved by the engineer.


24" x 24" Frame and Grate Detail

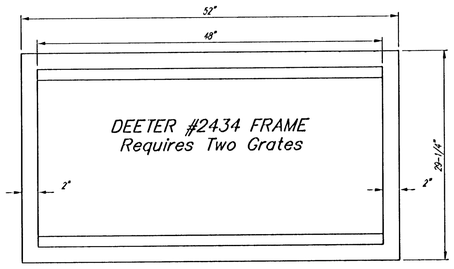


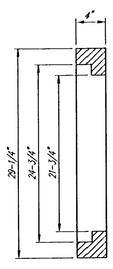

Double 24" x 24" Frame Detail

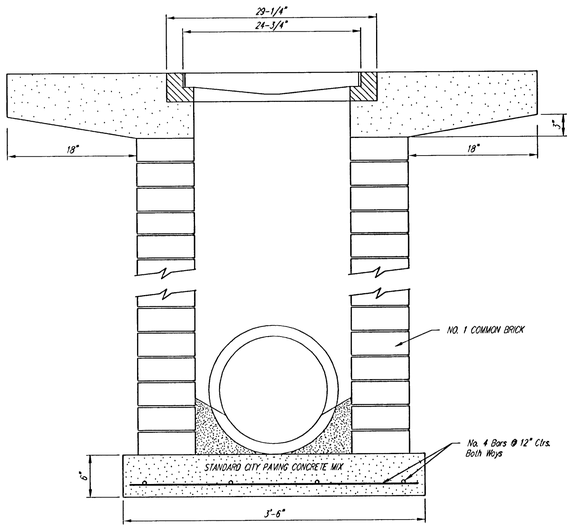

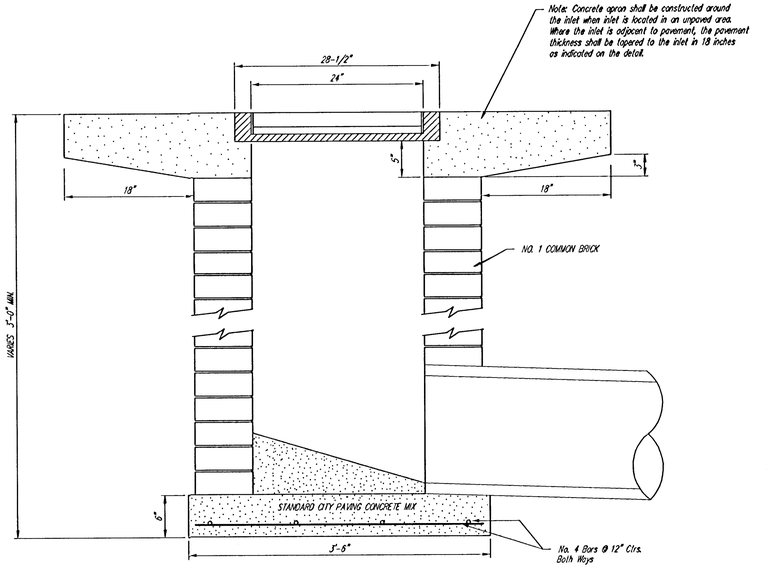

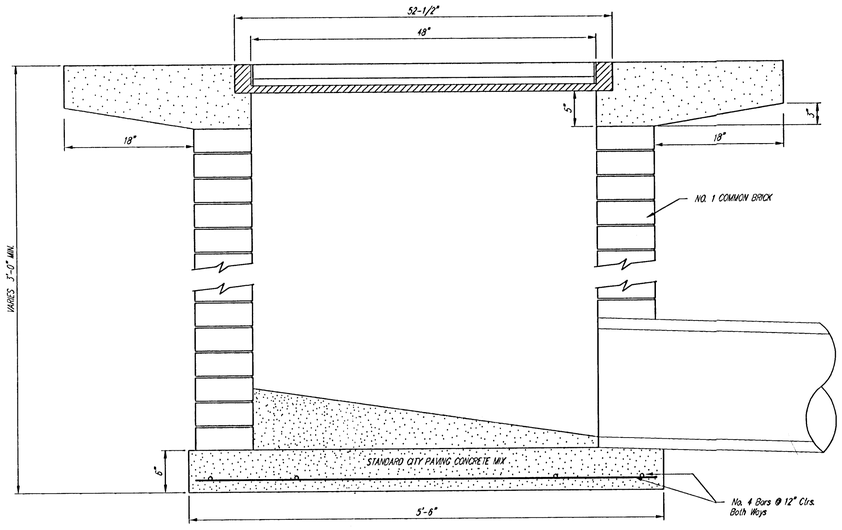

Baughman

City of Wichita Standard
Drop Inlet Detail

Baughman Company, P.A. 315 Lilla St. Wichita, KS 67211 P 316.263.7271 F 316.263.0149
ENGINEERING | SURVEYING | PLANNING | LANDSCAPE ARCHITECTURE

PROJECT NUMBER 1713 PPS	DESIGN C.O.W. / DRAWN Staff
REVISIONS:	APPROVED / DATE 11/06
	SCALE None
	SHEET **6** OF **12**

F:\Eng\Details\Sewers\DROPINT2.svg 06-07-E602

Northwest Medical Office As-Built's
T.H/C.E.D 5-7-07