

**EROSION CONTROL PLAN LEGEND**  
(Materials Details Found in the S&P Plan)

- LIGHT STONE RIP-RAP
- DROP INLET PROTECTION
- CURB INLET PROTECTION
- STRAW BALE BARRIERS
- SILT FENCING
- EARTH DIKES
- VEGETATED AREA LEFT UNDISTURBED


NO SCALE

EROSION CONTROL MEASURE	UNITS	QUANTITY
SILT FENCE	L.F.	0
RIPRAP	S.Y.	0
DROP INLET BARRIER	EA.	4
CURB INLET BARRIER	EA.	2
STRAW BALE DITCH CHECK	EA.	0
TRENCH & BERM	L.F.	0
CURLEX	S.Y.	0
POND E.C. BLANKET	S.Y.	0
Construction Entrance	EA.	0

QUANTITIES ARE FOR INFORMATION ONLY  
CONTRACTOR SHALL VERIFY QUANTITIES PER  
FINAL BID QUANTITY SHEET.


**NOTE:** Contractor shall remove & replace existing erosion control measures as necessary for construction. Contractor shall be required to maintain all on-site erosion control items until final acceptance by the City of Wichita.

Remove trees ONLY as necessary for construction. Cost of removal to be incidental to lump sum bid item "Site Clearing & Restoration".

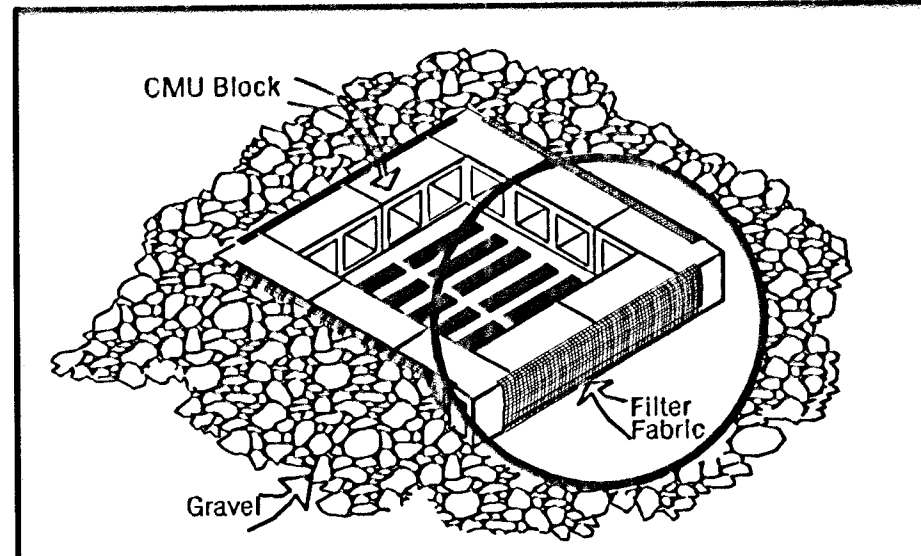


**NOTES:**  
Frequent maintenance is required to minimize short-circuiting and to remove sediment deposits and buildup.  
Wrap filter fabric around all CMU block and backfill with 2"-3" gravel rock to allow sediment deposits.  
DO NOT cover inlet or grate with filter fabric.

**INLET PROTECTION**  
Storm Drain with Gravel Apron

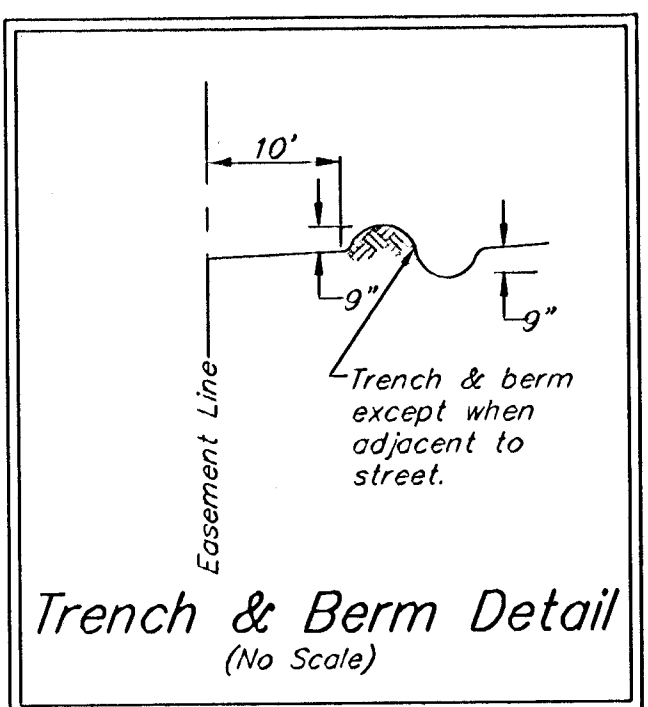

Scale: 1" = 40'

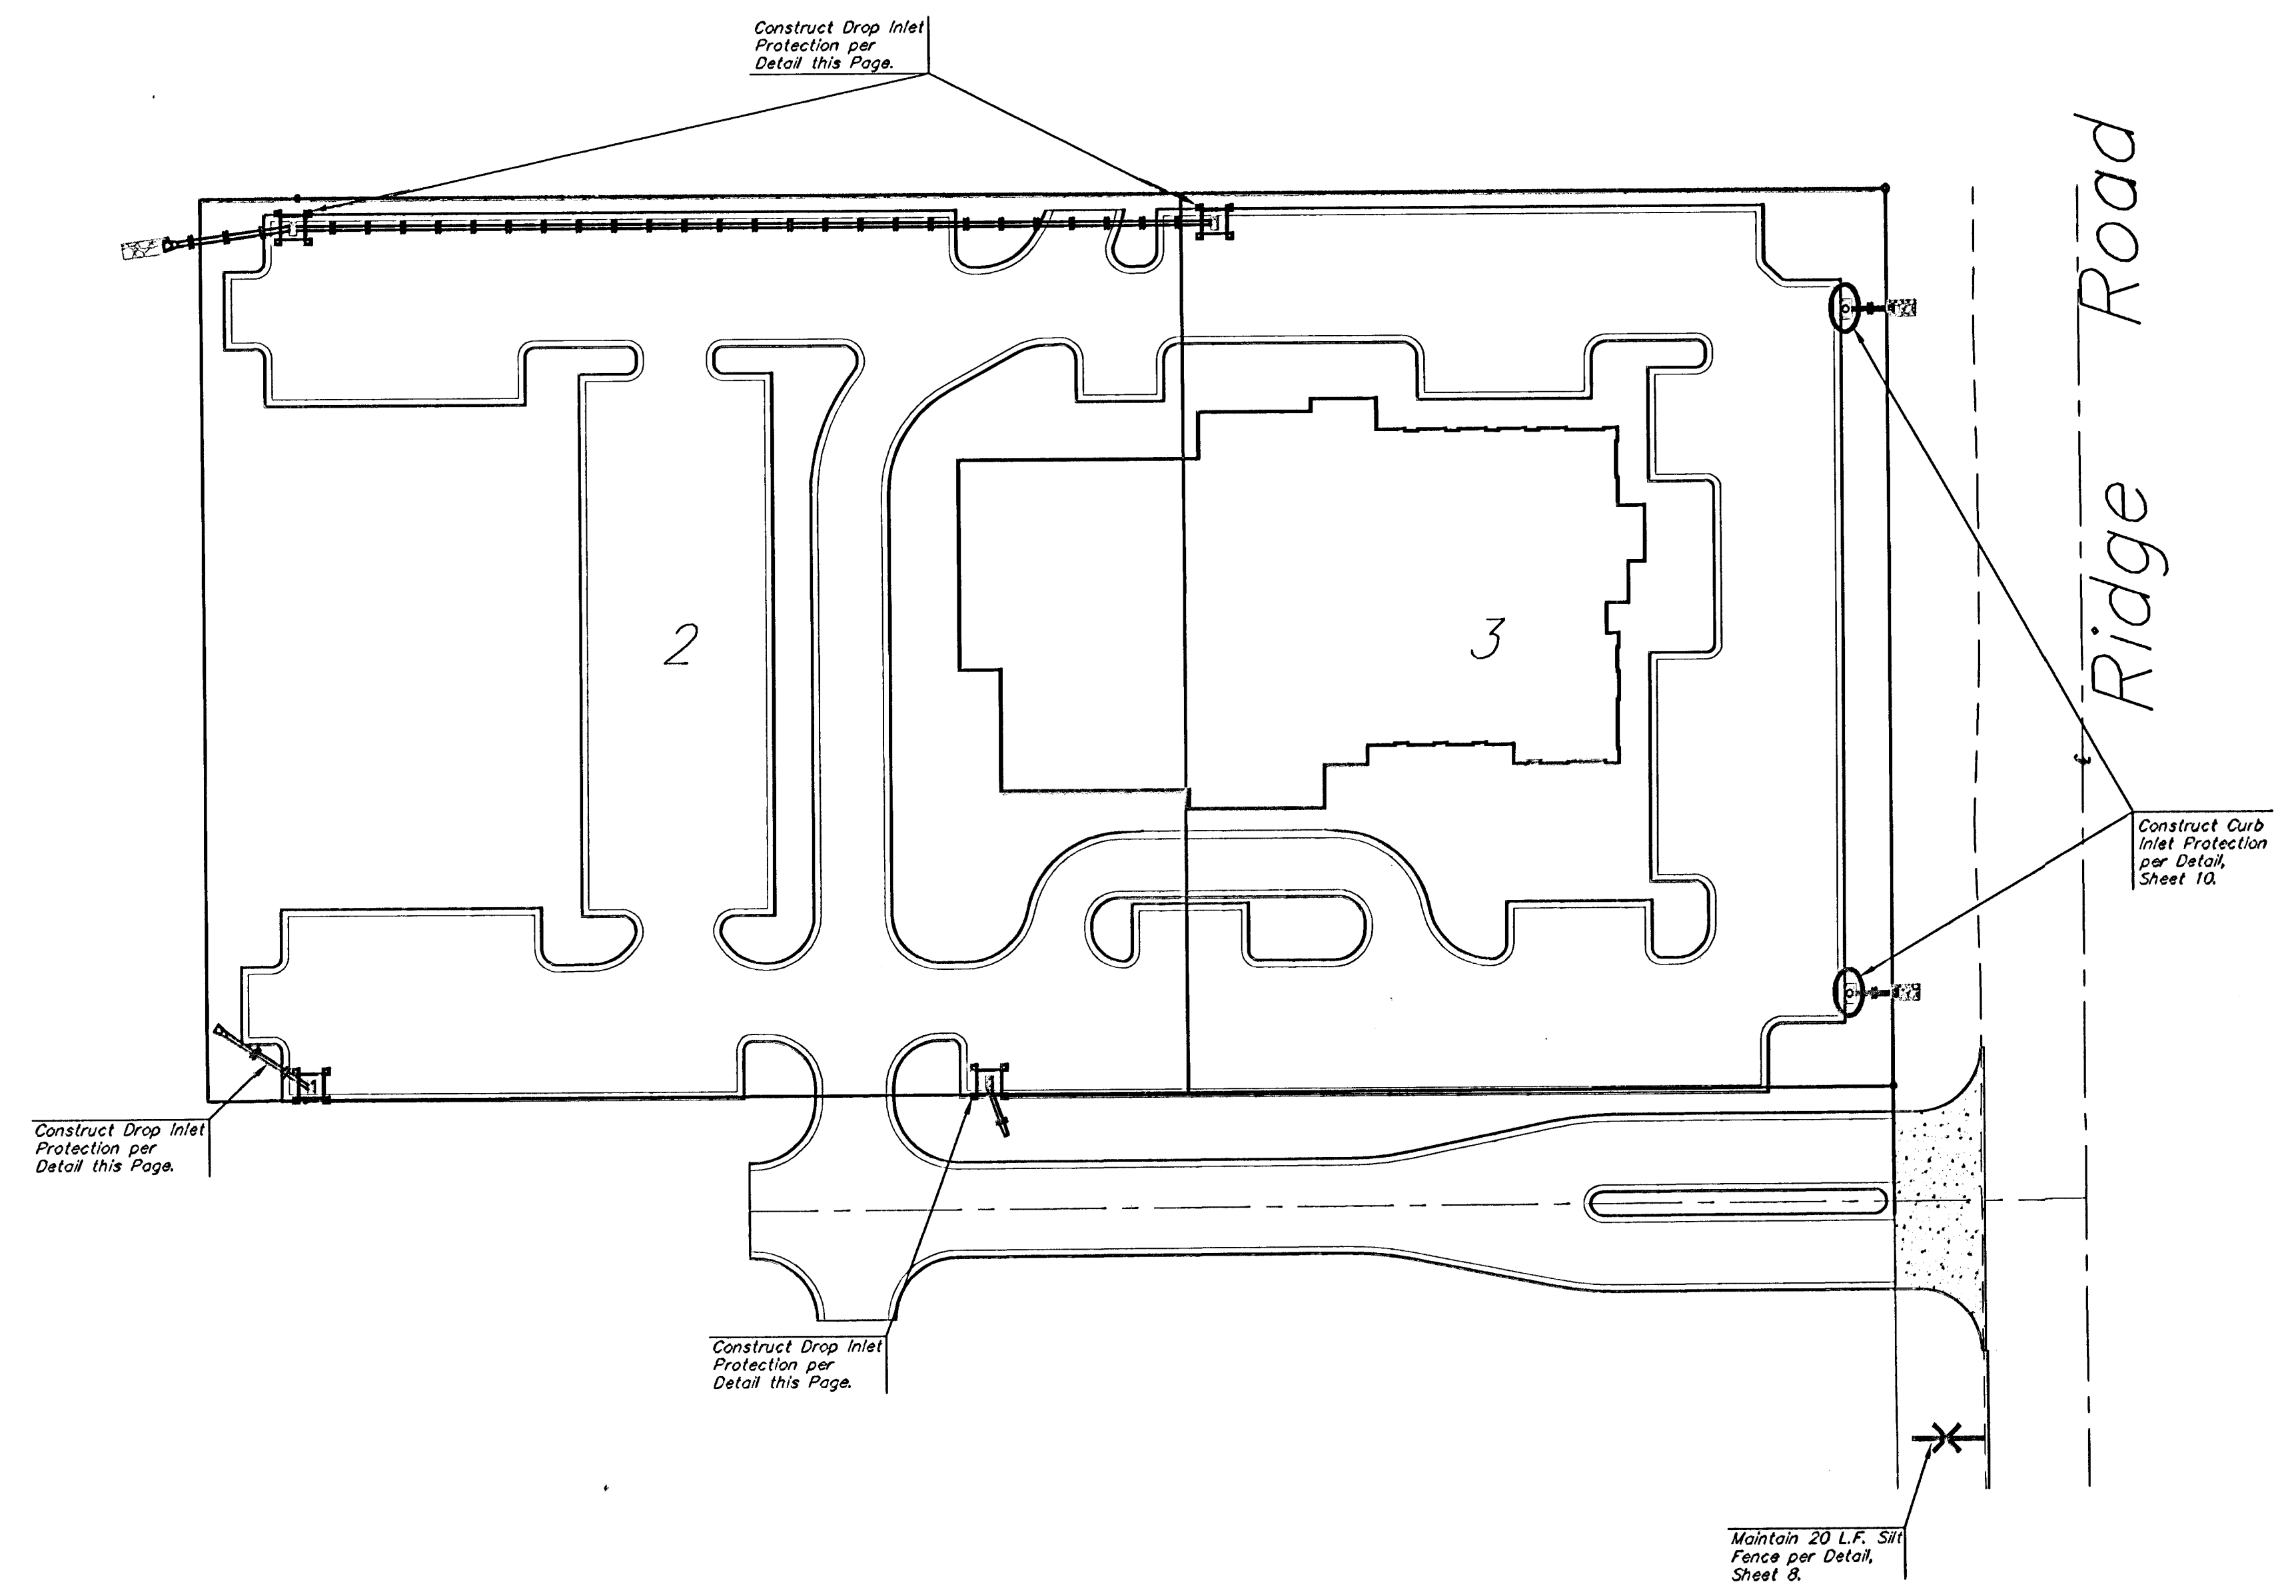

**Baughman**  
Baughman Company, P.A. 315 Ellis St. Wichita, KS 67211 P 316.262.7271 F 316.262.0149  
ENGINEERING | SURVEYING | PLANNING | LANDSCAPE ARCHITECTURE  
PROJECT NUMBER 1713 PPS SHEET **7 OF 12**  
E:\eng\Northwest Medical Office\privatesecmap.dwg 06-07-E602

NORTHWEST MEDICAL OFFICE AS. BUILT'S 5-7-07  
T.H./CED