


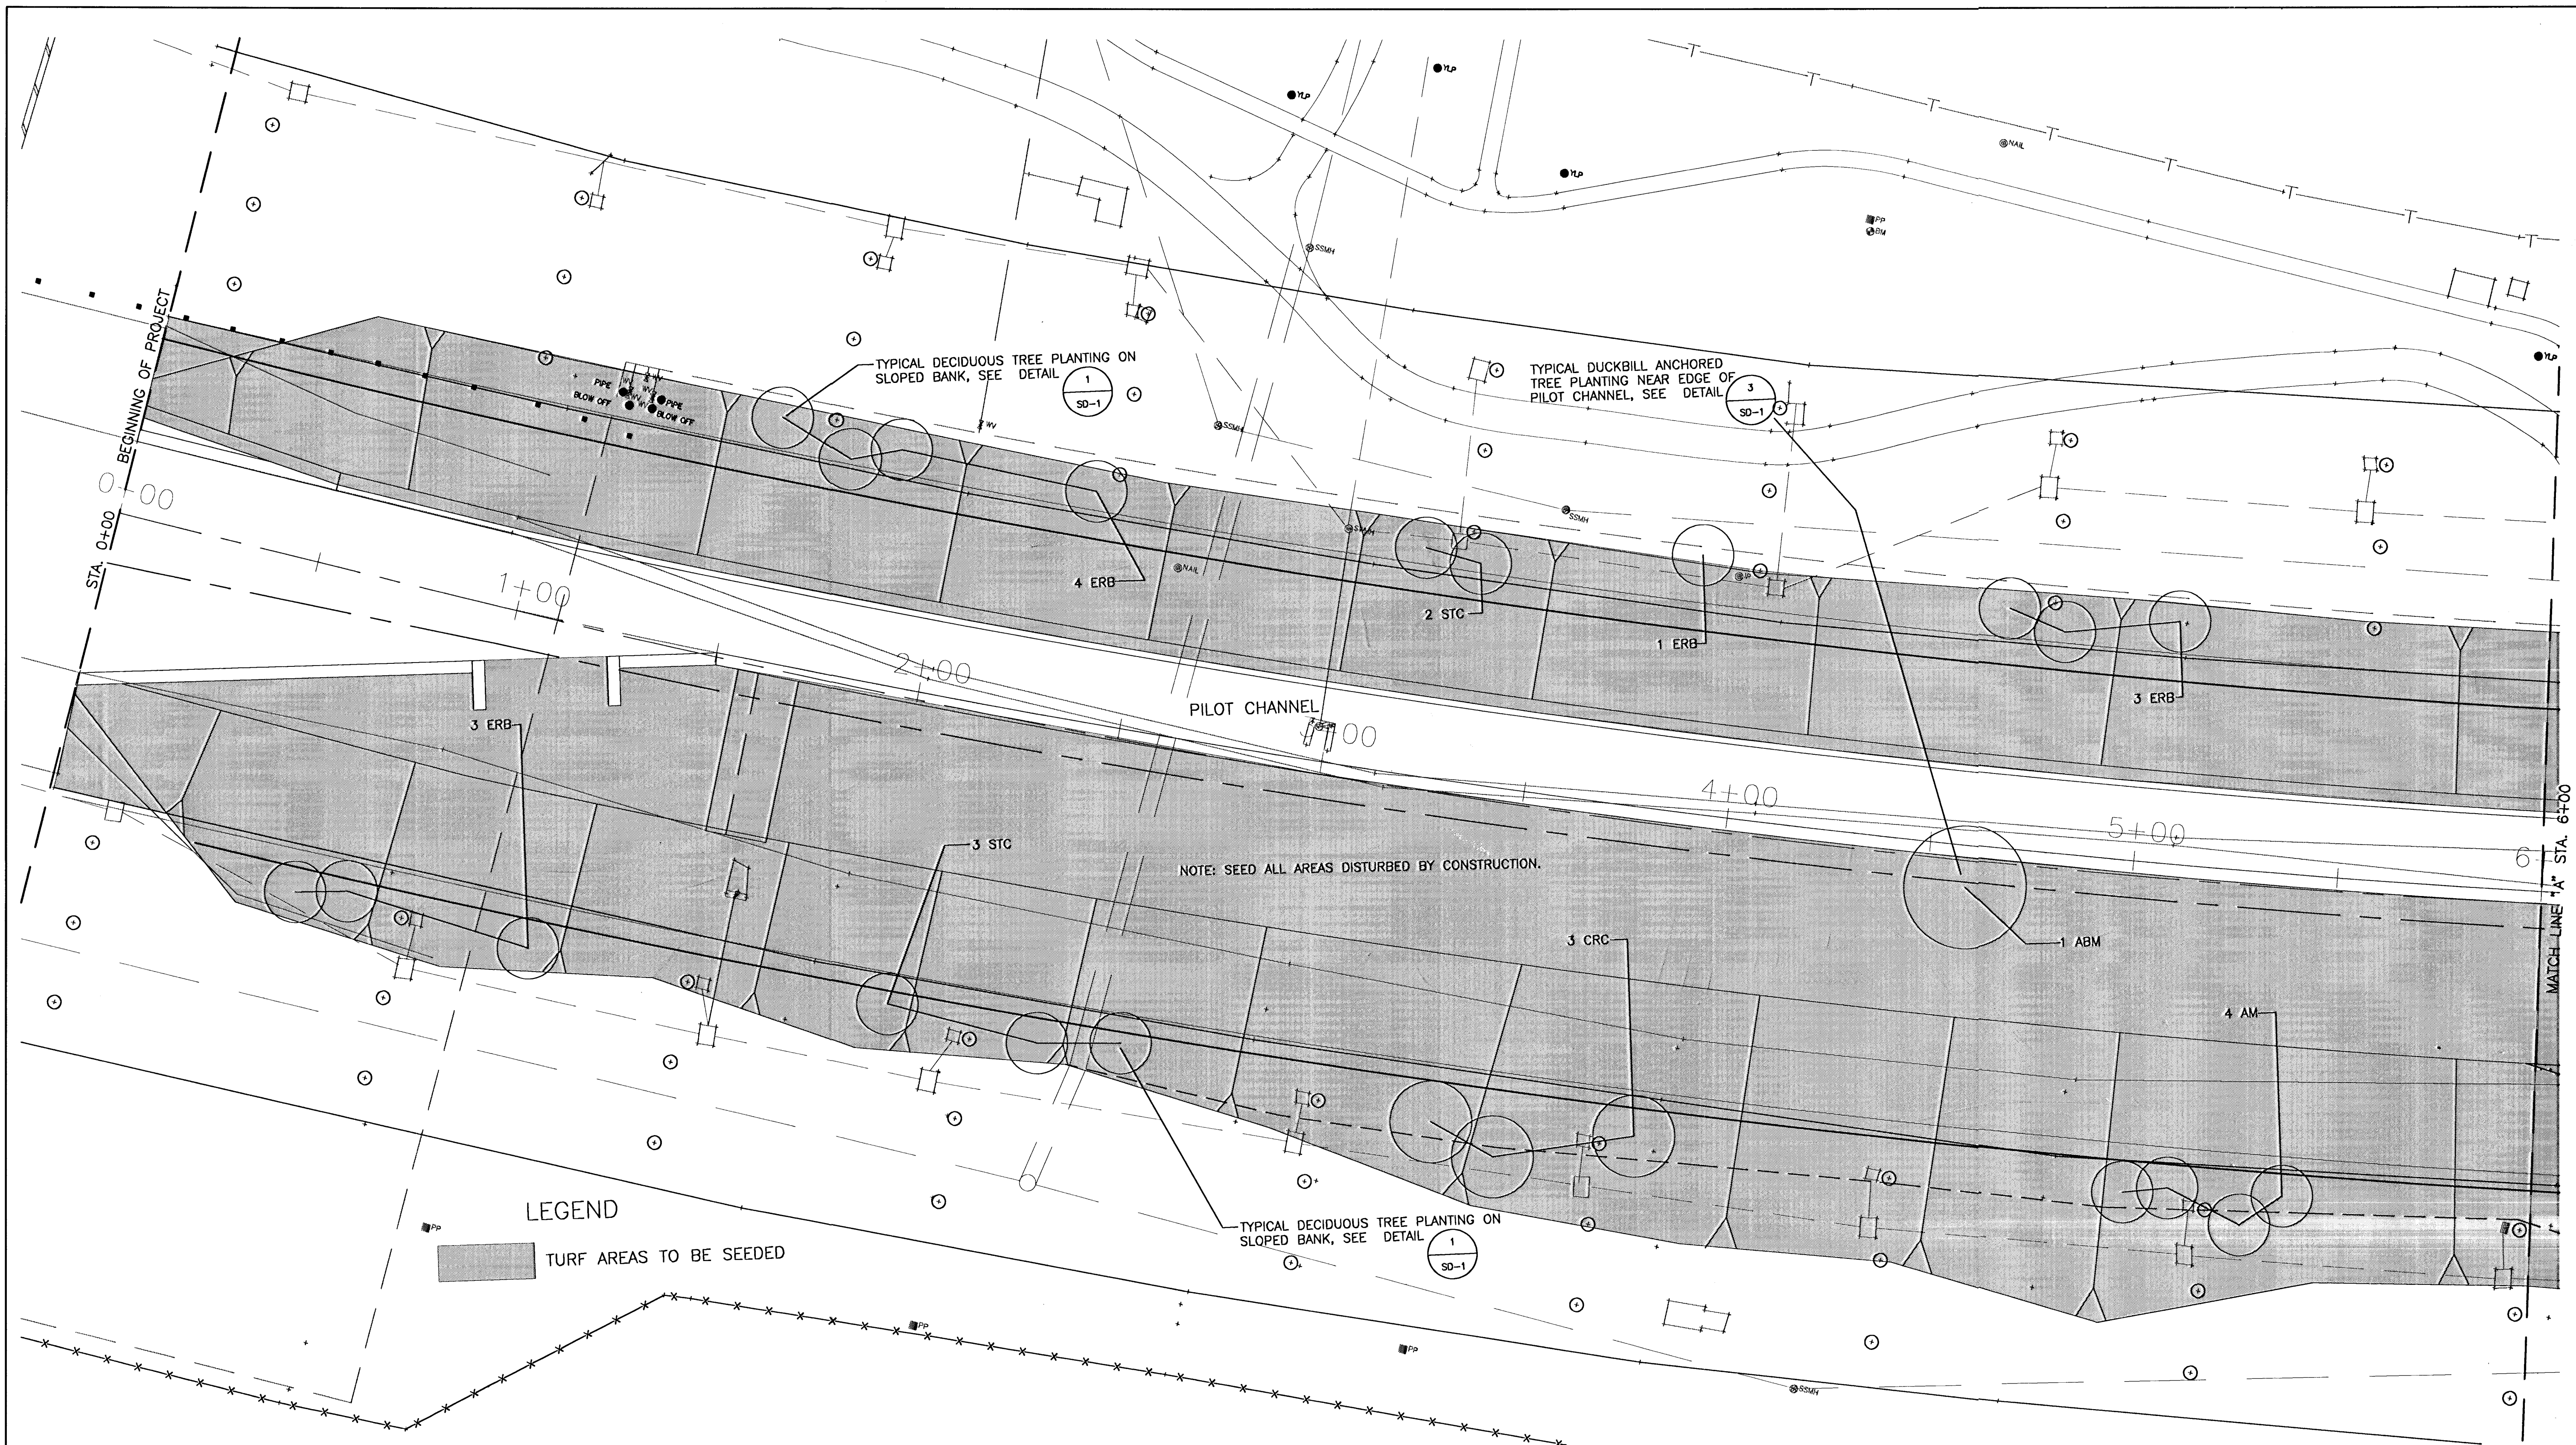

LEGEND

TURF AREAS TO BE SEED


TYPICAL DECIDUOUS TREE PLANTING ON SLOPED BANK, SEE DETAIL

TYPICAL DUCKBILL ANCHORED TREE PLANTING NEAR EDGE OF PILOT CHANNEL, SEE DETAIL


A
LP-1

CANAL ROUTE IMPROVEMENT LANDSCAPE PLAN NO. 1

0' 10' 20' 1"=20'-0"

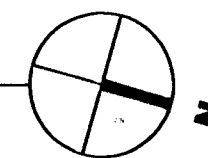

Not Built!

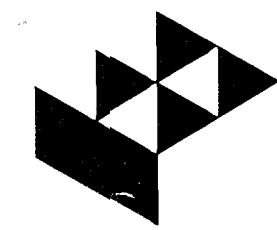

GossenLivingston

3					
2					
1					
NO.	DATE	REVISIONS	BY	APP'D	
CITY OF WICHITA					
LANDSCAPE PLAN					
LP-1					
SHEET NO.	OF	SCALE	APP'D		
DESIGNED		DETAILED	QUANTITIES	TRACED	
DESIGN CK.		DETAIL CK.	QUAN. CK.	TRACE CK.	