



PLAN : UPSTREAM
SCALE 1/4"=1'-0"

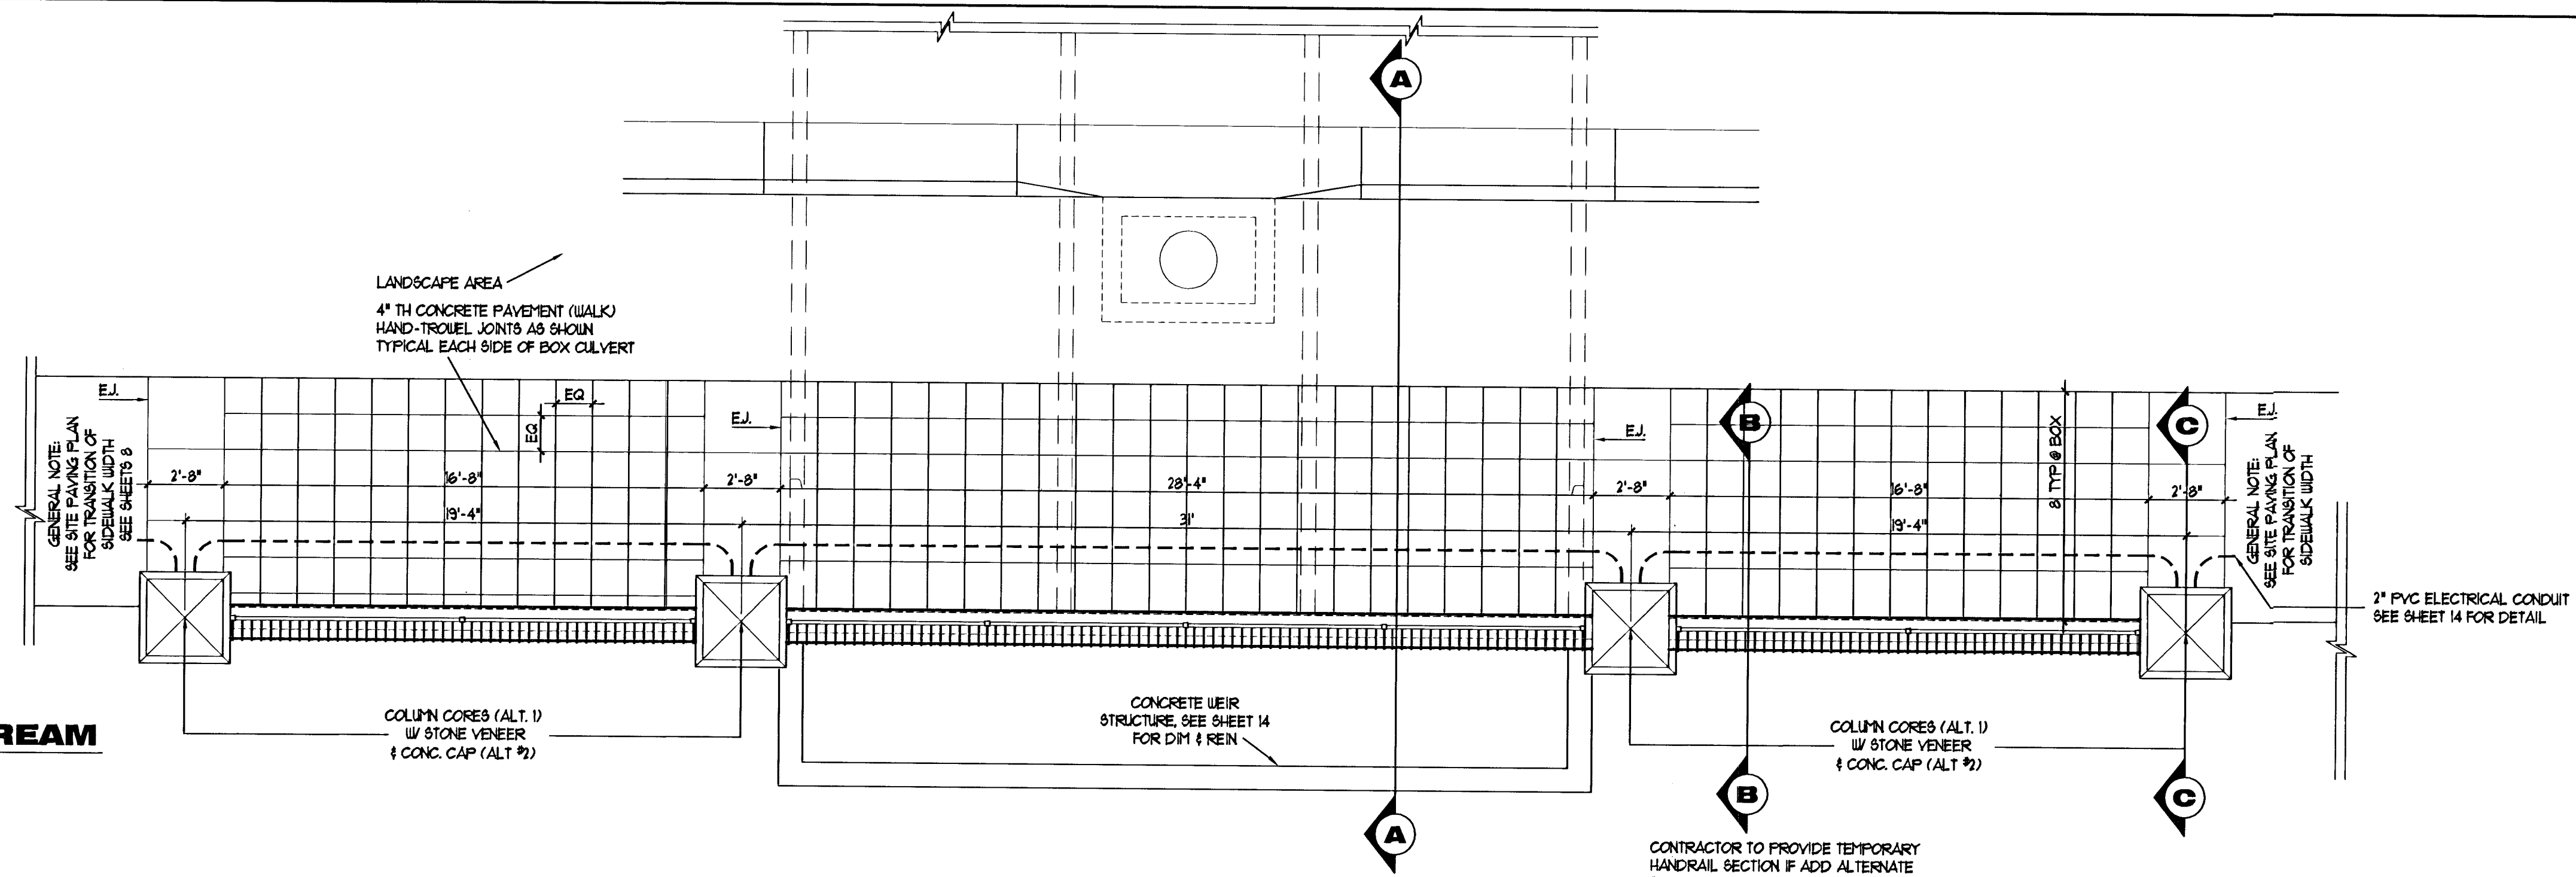


TOP OF CAST CAP ELEV = 1362.80
TOP OF HANDRAIL ELEV = 1359.51
TOP OF CORING ELEV = 1356.16
TOP FIN WALK ELEV = 1356.30
DRY STACK RETAINING WALLS
ADD ALTERNATE #3 SEE SHEET 6
NORMAL POOL ELEV = 1351.00
RCB FLOWLINE ELEV = 1350.00

ELEVATION - UPSTREAM
SCALE 1/4"=1'-0"

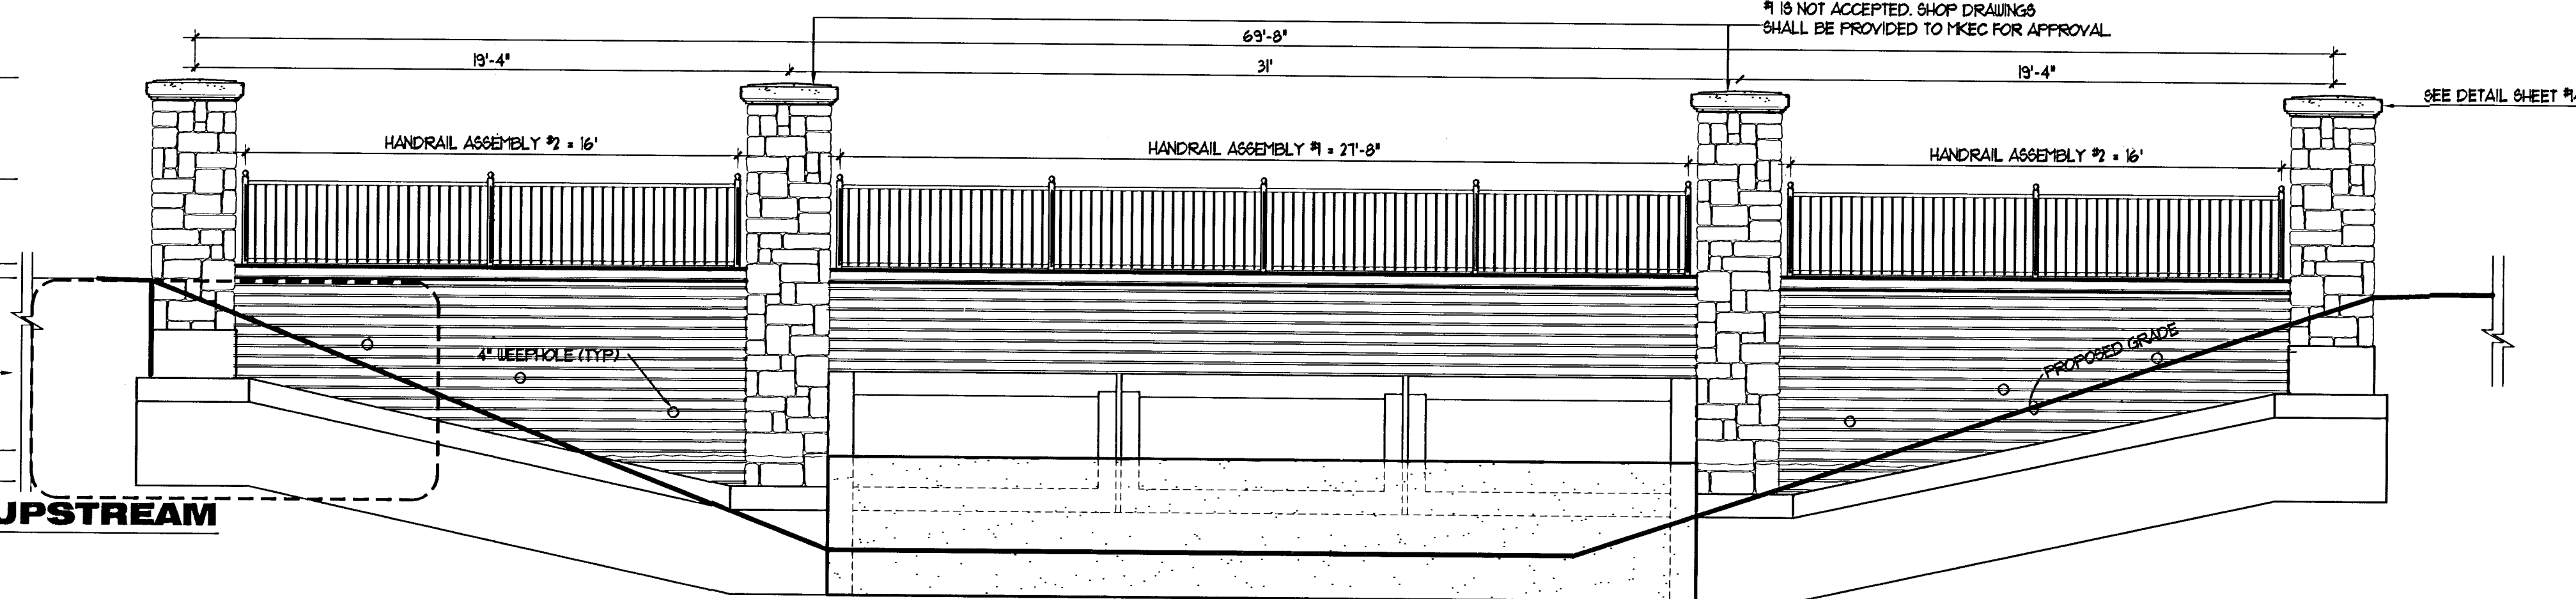




TOP OF CAST CAP ELEV = 1362.80
TOP OF HANDRAIL ELEV = 1359.51
TOP OF CORING ELEV = 1356.16
TOP FIN WALK ELEV = 1356.30
NORMAL POOL ELEV = 1343.50
RCB FLOWLINE ELEV = 1350.00

ELEVATION - DOWNSTREAM
SCALE 1/4"=1'-0"

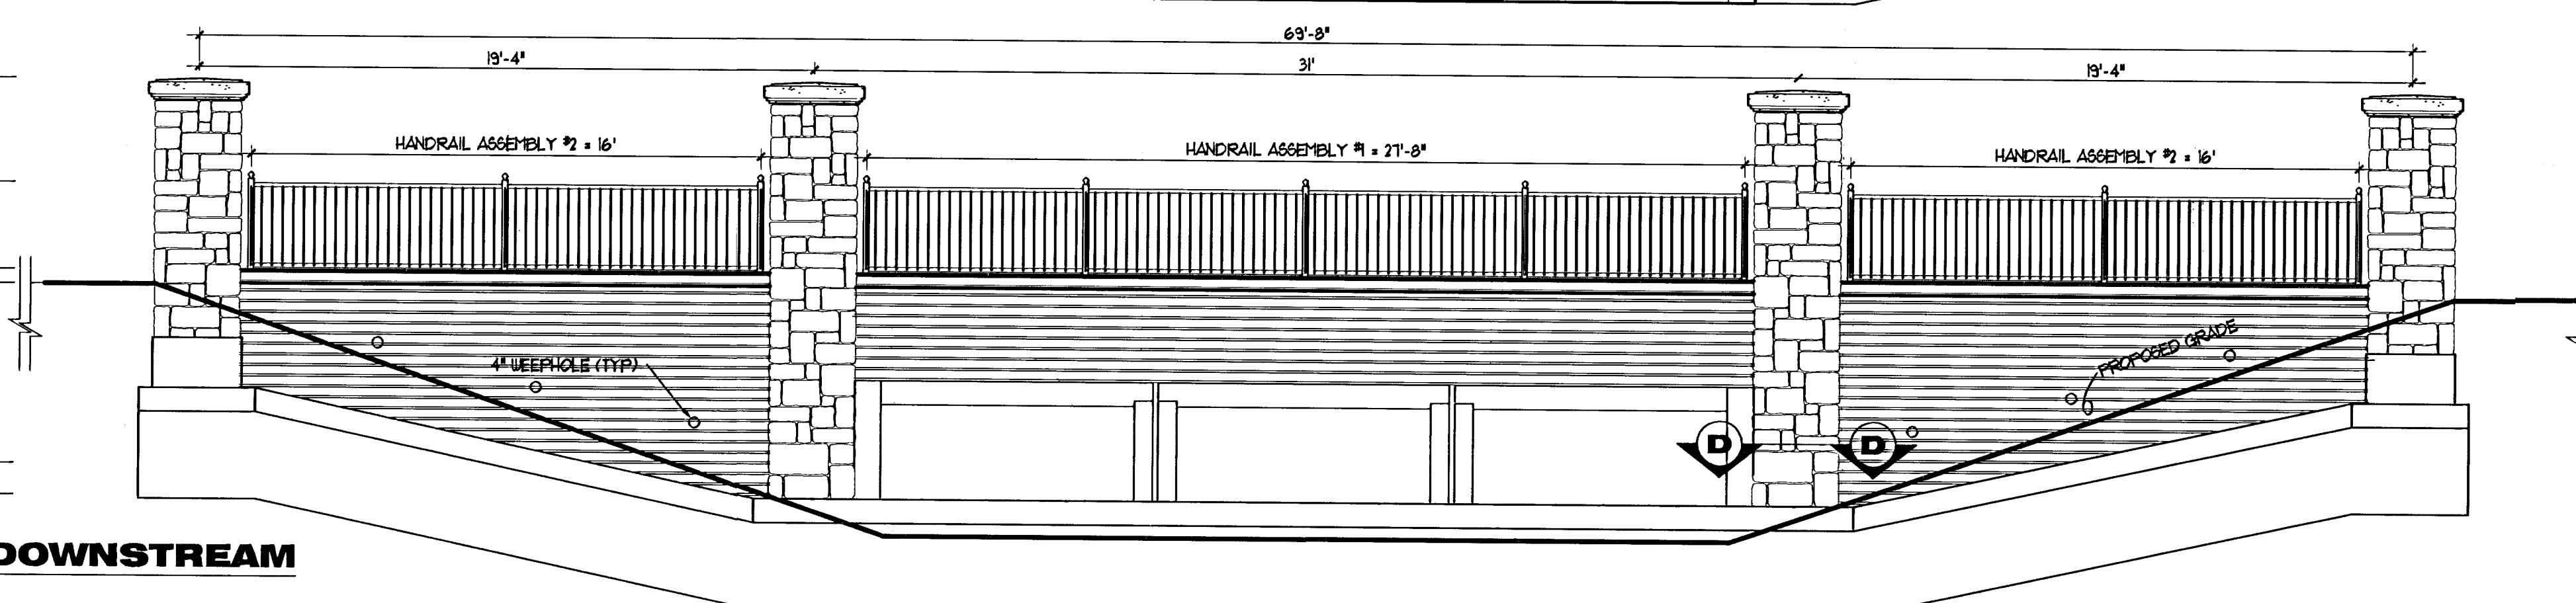

TOP OF CAST CAP ELEV = 1362.80
TOP OF HANDRAIL ELEV = 1359.51
TOP OF CORING ELEV = 1356.16
TOP FIN WALK ELEV = 1356.30

ELEVATION - ROADSIDE
SCALE 1/4"=1'-0"

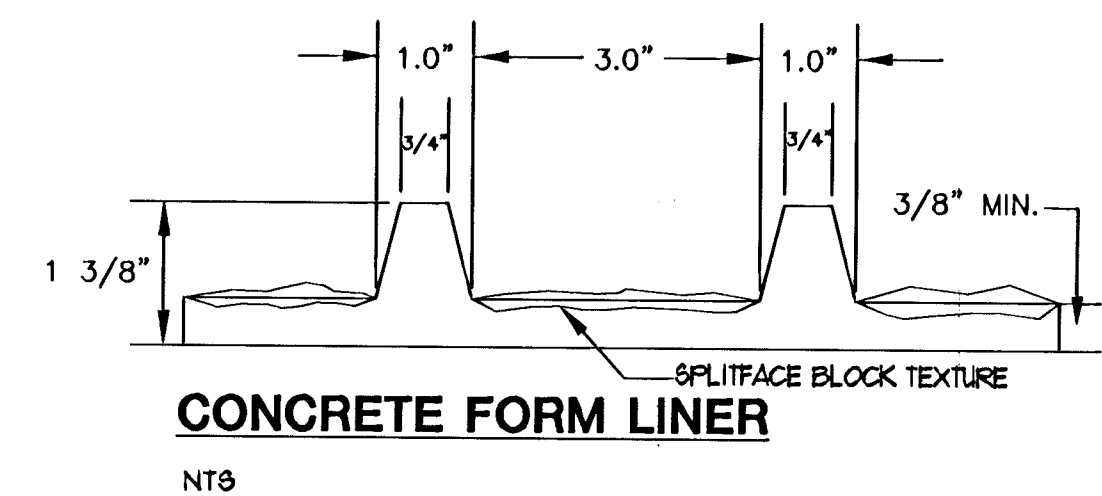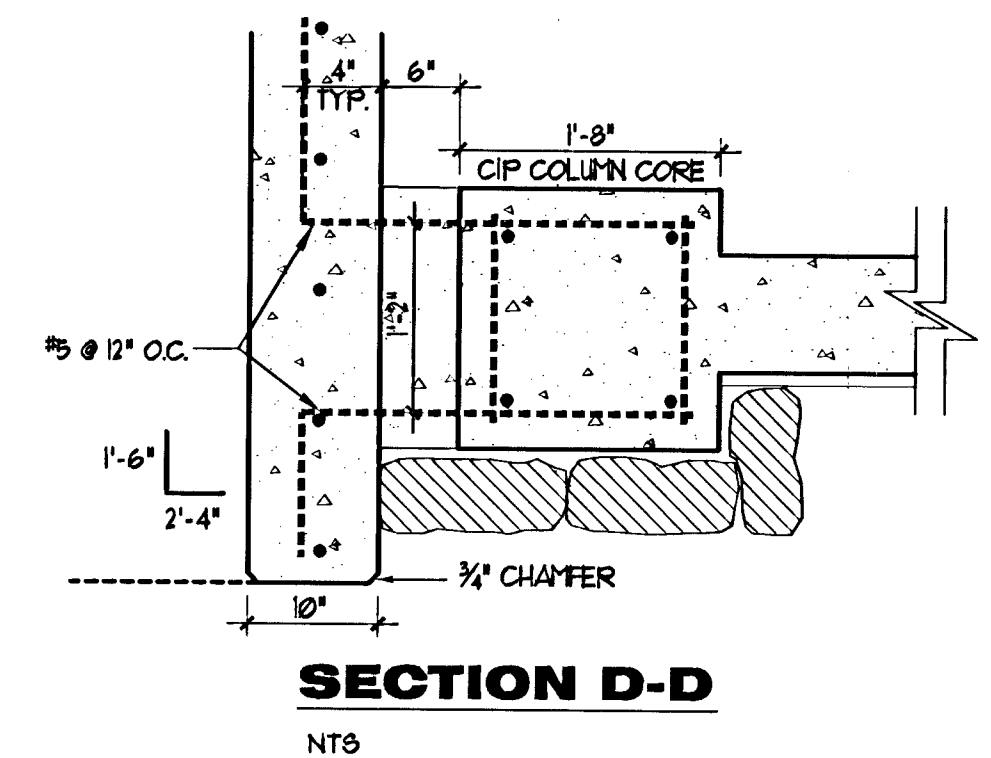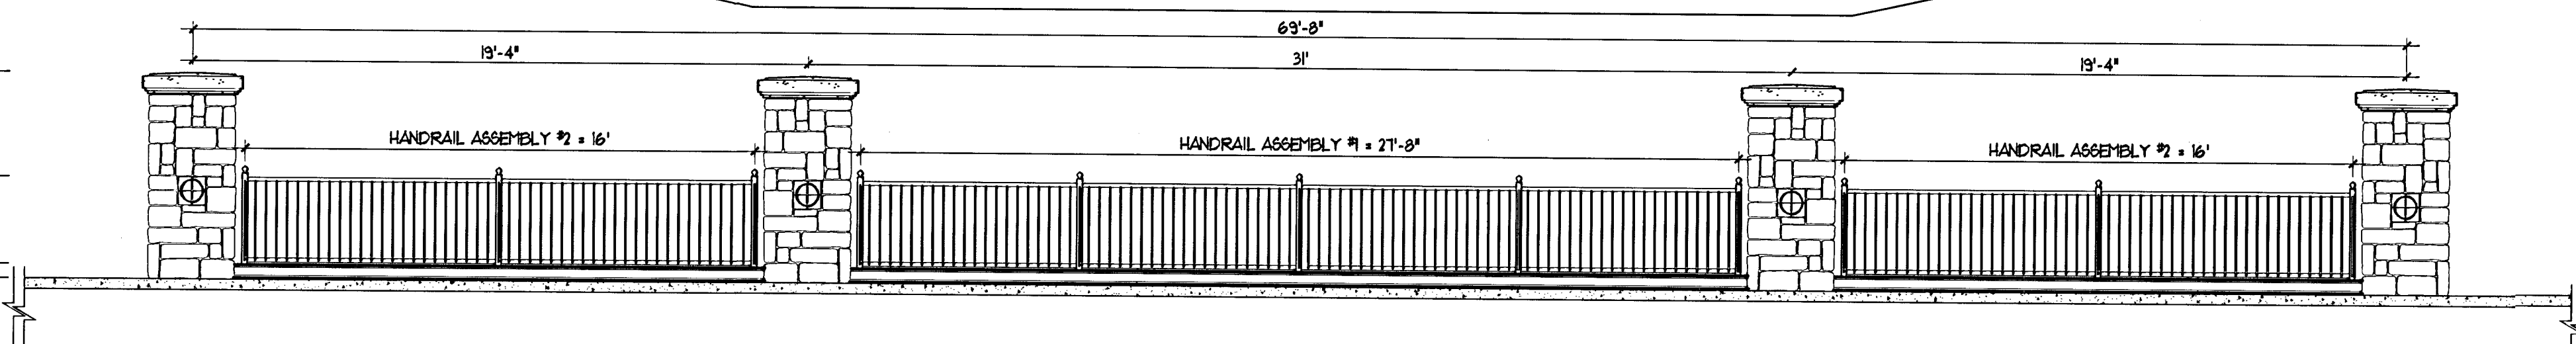

MKEC
ENGINEERING
CONSULTANTS
411 N. WEBB ROAD
WICHITA, KS. 67206
316-684-9600

HAWTHORNE ADDITION
PROJECT NAME
RCB
HEADWALL PLAN & ELEVATION
SHEET TITLE

MKEC
DESIGN BY: KK
DATE: APRIL, 2003

MKEC
DRAWN BY: KK
JOB NO.: 02167

MKEC
CHECKED BY: KK
SHEET/OF: 13 / 28