
SCALE: 1"=20'

WATER VALVE BOX ELEVATIONS			
STREET	STATION	OFFSET	PROPOSED ELEVATION
PALMETTO	60+54.06	23.0' Lt.	152.6
PALMETTO	60+57.06	26.0' Lt.	152.7

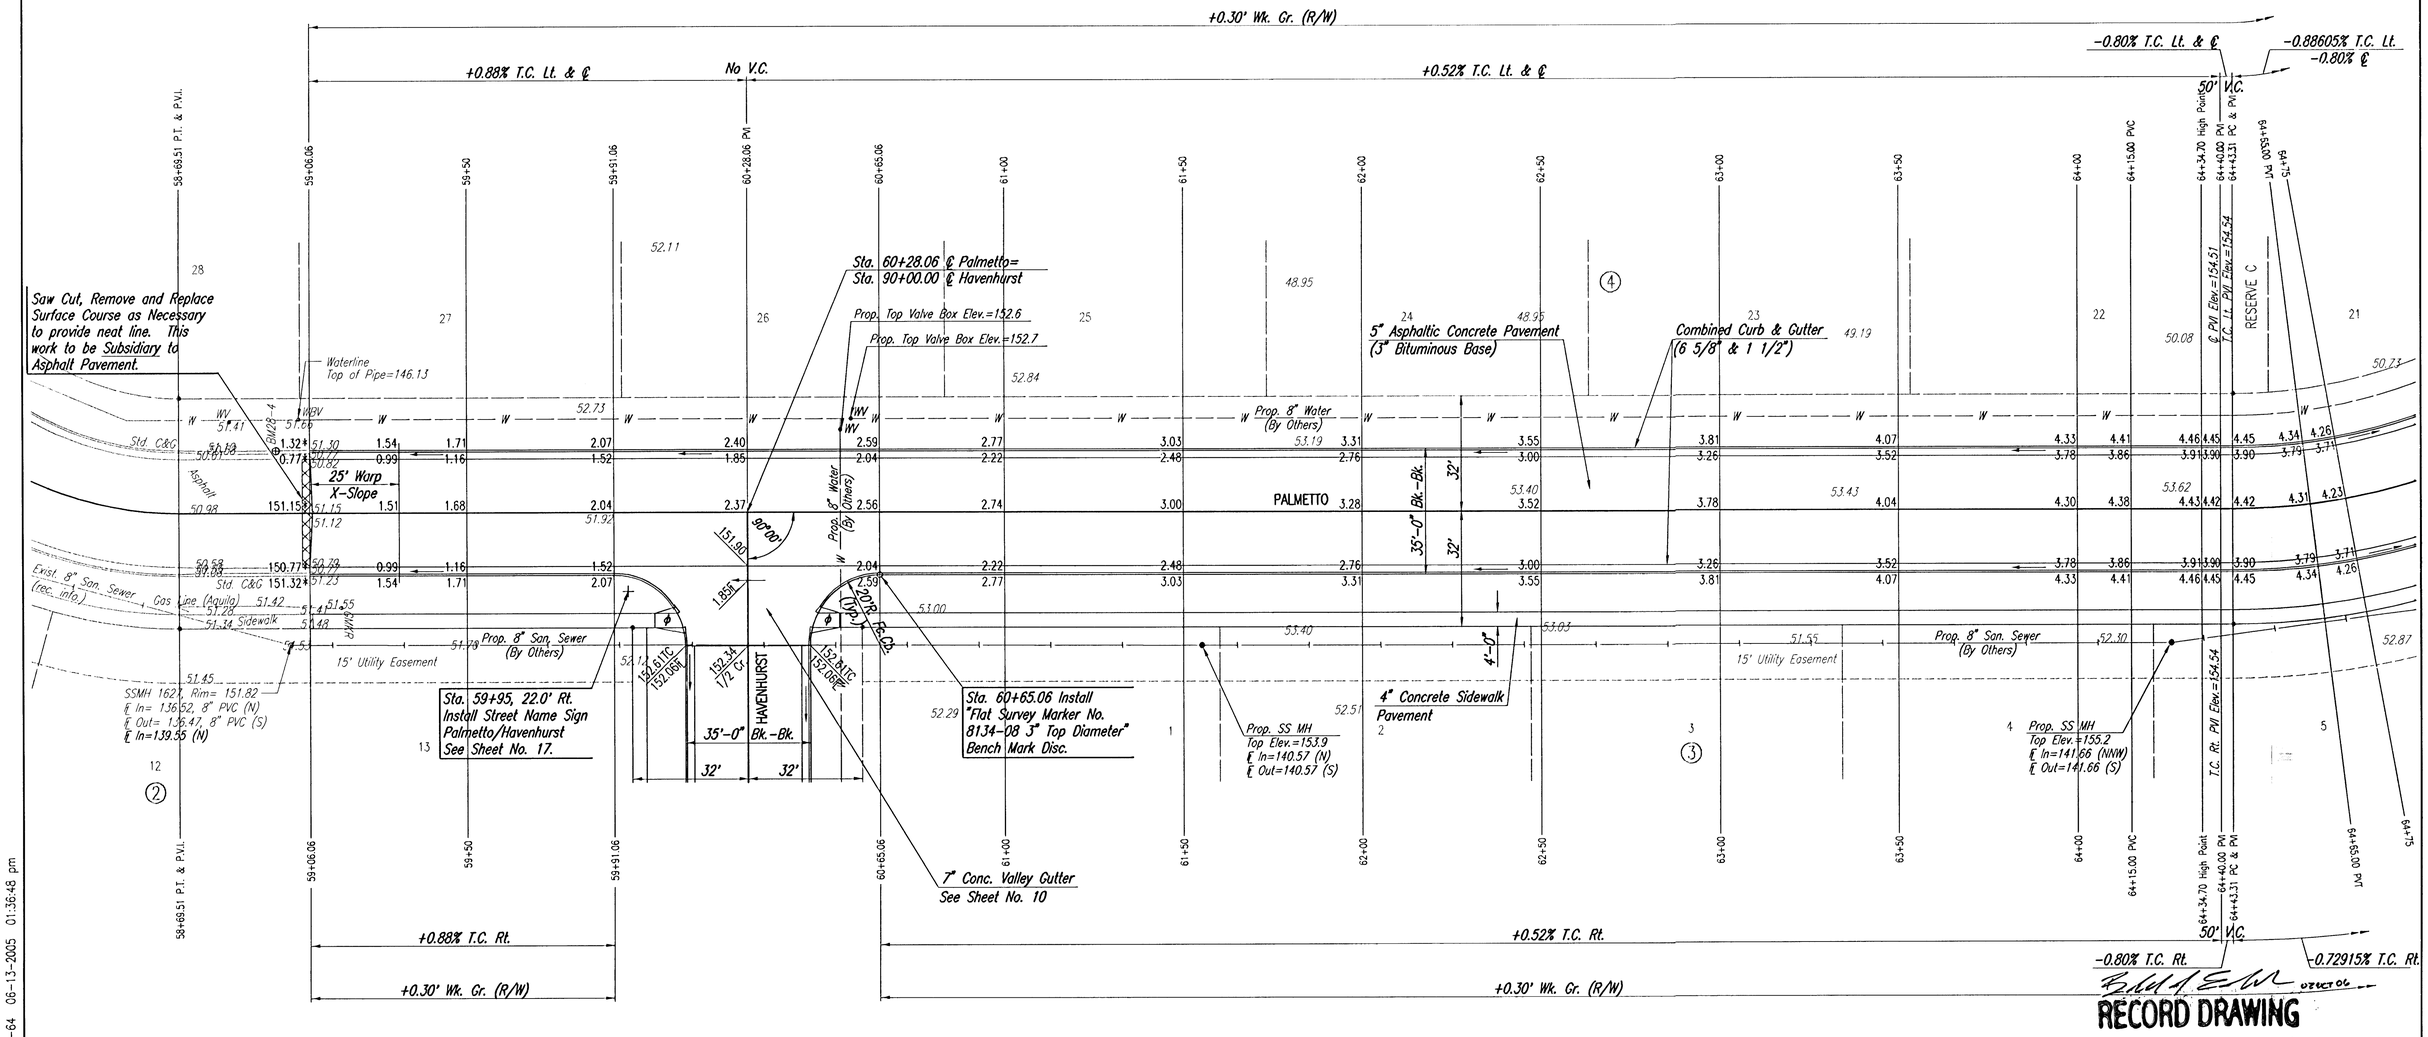

RECORD DRAWING

No.	Revision	By	Date

AVALON PARK-PHASE 4

PALMETTO

STA. 59+06.06 TO STA. 64+43.31

JAMES L. ARMOUR, P.E.-CITY ENGINEER
CITY OF WICHITA PROJECT NO. 472-83838

Professional Engineering Consultants, P.A.
303 S. TOPEKA • WICHITA, KANSAS 67202
316-262-2691 • FAX 316-262-3003

BRIAN D. BOUTWELL LICENSED PROFESSIONAL ENGINEER 10889 — 6-15-05

Designed by	BDB, BLB	Job No.	35-05059-000	SN. 7 of 22
Drawn by	BJS	Date	February 2005	

DSNR: BLB OPER: BJS SCALE: 1=20.00
Q:\2005\05059\000\05059-000-C-STR59-64 06-13-2005 01:36:48 pm