




COMPACTED FILL DETAIL
WHERE SIDEWALK IS CONSTRUCTED
(See Plan Sheets for Locations)

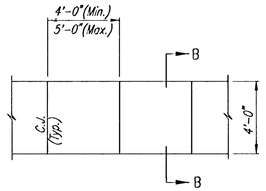


PLAN

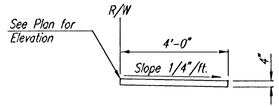

SECTION B-B

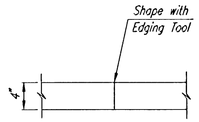


CONSTRUCTION JOINT
(ALT. C.J.)

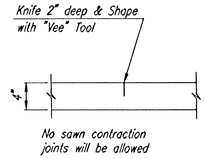


CONTRACTION JOINT
(C.J.)

4" WALK DETAILS

W= 4'0" FOR STANDARD RAMP
W= 5'0" FOR RAMPS AT SCHOOL CROSSWALKS
(OR TO MATCH EXISTING)

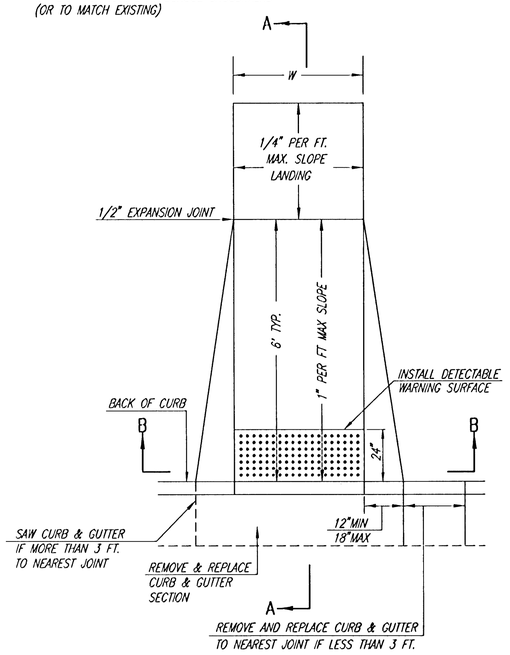


(TYPE A)
STANDARD WHEELCHAIR RAMP
WITH DETECTABLE WARNING
CONSTRUCTION DETAIL FOR STREETS
WITH COMBINED CURB & GUTTER

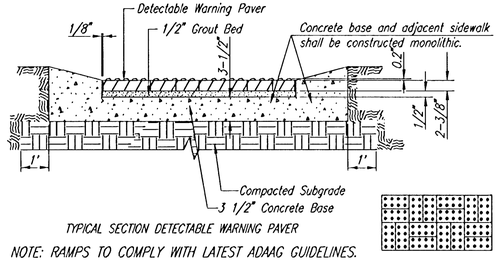


TYPICAL SECTION DETECTABLE WARNING PAVER

NOTE: RAMPS TO COMPLY WITH LATEST ADAAG GUIDELINES. PAVESTONE DETECTABLE WARNING PAVERS (OR AN APPROVED EQUAL) SHALL BE USED IN ALL WHEELCHAIR RAMPS. THE RED PAVER SHALL BE INSTALLED USING A BASKET WEAVE/PARQUET PATTERN. OTHER PATTERNS MAY BE USED WITH APPROVAL OF ENGINEER. SAND FILL JOINTS. ALIGN DOMES IN THE DIRECTION OF PEDESTRIAN TRAVEL.

SECTION B-B

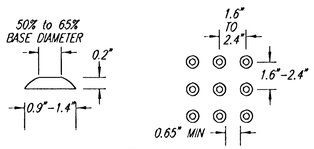

DOME DETAIL

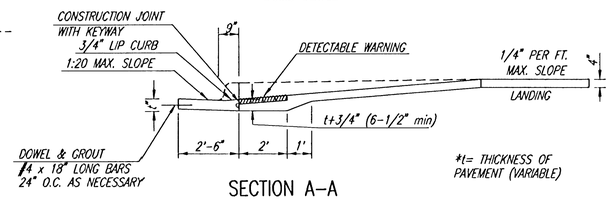


#t= THICKNESS OF PAVEMENT (VARIABLE)

SECTION A-A

AUGUST 4, 2003

TYPICAL WHEELCHAIR RAMP DETAILS

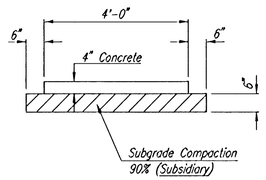

TYPICAL SIDEWALK SECTION

02 OCT 06
RECORD DRAWING

BRIAN D. BOUTWELL LICENSED 10889 PROFESSIONAL ENGINEER
10-15-05

No.	Revision	By	Date

AVALON PARK-PHASE 4

MISCELLANEOUS PAVING DETAILS

JAMES L. ARMOUR, P.E.-CITY ENGINEER
CITY OF WICHITA PROJECT NO. 472-83838

Professional Engineering Consultants, P.A.
303 S. TOPEKA • WICHITA, KANSAS 67202
316-262-2691 • FAX 316-262-3003

Designed by	BDB, BLB	Job No.	35-05059-000	Sht. 11 of 22
Drawn by	BJS	Date	February 2005	

DSNR: BLB OPER: BJS SCALE: 1=10.00
Q:\2005\05059\000\05059-000-C-MISCDTL1 06-13-2005 01:45:58 pm